


DATE	
BY	
PROFILE	
NO.	
NOTE BOOK	
NO.	
DATE	
BY	
PROJECT	
NO.	

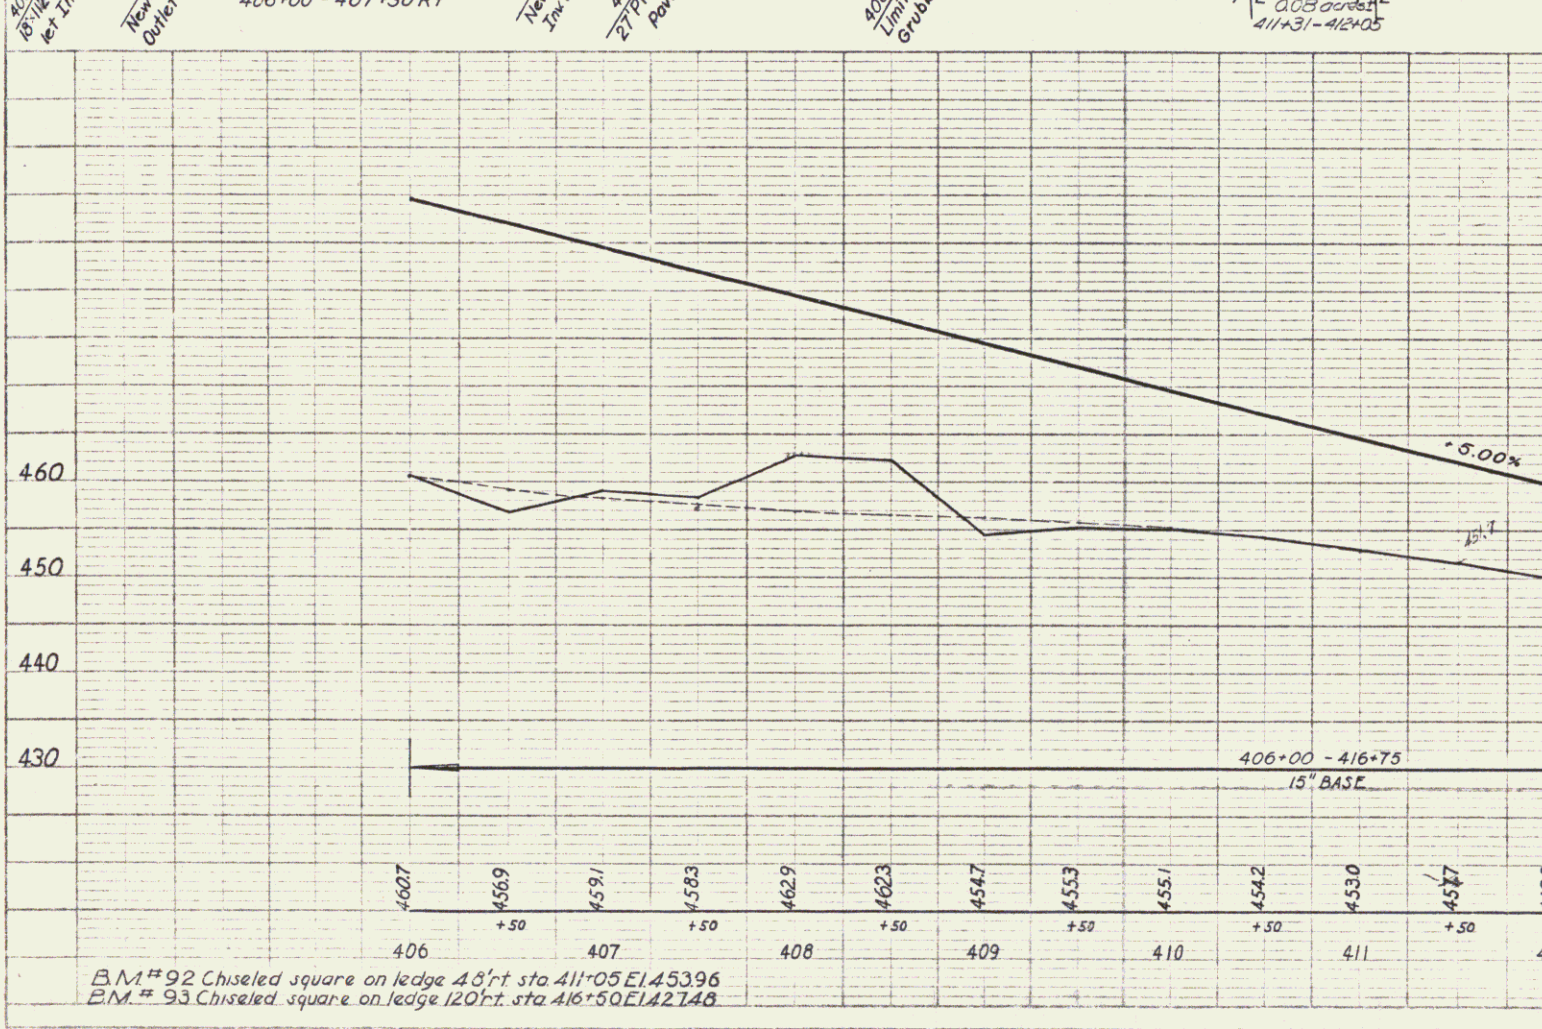

18" V.L. / 1" H.L.  
 New Outlets  
 400' Limb Grubb  
 27' P. Pos.  
 408' 00" 411+31 - 412+05