


INDEX OF SHEETS

SHEET NO.	TITLE PAGE
2-2-A	TYPICAL CROSS SECTION OF IMPROVEMENT
4	QUANTITY SHEET (ITEMS)
4-5	QUANTITY SHEETS (DRAINAGE)
4-7	EMBANKMENT SHEETS
4-18	PLAN AND PROFILE SHEETS
10	STANDARD STRUCTURE SHEET CO (DRAINAGE AND MARKERS)
20	STANDARD STRUCTURE SHEET CO-2 (TYPICAL GRADE)
21	STANDARD STRUCTURE SHEET CO-4 (GRAVITE CURB)
22	STANDARD STRUCTURE SHEET S-40 (BARRICADES SIGNS AND LIGHTS)
23	STANDARD STRUCTURE SHEET S-44-45 (CATCH BASINS OR MANHOLES)
24	STANDARD STRUCTURE SHEET S-47-48 (DRAIN INLETS)
25-41	CROSS SECTIONS
(14-41) (14-43) (14-45)	

STANDARD STRUCTURE SHEET APPROVED BY THE CHIEF ENGINEER, VERMONT STATE DEPARTMENT OF HIGHWAYS
S-40 JUNE 10, 1930


STATE OF VERMONT
DEPARTMENT OF HIGHWAYS
PROPOSED IMPROVEMENT
URBAN INTERSTATE PROJECT
TOWN OF BRATTLEBORO
COUNTY OF WINDHAM
U.S. ROUTE 5
BRATTLEBORO-GUILFORD ROAD

PROJECT NAME & NUMBER	TYPE	PAVEMENT AREA
BRATTLEBORO UI 59(5)	BIT.CONC.PAV.	18545 S.Y.
RECORD PLANS		
MATERIALS		
REINFORCING STEEL - VT. STRUCT. STEEL BURLINGTON	ASPHALT LAKE ASPHALT CO. GREENFIELD, MASS.	
SUB-BASE OF GRAVEL - EVANS PIT, VERNON, VT.	ACCGMP BAKER MLY. PIPE CO. WESTMINSTER, VT.	
CRUSHED GRAVEL BASE - BRATTLEBORO SAND & GRAVEL CO.	RCF - V.L. 2013. PIPE CO. WINDSOR, VT.	
PLANT MIX COURSE LAKE ASPHALT CO. GREENFIELD	GRANITE CURB FLETCHER, CHELMSFORD, MASS.	
BIT. CONC. PAVEMENT LAKE ASPHALT CO. GREENFIELD	CEMENT LUMP STAS., SHEN FALLS, N.Y.	
AGG-BIT. CONC. LAKE ASPHALT CO. GREENFIELD MASS.	AGG-CONC. BRATTLEBORO SAND & GRAVEL CO.	
CONTRACTOR - KELLEHER, JOHN TURNER'S FALLS, N.H.	CONTRACT DATED - JUNE 30, 1953	
RES. ENGINEER - THOMAS L. DUDLEY	CONTRACT STARTED - JULY 5, 1953	
INSPECTOR - FRANK ALDRICH	CONTRACT COMPLETED - NOV. 4, 1953	
RECORD PLANS BY T.L. DUDLEY & S.E. HOPKINS	CONTRACT ACCEPTED - NOV. 4, 1953	

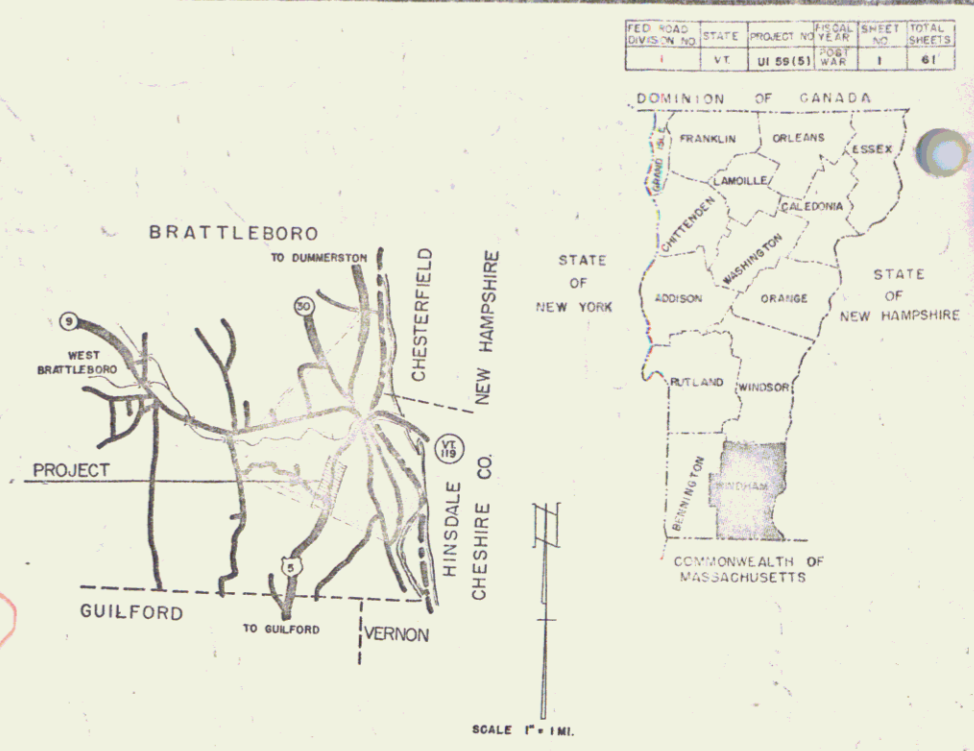

(To Be Returned To R.O.W. Division)
TOWN OF U.S.
PERPETUAL
TOWN FILE
RIGHT-OF-WAY DIVISION

RIGHT-OF-WAY DIVISION
TOWN FILE
PERPETUAL
Town of U.S.
(To Be Returned To R.O.W. Division)

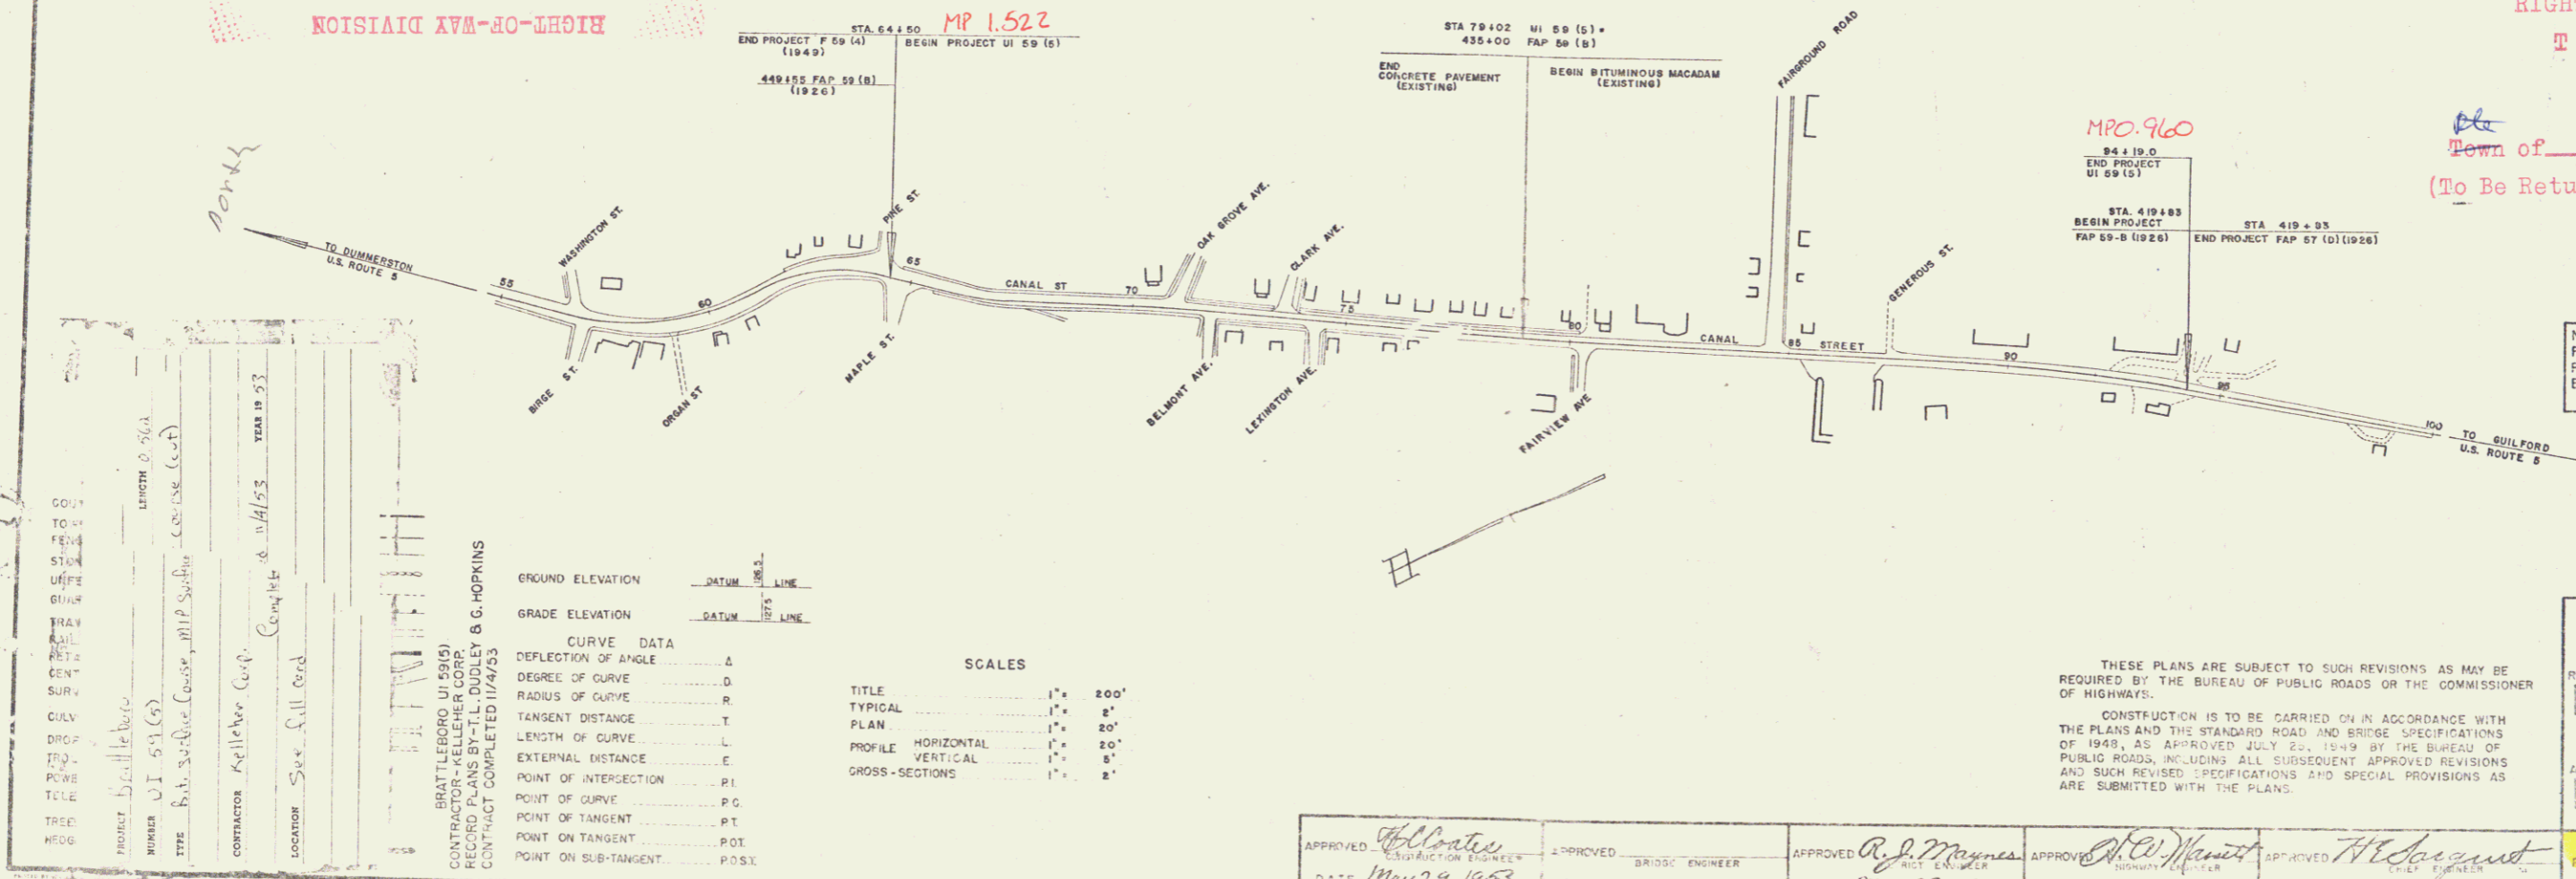

NOTE: ANY FURTHER INFORMATION CONCERNING FINAL QUANTITIES, AMOUNTS OR OTHER DETAILS RELATIVE TO THIS PROJECT MAY BE FOUND IN EITHER THE FIELD BOOKS OR THE ESTIMATE FILE.

THESE PLANS ARE SUBJECT TO SUCH REVISIONS AS MAY BE REQUIRED BY THE BUREAU OF PUBLIC ROADS OR THE COMMISSIONER OF HIGHWAYS.
CONSTRUCTION IS TO BE CARRIED ON IN ACCORDANCE WITH THE PLANS AND THE STANDARD ROAD AND BRIDGE SPECIFICATIONS OF 1949, AS APPROVED JULY 24, 1949 BY THE BUREAU OF PUBLIC ROADS, INCLUDING ALL SUBSEQUENT APPROVED REVISIONS AND SUCH REVISED SPECIFICATIONS AND SPECIAL PROVISIONS AS ARE SUBMITTED WITH THE PLANS.

DEPARTMENT OF COMMERCE
BUREAU OF PUBLIC ROADS

RECOMMENDED FOR APPROVAL

DIST. OF ENGINEER

APPROVED

DIVISION ENGINEER

DATE

PROJECT UI NO. 59 (5)

SHEET 1 OF 61 SHEETS

APPROVED *[Signature]* DISTRICT ENGINEER DATE May 29, 1953

APPROVED *[Signature]* BRIDGE ENGINEER DATE

APPROVED *[Signature]* DIST. ENGR. DATE May 28, 1953

APPROVED *[Signature]* DIST. ENGR. DATE MAY 25 1953

APPROVED *[Signature]* DIST. ENGR. DATE MAY 28 1953

001912
7/16/53
T.M.P.

Pin # 99R242