



9/22/52
 11/15/52
 2/10/53
 5/10/53

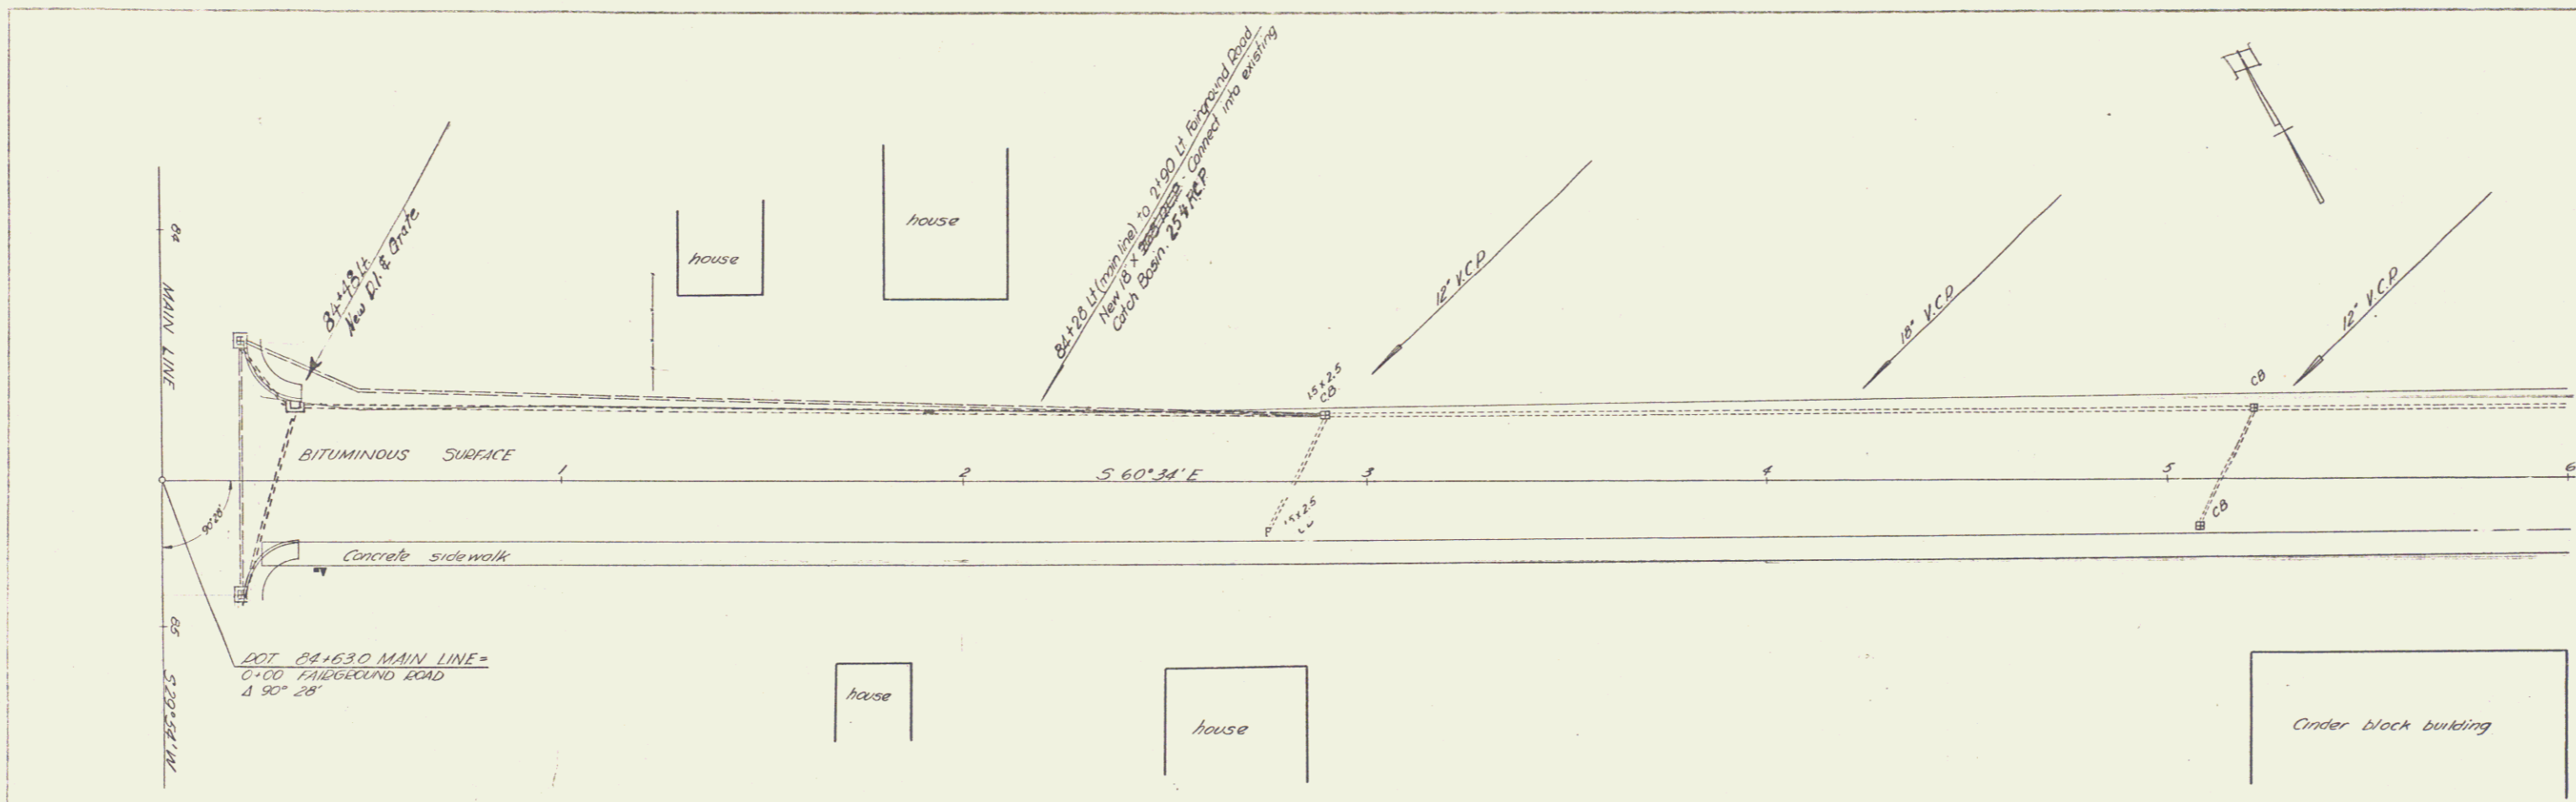

9/22/52
 11/15/52
 2/10/53
 5/10/53

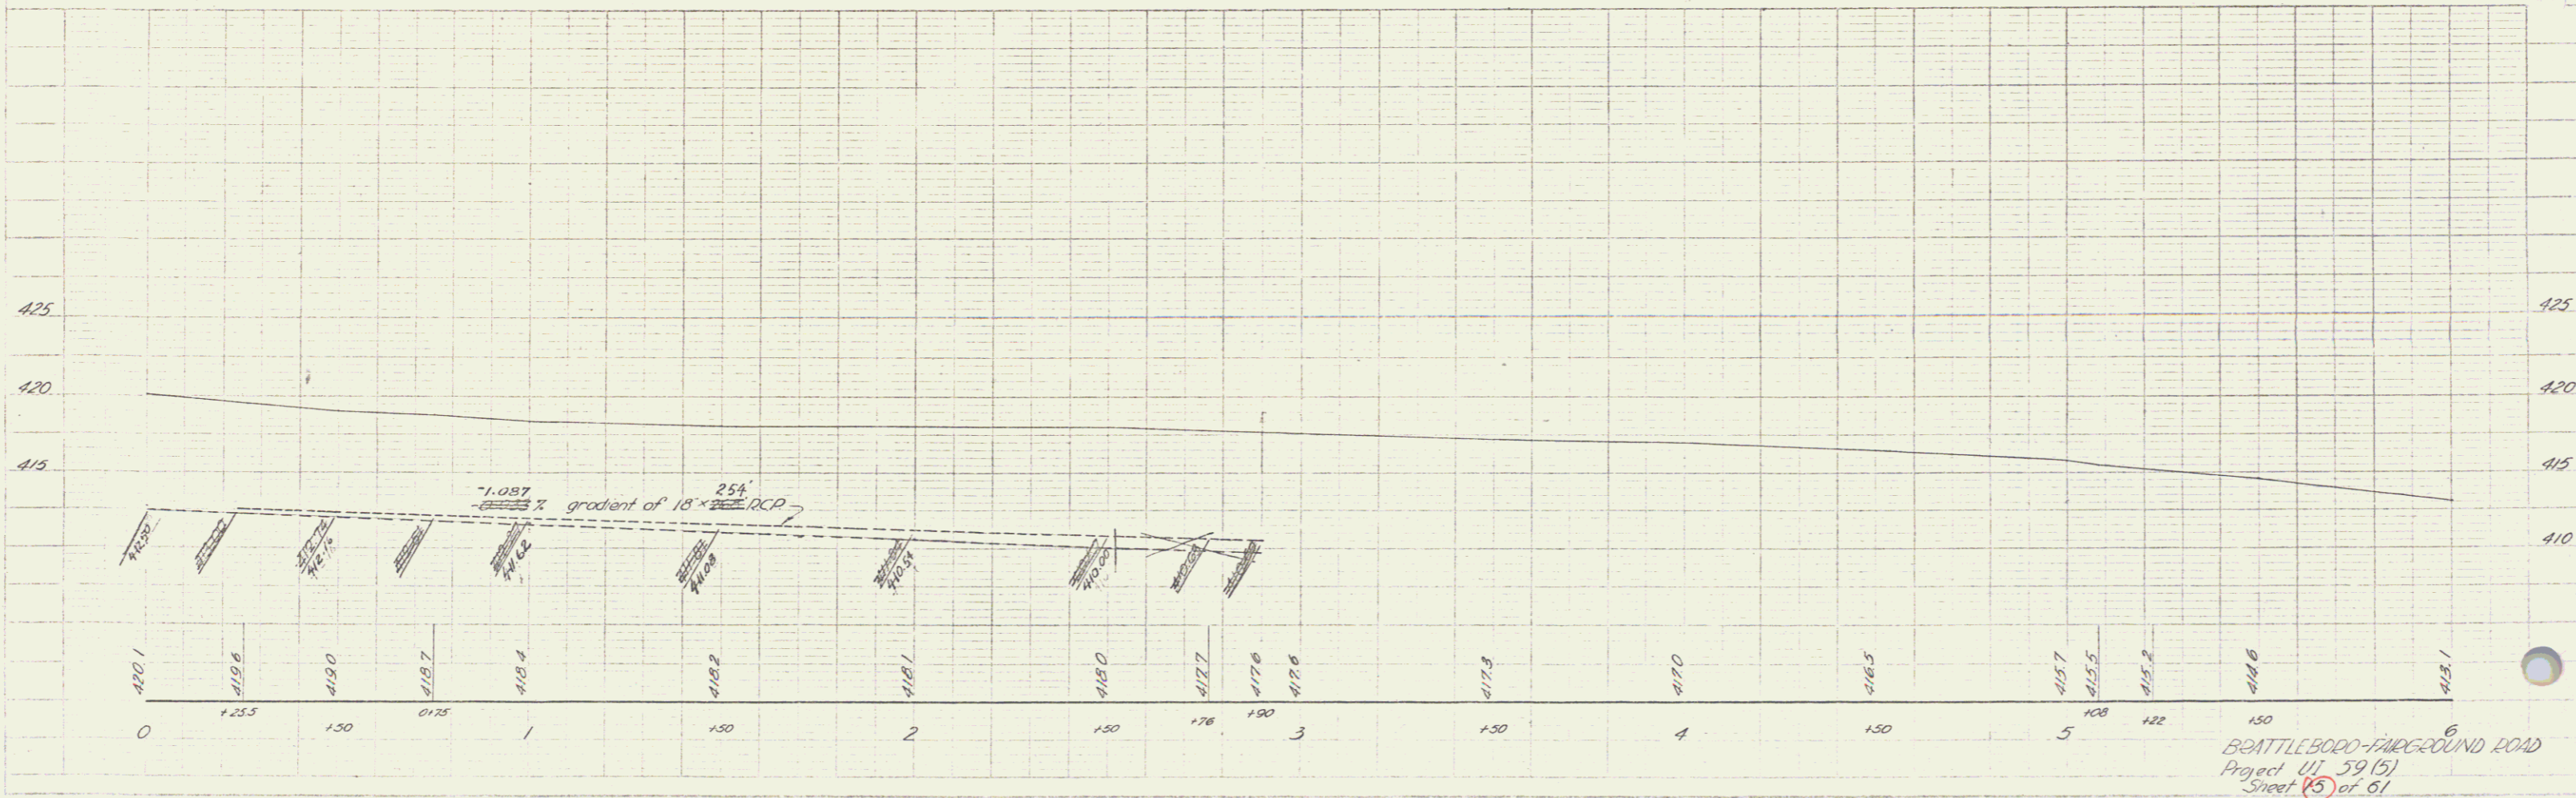

BEATTLEBORO-FAIRGROUND ROAD
 Project U1 59 (5)
 Sheet 65 of 61

9