


Construct Satisfactory Approach

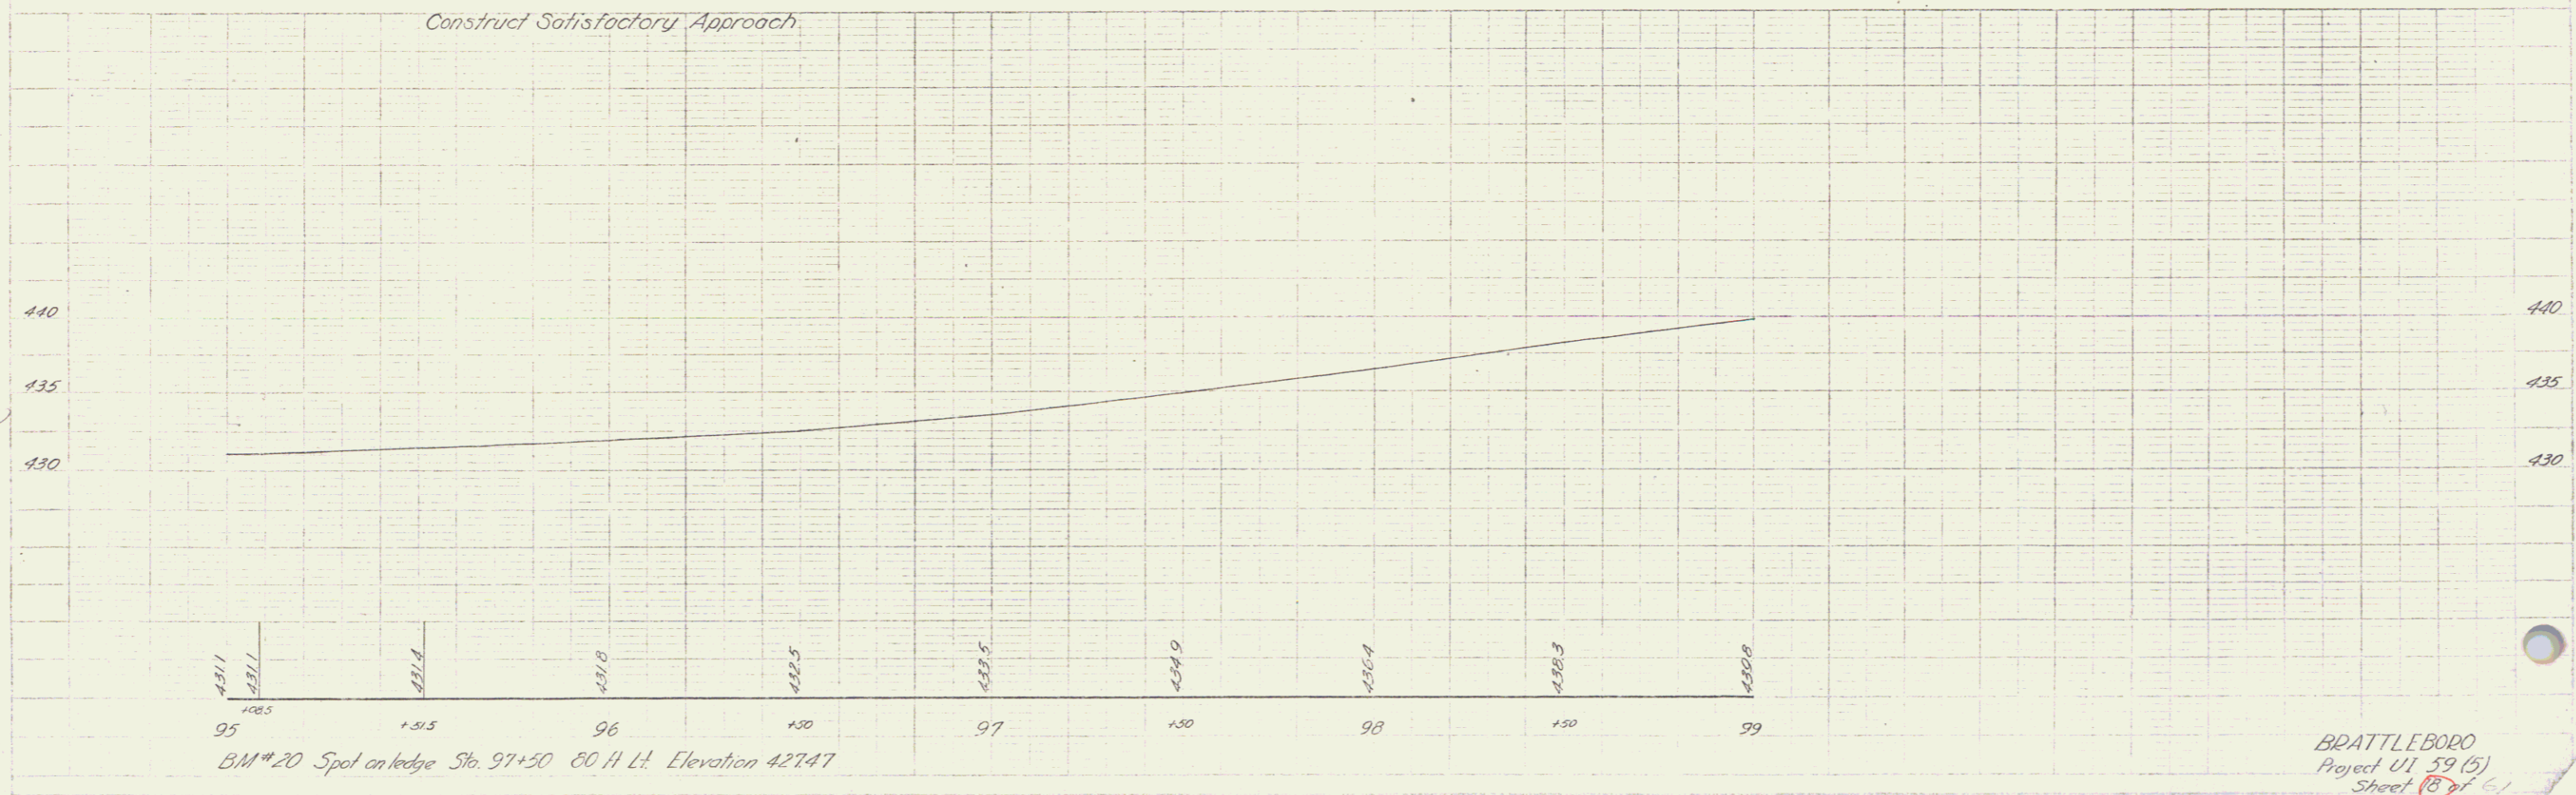

BRATTLEBORO
Project U1 59 (5)
Sheet 6 of 61