



PLAN
 SHEET NO. 10
 DATE 10/27/47
 DRAWN BY [unclear]
 CHECKED BY [unclear]

PLAN
 SHEET NO. 10
 DATE 10/27/47
 DRAWN BY [unclear]
 CHECKED BY [unclear]

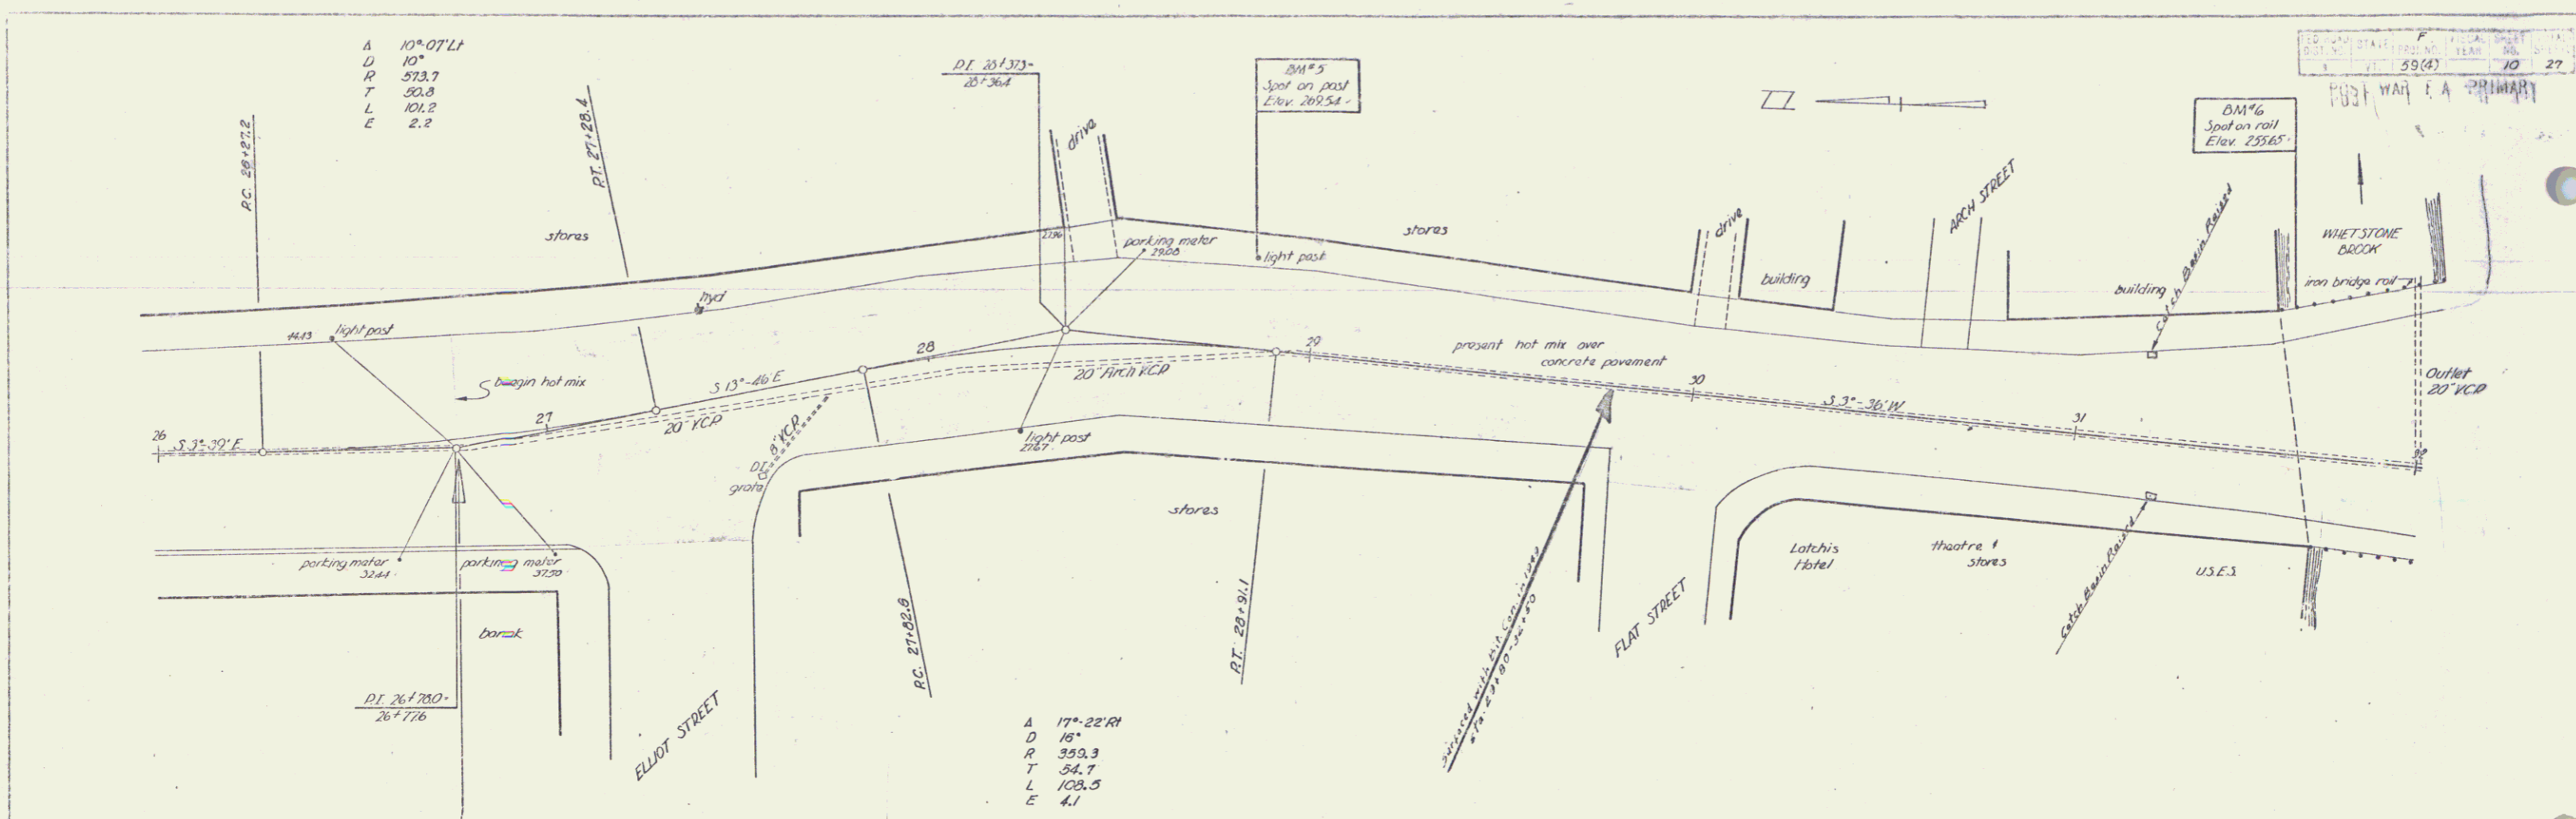

A 10° 07' L
 D 10"
 R 593.7
 T 52.9
 L 101.2
 E 2.2

A 17° 22' R
 D 16"
 R 359.3
 T 54.7
 L 108.5
 E 4.1

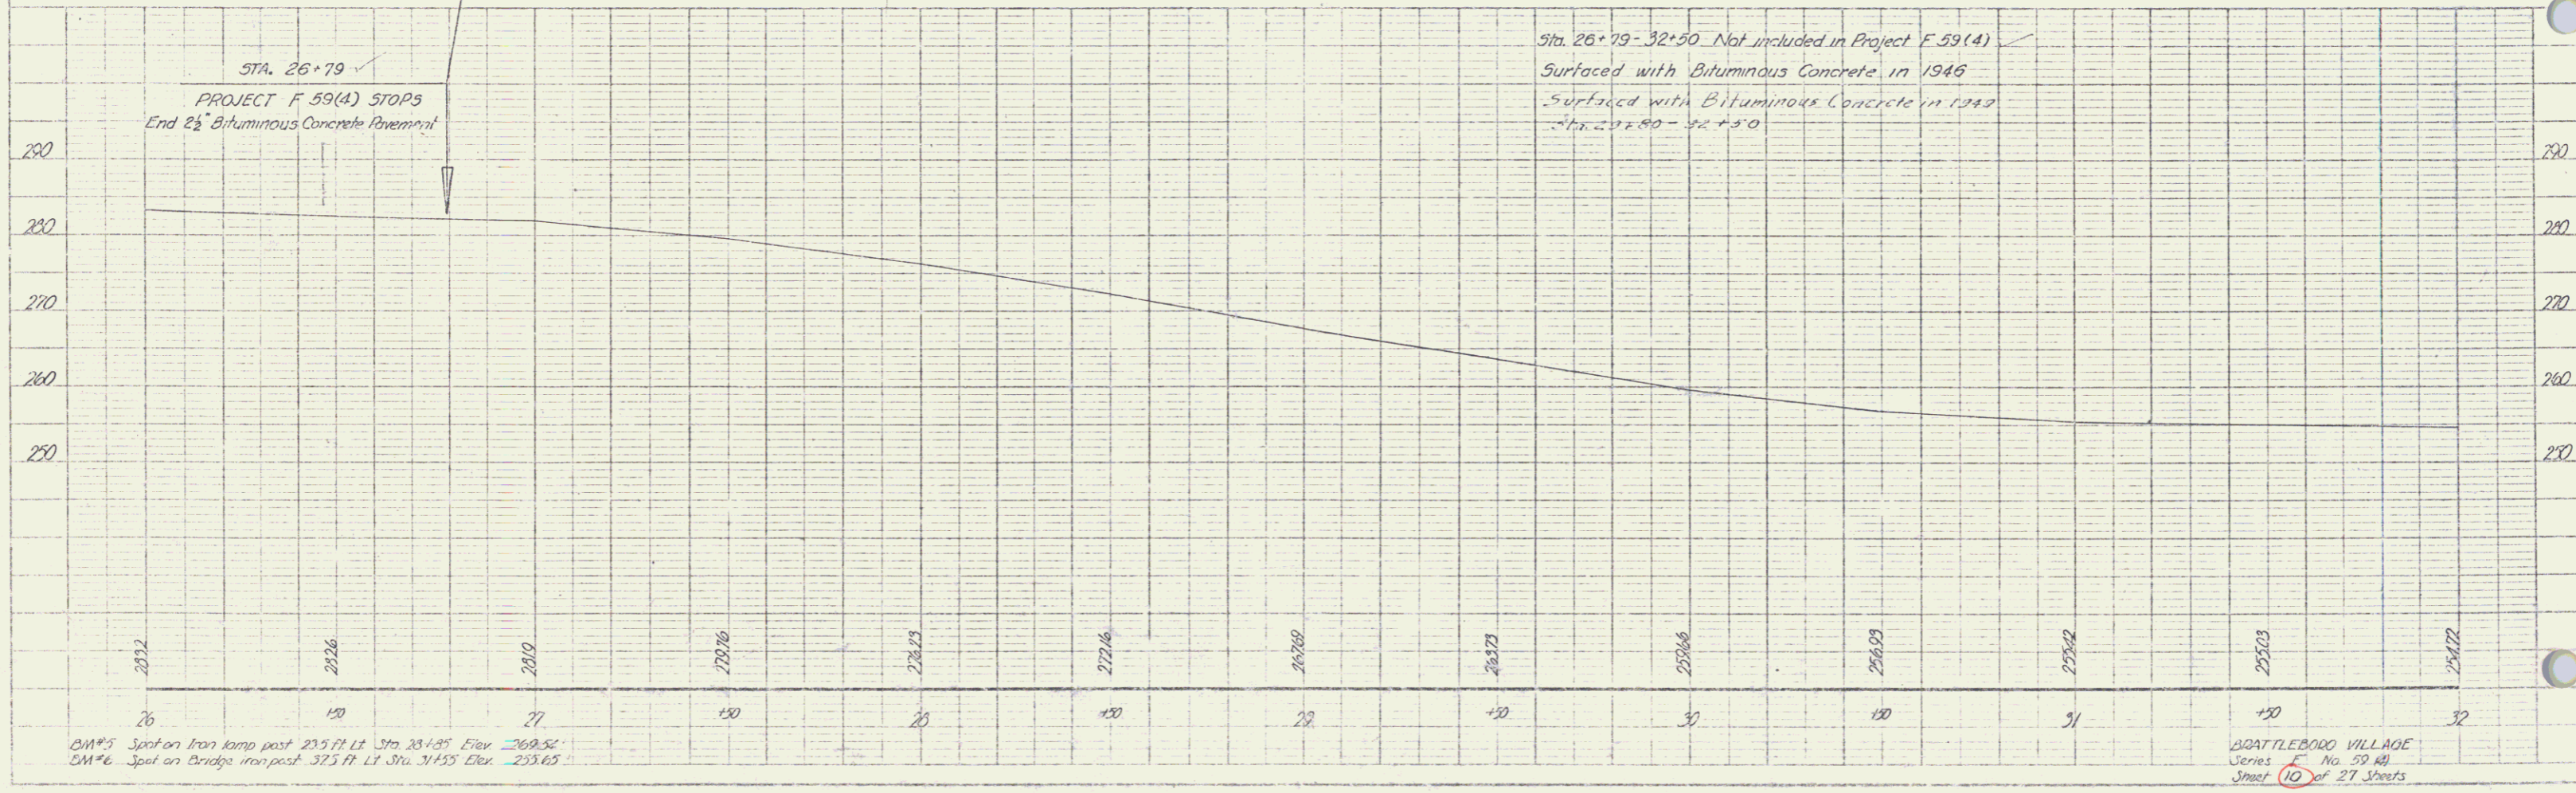

DM#5 Spot on Iron lamp post 23.5 ft LI Sta. 26+95 Elev. 269.52
 DM#6 Spot on Dredge iron post 37.5 ft LI Sta. 31+55 Elev. 255.65

SEATTLEBORO VILLAGE
 Series F No. 59 (4)
 Sheet 10 of 27 Sheets