


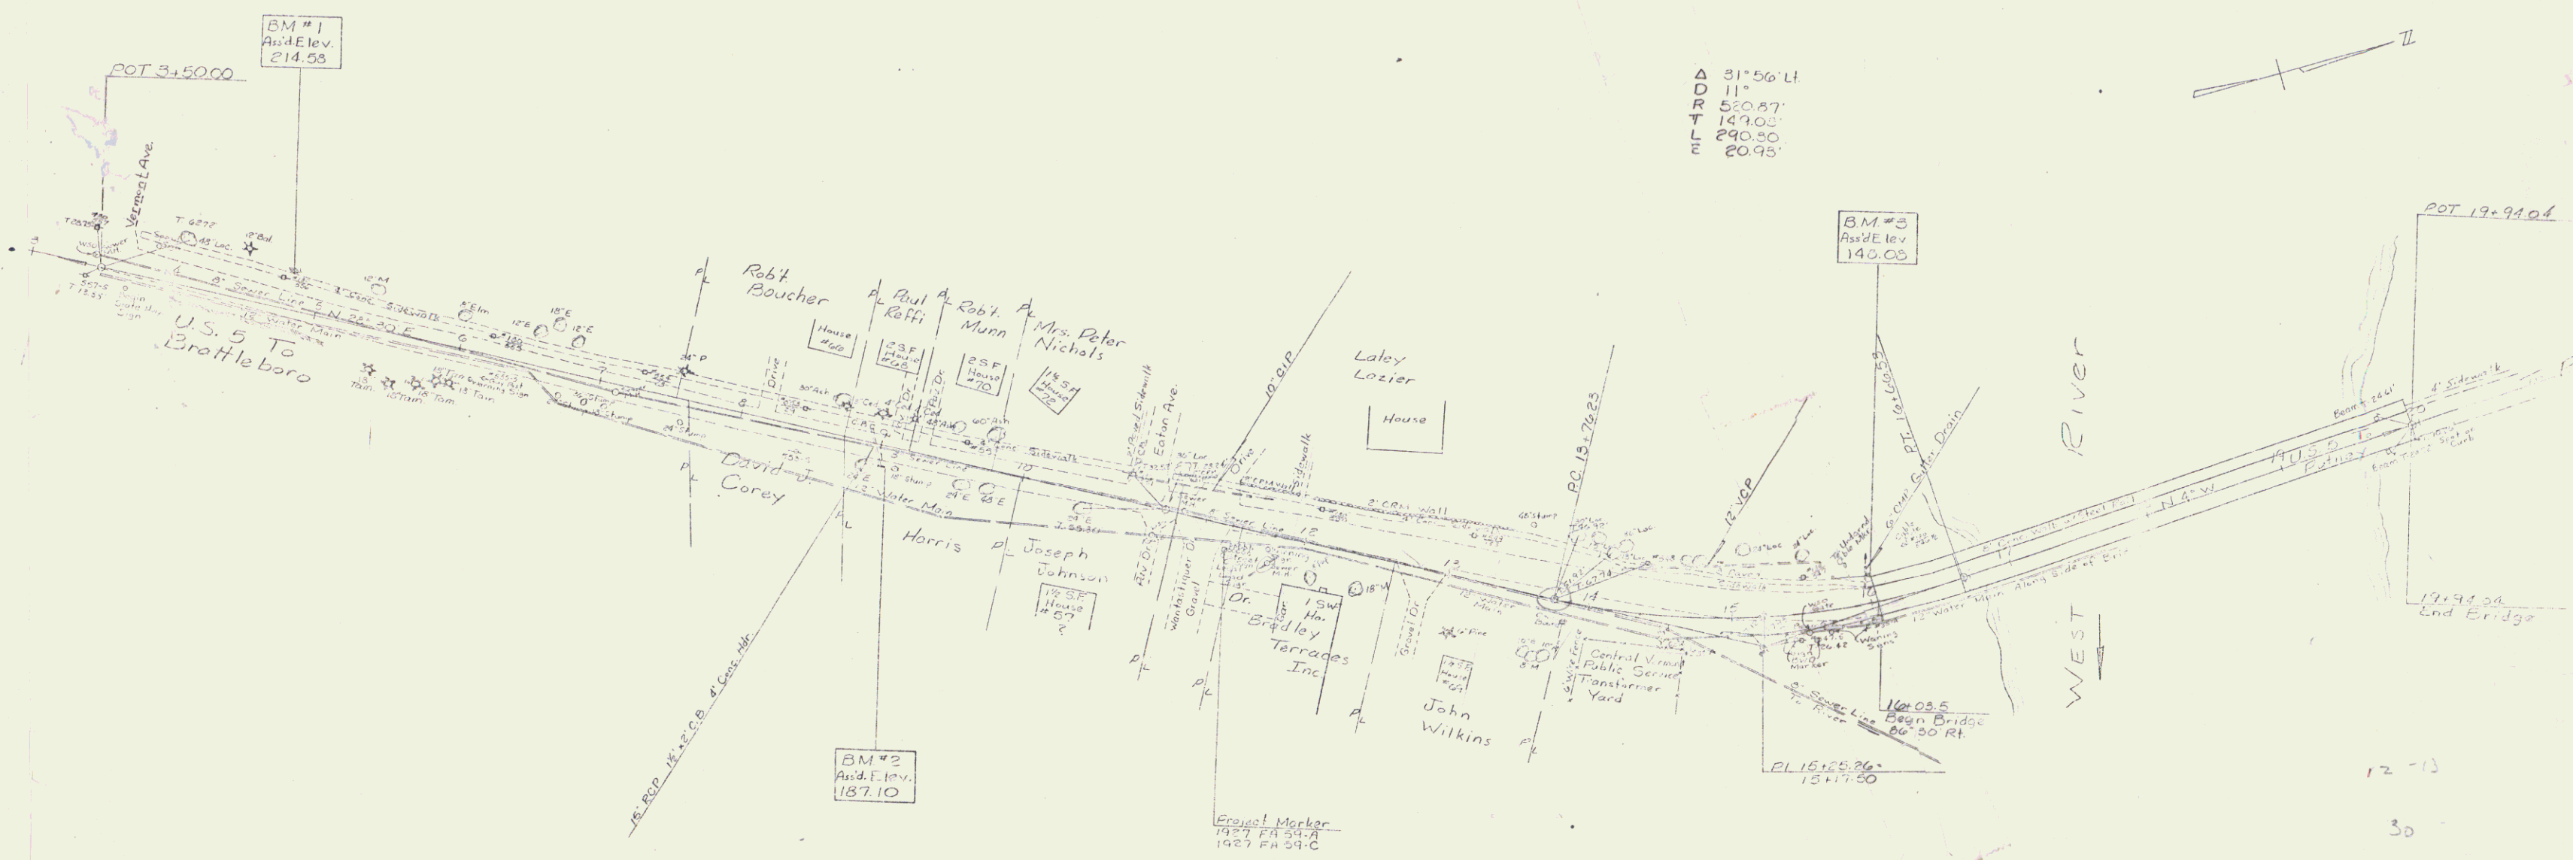

Δ 31°56'41"
D R 11°
T 520.87'
L 149.03'
E 290.80'
E 20.95'

Notes: 2'-5" paved shoulders on both edge of pavement
also paved gutter between left edge of road and sidewalk.
3+00 Begin State Hwy.
3+41 begin underground telephone cable. Runs between
edge of roadway and edge of sidewalk.
Steel truss bridge w/ 20' roadway between concrete curbs.
See bridge plans for data. Last repair done in 1953.
Sewer and water lines are taken from city of Brattleboro plans.
If any additional information is needed see
Justin Holden, Brattleboro Water Dept.

Scale 1"=50'

BRATTLEBORO
BP 041-1-6696
Surveyed by Smith
11/56

BP 041-1-7107 Row 2