



- STA. 48+60 LT. CONST. & MAINT. SPECIAL DITCH (P)
- STA. 48+60 LT. CONST. & MAINT. CULVERT (P) (18"X110')
- STA. 48+60 LT. DRAINAGE RT. (P)
- STA. 48+60 LT. CONST. & MAINT. CULVERT (P) (18"X66')
- STA. 48+60 LT. DRAINAGE RT. (P)

GLENDON B. ORNE & MARJORIE B. ORNE  
 TO ST. OF VERMONT BY W.D.O.E. ON 5/11/78  
 IN BRATTLEBORO L.R. BK 155/161  
 M.P. 0338

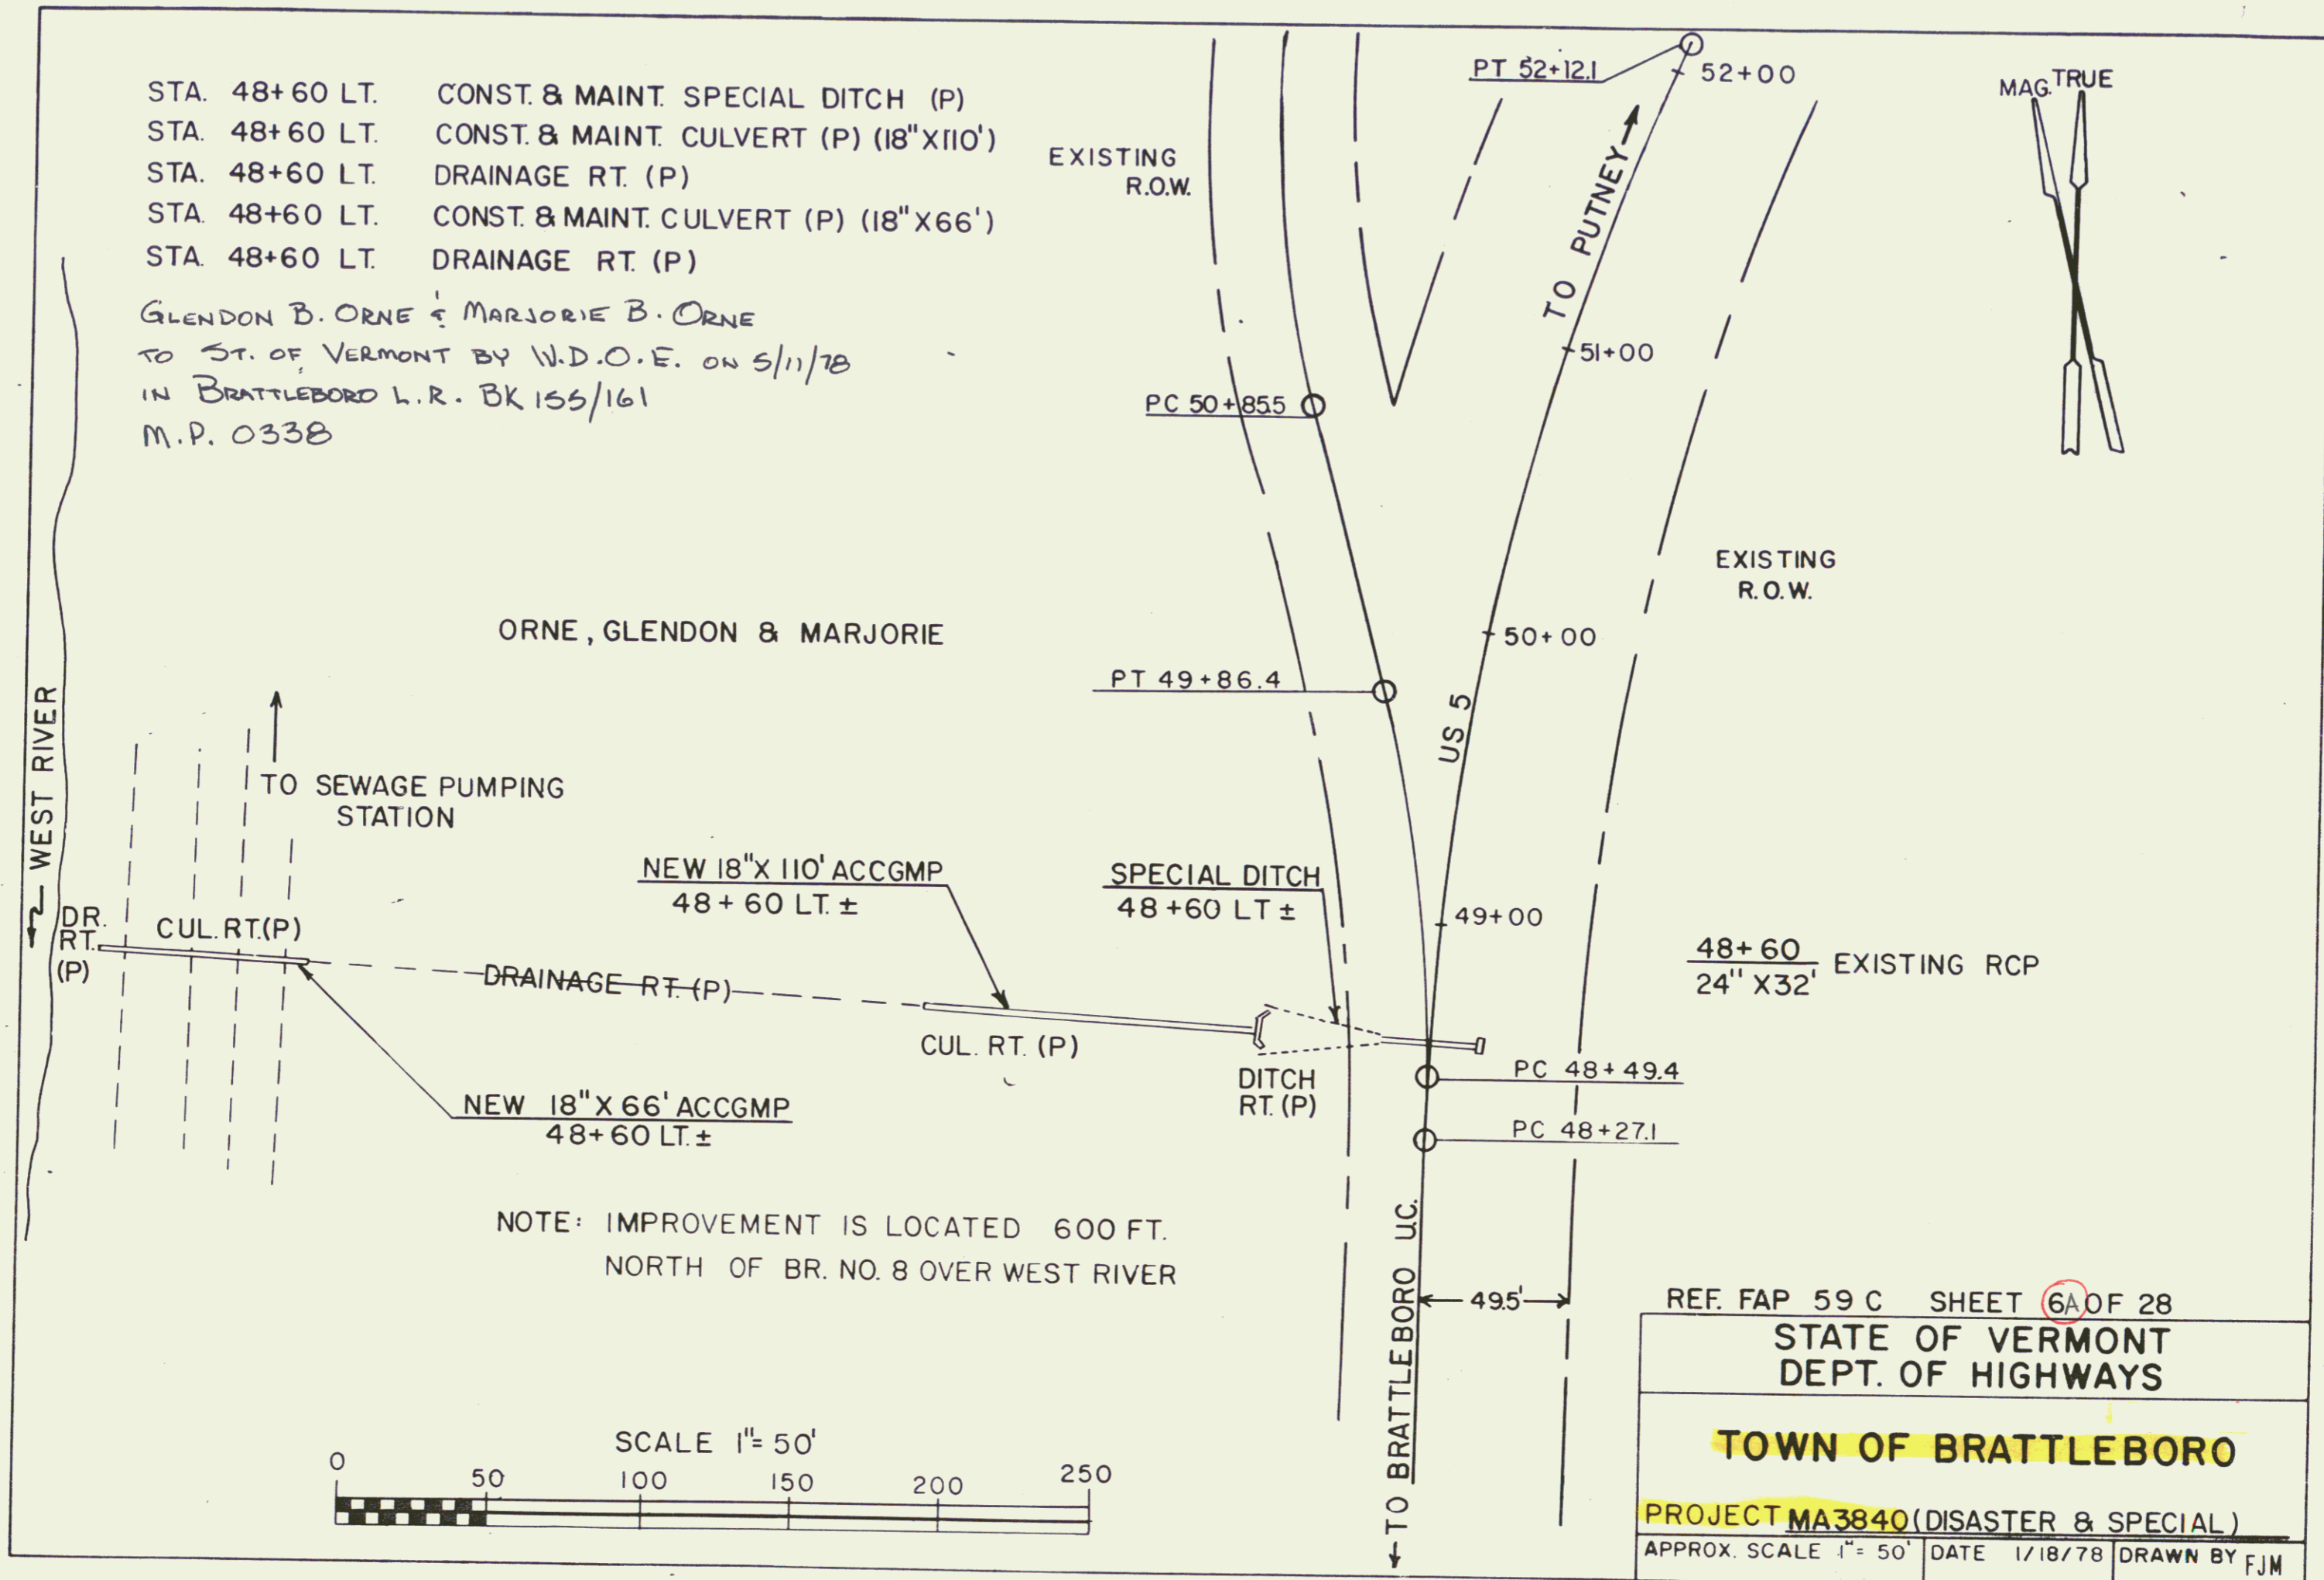

NOTE: IMPROVEMENT IS LOCATED 600 FT. NORTH OF BR. NO. 8 OVER WEST RIVER

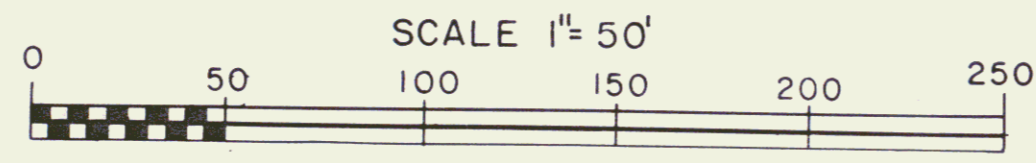

REF. FAP 59 C SHEET 6A OF 28		
STATE OF VERMONT DEPT. OF HIGHWAYS		
<b>TOWN OF BRATTLEBORO</b>		
PROJECT MA3840 (DISASTER & SPECIAL)		
APPROX. SCALE 1" = 50'	DATE 1/18/78	DRAWN BY FJM

6