


CABLE GUARD SWIL  
 73+51-76+00 LT 149 LIN FT  
 71+52-73+63 RT 211 LIN FT  
 TOTAL 360 LIN FT

PLAN NUMBER	111	112	113	114	115
DIST. NO.	1	2	3	4	5



Parcel	Instrument	Grantor	Grantee	Recorded	Remarks
A	M.D.O.E. 11-28-51	DAVID HELEN & HOPKINS	ST OF VERMONT	304 12-3-51	See Sheet 687

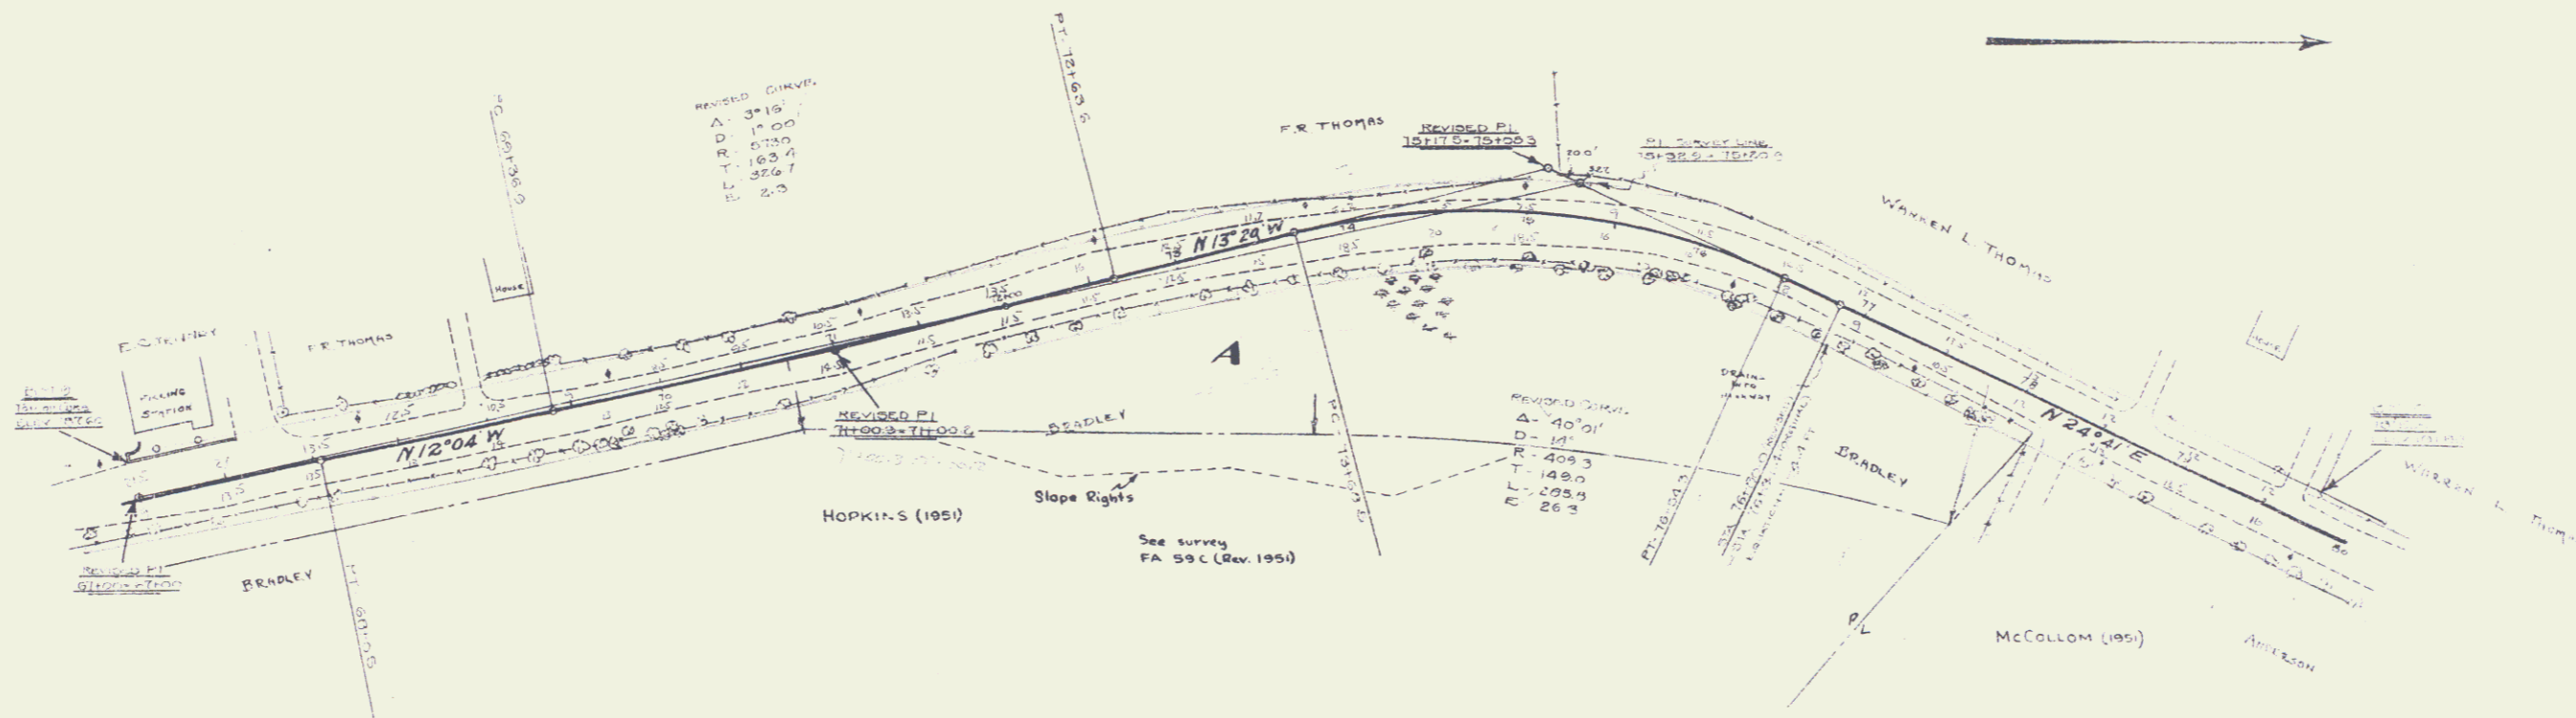