


1927 POT 62165.1 =
 1972 POT 63100.0 $\Delta = -39.9'$

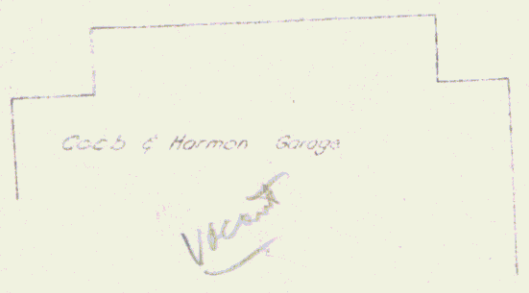

PARCEL # 9
 NED H PETTENGILL
 TAKING 0.12 A²
 SE Hwy. Eave. Based on
 1927 Boundary Location
 Purchased 9/1/72 for \$52,350

66+44
 40' R/L
 66+44
 59' R/L

PARCEL # 6
 GERALD & JUDITH SCANLAN
 TAKING 0.09 A²
 Vacant land

68+46
 40' R/L
 68+46
 40' R/L

— PREVIOUSLY ACQUIRED
 — NOT YET ACQUIRED

SURVEYED BY: _____
 DRAWN BY: _____
 TRACED BY: _____
 18