



CABLE GUARD RAIL
 73+51-75+40 LT 149 LIN. FT.
 71+52-73+63 RT 211 LIN. FT.
 TOTAL 360 LIN. FT.

11 08 03 22 0 20

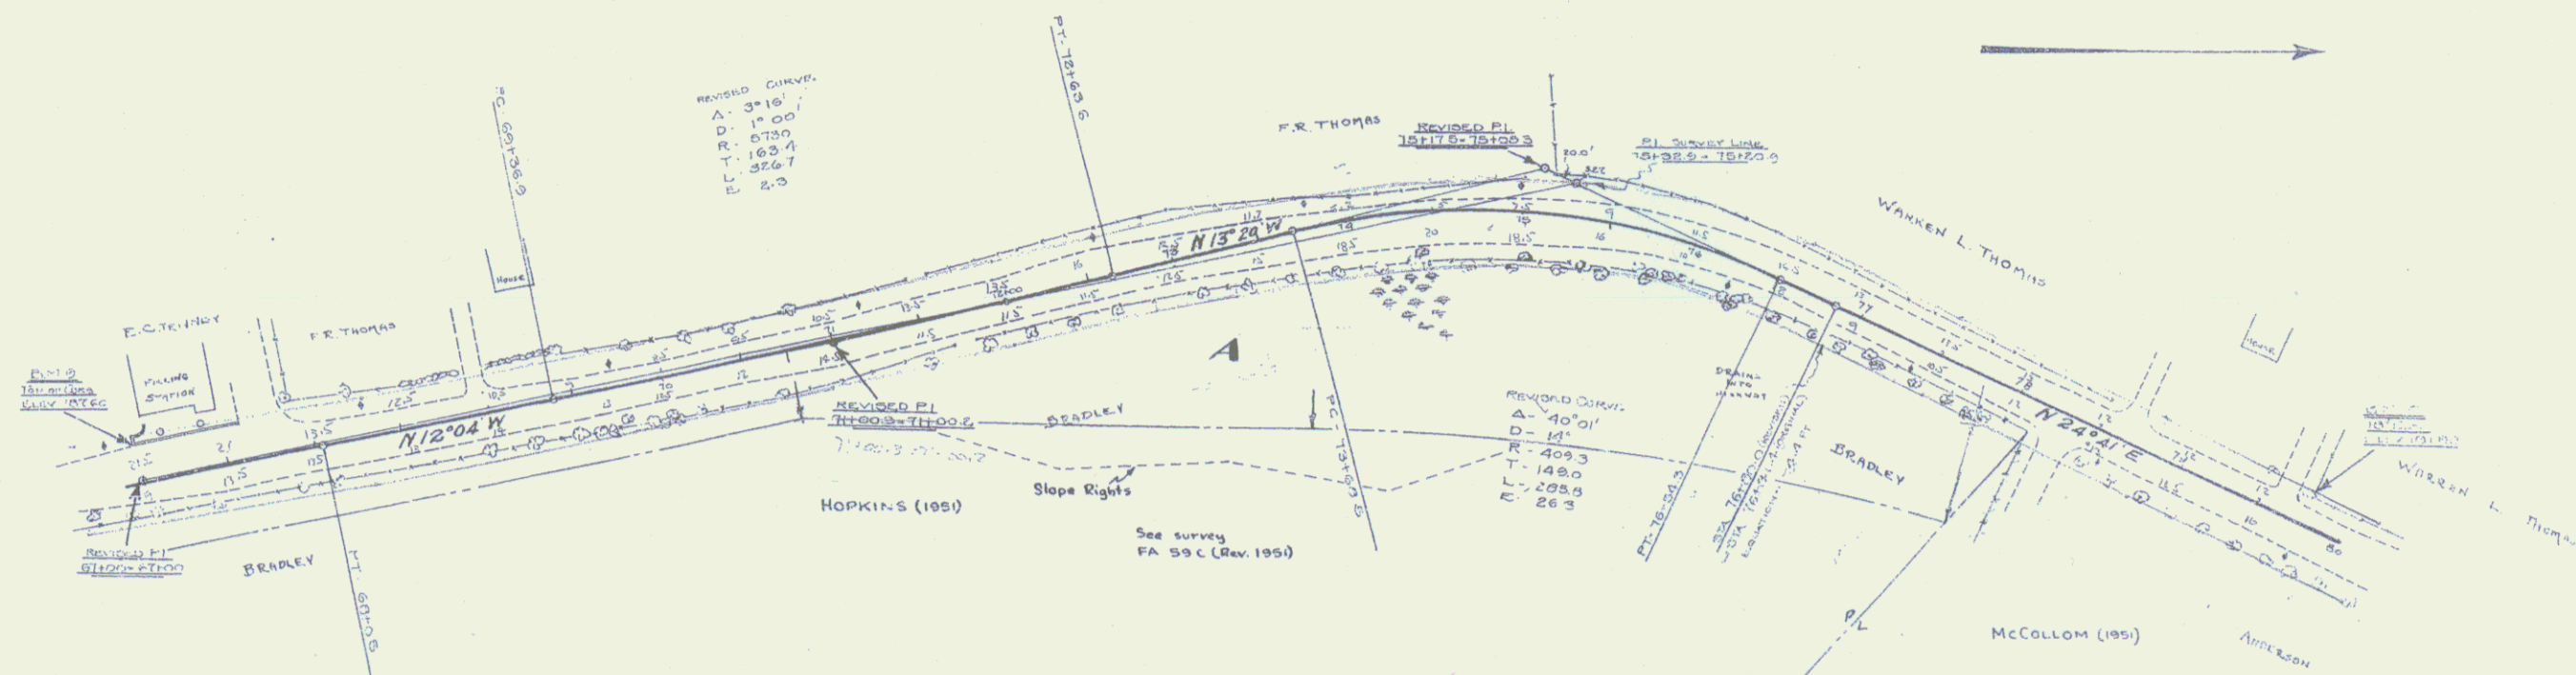

Parcel	Instrument	Grantor	Grantee	Recorded	Remarks
A	W.D.O.E. 11-25-51	DAVID GREEN B. HOPKINS	ST. OF VERMONT	SI 304 12-3-51	See Sheet 687

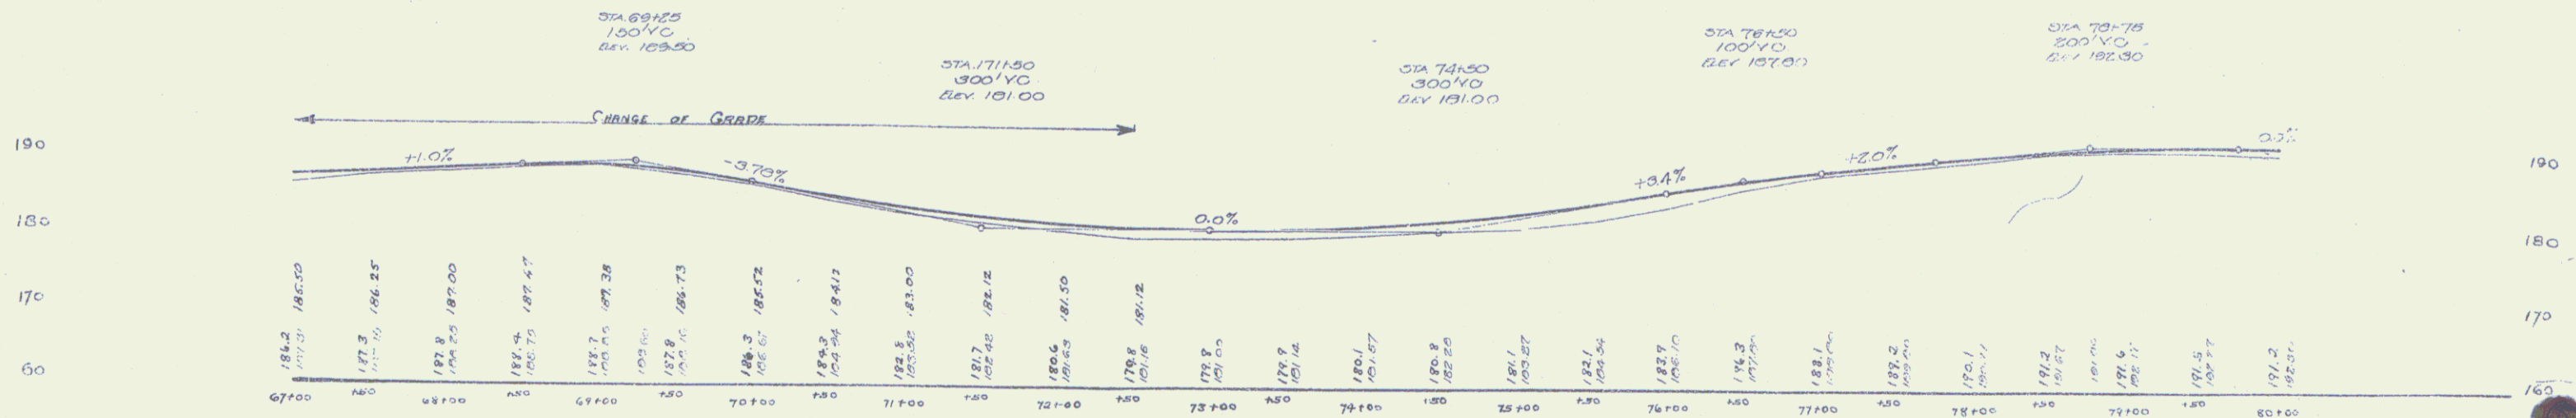

SHEET 38