

INDEX OF SHEETS



SHEET NO. 1	TITLE PAGE
2	SUMMARY OF OVERHEAD TRAFFIC SIGNS
3	LOCATION PLAN OF OVERHEAD SIGN STRUCTURES
4	DETAILS OF SOUTHBOUND STRUCTURE AT STA 113+25
5	DETAILS OF NORTHBOUND STRUCTURE AT STA 110+64
6	DETAILS OF EASTBOUND STRUCTURE AT STA 5+84
7	DETAILS OF WESTBOUND STRUCTURE AT STA 8+46
8	OVERHEAD SIGN DETAILS
9	E-5A SIGN POST FOOTINGS DETAILS
10	E-1 BARRICADES, SIGNS AND LIGHTS

OVERHEAD TRAFFIC SIGNS

TOWN OF BRATTLEBORO

COUNTY OF WINDHAM.
JCT. OF U.S. 5 AND VT. 9
"KEENE TURN"

Plan # 99R249

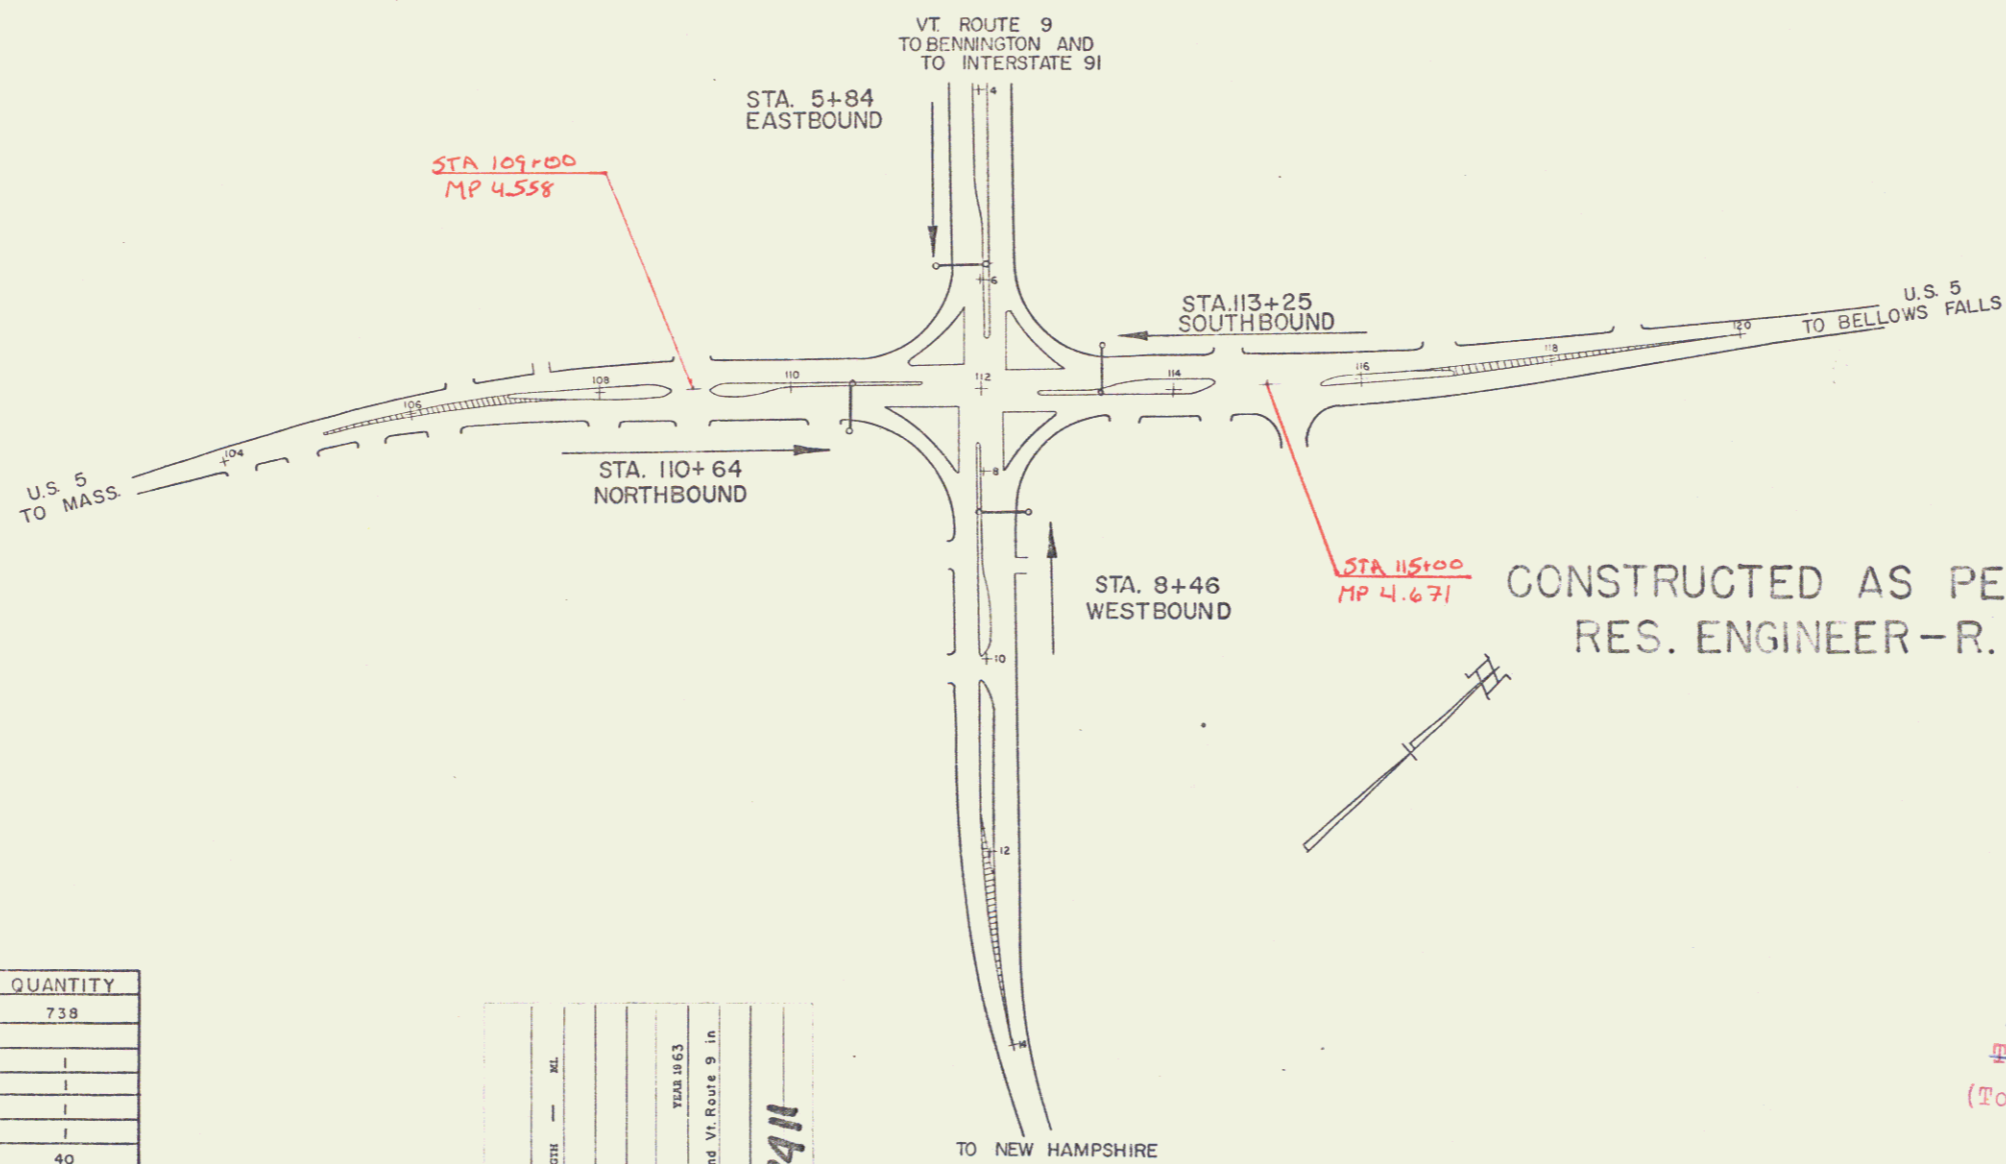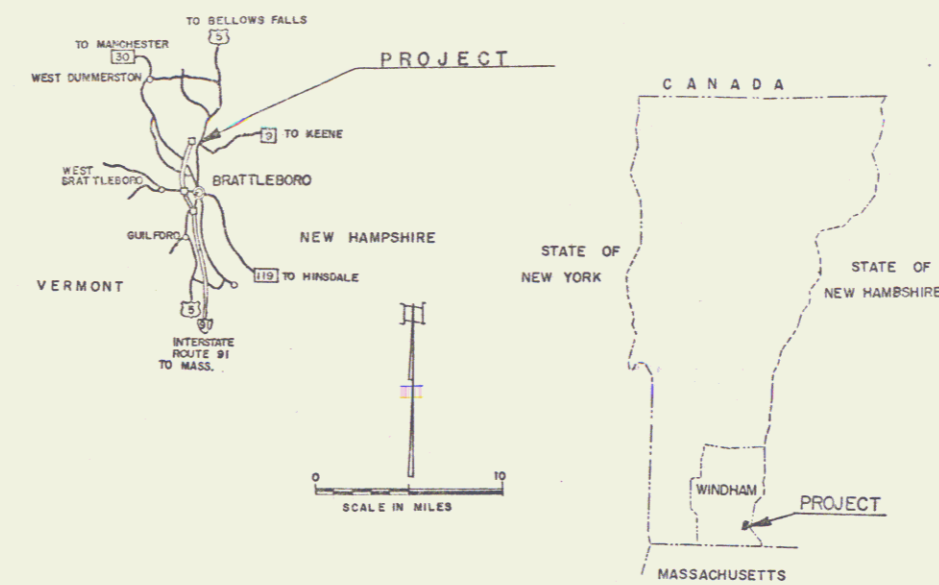

QUANTITIES

NO	ITEM	UNIT	QUANTITY
576	EXPOSED ALUMINUM PANEL SIGNS	SQ. FT.	738
578	OVERHEAD TRAFFIC SIGN SUPPORT		
	STATION 113+25	L.S.	1
	STATION 110+64	L.S.	1
	STATION 5+84	L.S.	1
	STATION 8+46	L.S.	1
594	UNIFORMED TRAFFIC OFFICERS	MAN/HR	40

PROJECT: BRATTLEBORO, VERMONT
 NUMBER: ST 41-1M
 TYPE: TRAFFIC SIGNS
 CONTRACTOR: S. GRAYWOLD & CO., INC., BRATTLEBORO, VERMONT
 LOCATION: "Keene Turn", the junction of U.S. Route 5 and Vt. Route 9 in the town of Brattleboro.
 Box 207 3411

MP 4.61
 RIGHT-OF-WAY DIVISION
 TOWN FILE
 PERPETUAL
 Town of U.S.S.
 (To Be Returned To R.O.W. Division)

PROJECT ST 41-1M

SHEET 1 OF 10

APPROVED <u>Dec 10/1962</u> DATE <i>R.O. Munn</i> DISTRICT ENGINEER	APPROVED <u>Dec 7/1962</u> DATE <i>A.W. Colman</i> TRAFFIC ENGINEER	APPROVED <u>12/7/62</u> DATE <i>E.H. Stuckey</i> CONSTRUCTION ENGINEER	APPROVED <u>12-7-62</u> DATE <i>H.M. Lane</i> HIGHWAY ENGINEER	APPROVED <u>12-7-62</u> DATE <i>A.D. Bishop</i> CHIEF ENGINEER
--	--	---	---	---