

INDEX OF SHEETS

SHEET NO.	TITLE PAGE
1	TYPICAL CROSS-SECTION OF IMPROVEMENT (BITUMINOUS CONCRETE PAVEMENT)
2	QUANTITY SHEET (ITEMS)
3	QUANTITY SHEET (DRAINAGE)
4-6	PAVING SHEETS
7-9	PLAN AND PROFILE SHEETS
10	BRIDGE STANDARD SHEET 58-5A-56 (ALUMINUM RAIL)
11	BRIDGE STANDARD SHEET 58-20-56 (BRIDGE DETAILS)
12-19	BRIDGE STANDARD SHEET 58-30-56
20	ROADWAY STANDARD SHEET RS 56-1 (DRAINAGE TABLES)
21	ROADWAY STANDARD SHEET RS 56-2 (DRAINAGE TABLES)
22	ROADWAY STANDARD SHEET RS 56-3 (PLANK GUARD RAIL & MARKERS)
23	ROADWAY STANDARD SHEET RS 56-4 (DRAINAGE)
24	ROADWAY STANDARD SHEET RS 56-5 (CURB & SIDEWALK)
25	ROADWAY STANDARD SHEET RS 56-6 (TYPICAL GUARDING)
26	ROADWAY STANDARD SHEET RS 56-7 (CONCRETE CATCH BASINS)
27	ROADWAY STANDARD SHEET RS 56-8 (BARRICADES, SIGNS, & LIGHTS)
28	ROADWAY STANDARD SHEET RS 56-9 (PANEL TYPE GUARD RAIL)
29	ROADWAY STANDARD SHEET RS 57-1 (ENTRANCE & EXIT TERMINALS)
30	ROADWAY STANDARD SHEET RS 57-2 (DIMENSIONAL ISLAND, ETC.)
31	ROADWAY STANDARD SHEET RS 57-3 (REFLECTORIZED SIGNS)
32	ROADWAY STANDARD SHEET RS 57-4 (PLYWOOD SIGNS, DETAILS)
33	TRAFFIC SIGN SUMMARY SHEET
34	TRAFFIC SIGN LOCATION PLAN
35	TRAFFIC SIGNALS, CONSTRUCTION DETAIL
36	TRAFFIC SIGNALS, LOCATION
37	TRAFFIC SIGNALS, CONSTRUCTION DETAIL
38	BRIDGE SHEET, PRELIMINARY INFORMATION
39	BRIDGE SHEET, ADJUSTMENTS 1 & 2
40	BRIDGE SHEET, SUPERSTRUCTURE
41	BRIDGE SHEET, RAILINGS DETAILS
42	BRIDGE SHEET, STEEL SCHEDULE
43-49	CROSS SECTIONS
50-59	CHANNEL SECTIONS

STATE OF VERMONT
DEPARTMENT OF HIGHWAYS

PROPOSED IMPROVEMENT
TOWN OF BRATTLEBORO
COUNTY OF WINDHAM
U.S. ROUTE 5 & VT. ROUTE 9
BRATTLEBORO-BELLOWS FALLS ROAD

Pin# 99R250

BEGINNING AT A POINT 902 FEET SOUTH OF THE U.S. ROUTE 5 AND VT. ROUTE #9 INTERSECTION, AND PROCEEDING NORTHERLY 3521.2 FEET TO A POINT 2619.2 FEET NORTH OF THE U.S. ROUTE 5 AND VT. ROUTE #9 INTERSECTION.

LENGTH OF ROADWAY 3487.2 FEET 0.660 MILES ✓
LENGTH OF BRIDGE 34.0 FEET 0.006 MILES ✓
LENGTH OF PROJECT 3521.2 FEET 0.666 MILES ✓


ADT 1955	5415
ADT 1975	5920
DHV 1975	775
D	70%
T	10%
V	60 MPH

PROJECT NAME & NUMBER TYPE PAVEMENT AREA
BRATTLEBORO (KANE TURN) (441)(1) BIT. CONC. PAVEMENT 18,760 sq. YD.

RECORD PLANS

MATERIALS
GRAVEL STONE BASE - MASS. BROKEN STONE CO. - GREENFIELD, MASS.
CLOGGABLE GRAVEL - ILLARD PIT - BRATTLEBORO, VERMONT
FINE STONE FOR SEAL - BRATTLEBORO SAND & GRAVEL - BRATTLEBORO, VT.
BITUMEN TAR - LAKE ASPHALT & PETROLEUM CO. - NORTHFIELD, MASS.
HOT-BIT ASPHALT - MOBIL OIL CO. - PROVIDENCE, RHODE ISLAND
REINFORCING STEEL - VERMONT STRUCTURAL STEEL CO. - BURLINGTON, VT.
STRUCTURAL STEEL - HULEO WASH STEEL CO. - PITTSFIELD, MASS.
PORTLAND CEMENT - NORTHAMPTON, PA.
PRECAST CONCRETE PIPE - VERMONT CONCRETE PIPE CO. - WINDSOR, VT.
ASPH. CIL. CORR. GALV. METAL PIPE - NORTHEAST CULVERT CO. - WESTMINSTER, VT.
WOODEN MARKER POSTS -
STANDARD STEEL BEAM GUARD RAIL - LANL FENCE CO. - MERIDEN, CONN.
SLOPE EDGING
CONCRETE CURB - FLETCHER CO. - CHELMSFORD, MASSACHUSETTS
BRIDGE RAILING (ALUMINUM) - FULTON RAILING, INC. - LAWRENCE, MASS.
CONTRACTOR - MALDEN SAND & CONCRETE PRODUCTS CO. - GREENFIELD, MASS.

DESIGN ENGINEER - D.G. DANZ.
INVENTOR - H. MACLARY
RECORD PLANS - H.A. PRESTON & F.G. WIMBLE.
CONTRACT DATED - JULY 31, 1958.
CONTRACT STARTED - AUGUST 4, 1958.
CONTRACT COMPLETED - OCTOBER 19, 1959.
CONTRACT ACCEPTED - OCTOBER 19, 1959.

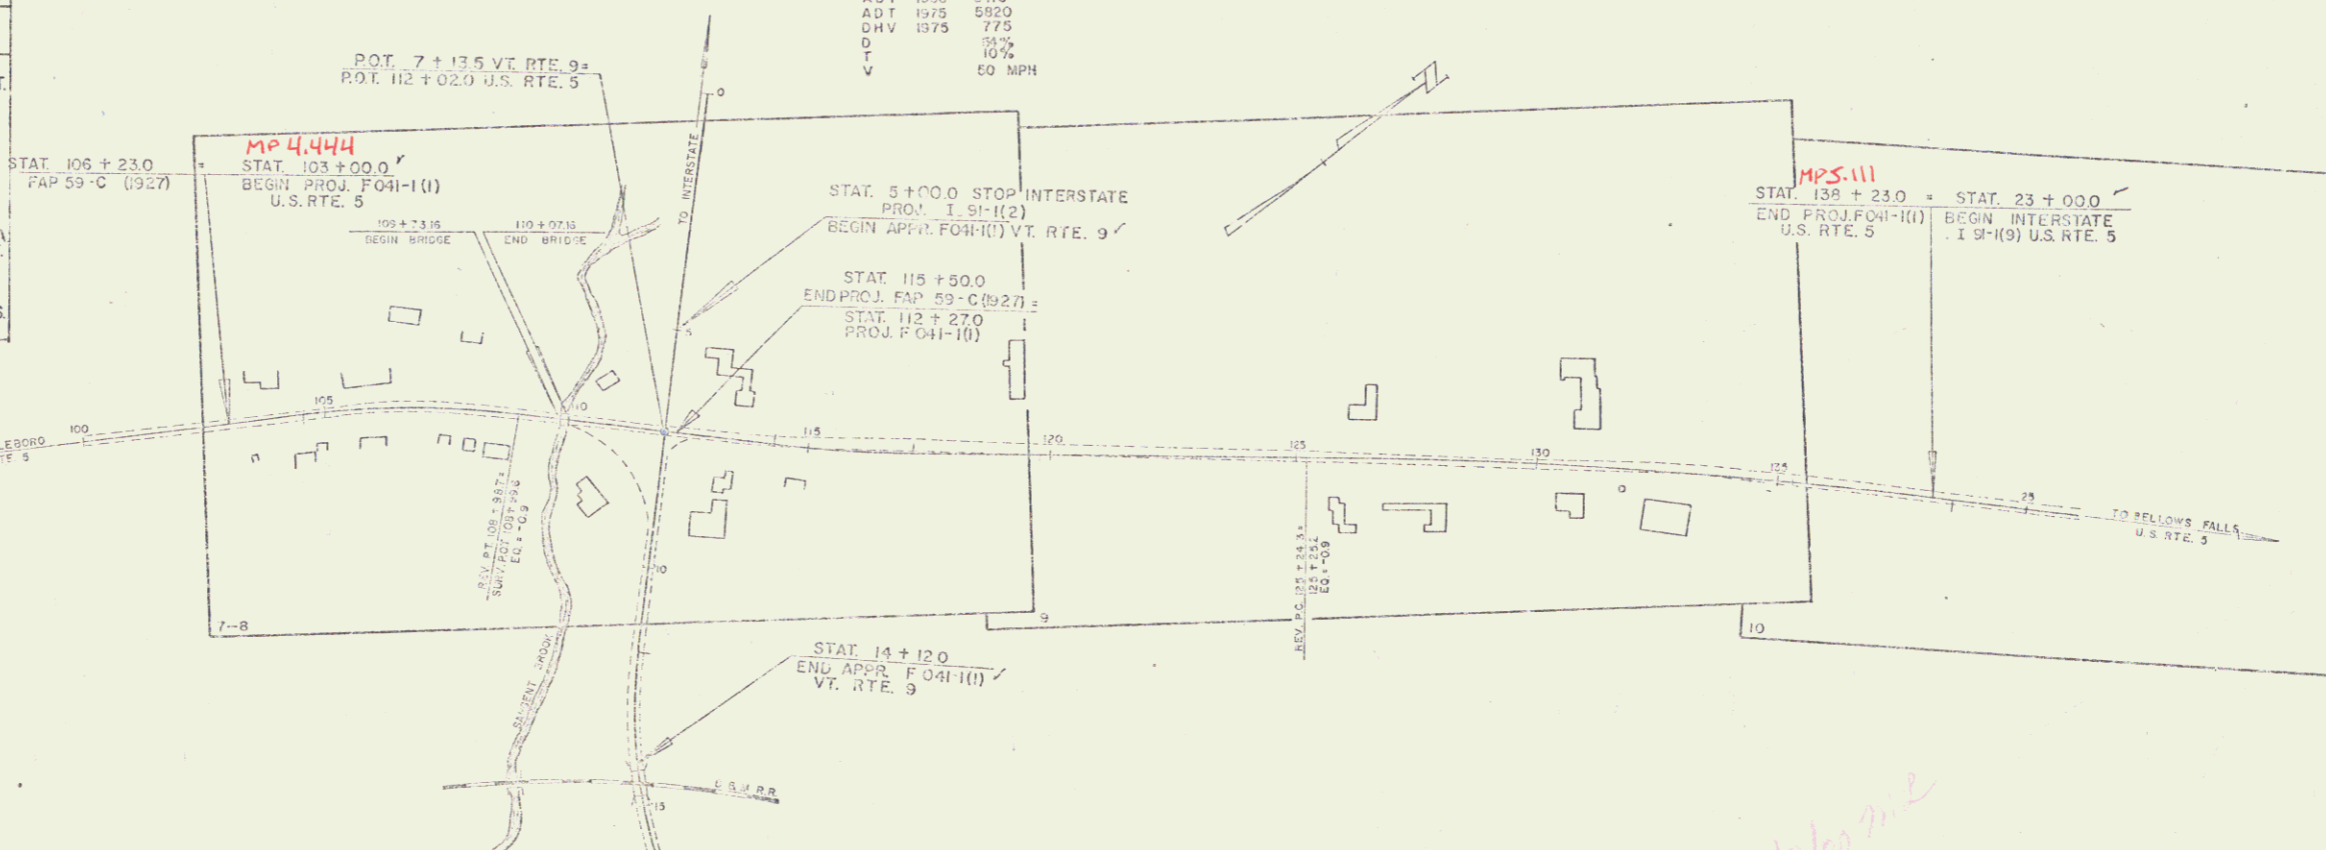

BRATTLEBORO (KANE TURN) (441)(1)
CONTRACTOR - MALDEN SAND & CONCRETE PRODUCTS CO.
DESIGN ENGINEER - D.G. DANZ.
INVENTOR - H. MACLARY
RECORD PLANS - H.A. PRESTON & F.G. WIMBLE.

ITEM	DATE	BY
DESIGNED	1958	D.G. DANZ
PLANNED	1958	H.A. PRESTON
RECORD PLANS	1958	F.G. WIMBLE
CONTRACT DATED	1958	H.A. PRESTON
CONTRACT STARTED	1958	H.A. PRESTON
CONTRACT COMPLETED	1959	F.G. WIMBLE
CONTRACT ACCEPTED	1959	F.G. WIMBLE

SCALES

TITLE	1" = 300'
TYPICAL	1" = 4'
PLAN	1" = 50 & 20'
PROFILE HORIZONTAL	1" = 50'
PROFILE VERTICAL	1" = 10'
CURVE SECTIONS	1" = 50' & 10'

THESE PLANS ARE SUBJECT TO CORRECTIONS AS MAY BE REQUIRED BY THE BUREAU OF PUBLIC ROADS OR THE COMMISSIONER OF HIGHWAYS.

CONSTRUCTION IS TO BE CARRIED ON IN ACCORDANCE WITH THE PLANS AND THE STANDARD SPECIFICATIONS FOR HIGHWAY AND BRIDGE CONSTRUCTION AS AMENDED FROM TIME TO TIME BY THE BUREAU OF PUBLIC ROADS AND THE COMMISSIONER OF HIGHWAYS AND SPECIAL APPROVED MODIFICATIONS AS NOTED ON THE PLANS AND SPECIAL PROVISIONS AS SET FORTH WITH THE PLANS.

DEPARTMENT OF COMMERCE
BUREAU OF PUBLIC ROADS

APPROVED	DATE	APPROVED	DATE	APPROVED	DATE	APPROVED	DATE	APPROVED	DATE

STEARNS R. JENKINS
USS