

DRIVES

LT	PT	RT
126 + 12.1	126 + 60	126 + 60
130 + 00	128 + 00	128 + 00
132 + 23	130 + 15	130 + 15
132 + 23	132 + 60	132 + 60

CUTTING & REMOVING TREES

121 + 65 LA	126 + 14 RT
121 + 98 RT	126 + 15 RT
122 + 69 LT	126 + 93 LT
123 + 42 LT	130 + 50 LT
123 + 26 LT	131 + 00 LT
124 + 46 LT	131 + 31 LT
124 + 61 LT	132 + 68 LT
124 + 72 LT	132 + 68 LT
125 + 21 RT	133 + 90 RT
125 + 91 RT	134 + 64 LT

SIDERoadS  
124 + 65 RT  
129 + 10 RT

GRANITE CURB (BARRIER)  
119 + 00 - 119 + 10 LT

STANDARD STEEL BEAM GUARD  
RAIL W/ STEEL POSTS  
133 + 25 - 134 + 25 RT

#15  
GLADYS P THOMAS ROWE  
STA 123 + 83 - 127 + 29 LT  
124 + 31 - 126 + 75 RT  
129 + 85 - 129 + 50 RT  
132 + 58 - 133 + 05 LT  
134 + 12 - 136 + 26 LT  
135 + 20 - 138 + 23 LT

SLOPE RIGHTS  
WDOE 7/18/58  
RECORDED: BRAT - BK 101 - PG 271  
7/30/58

#16  
ALFREDO'S INN, INC.  
HILL HOME INN, INC.  
STA 128 + 81 - 132 + 98 LT  
SLOPE RIGHTS  
COND 6/17/58  
RECORDED: BRAT - BK 101 - PG 275  
6/17/58

SURV. P.I. 16 + 48.3 =  
16 + 48.0

2ND  
REV. P.I. 131 + 96.0 =  
131 + 94.4

REV. P.I. 17 + 73.5 =  
17 + 72.5

#14 ALTON W. ADAMS ESTATE  
STA 123 + 71 - 126 + 83 LT  
SLOPE RIGHTS  
COND 6/17/58  
RECORDED: BRAT - BK 101 - PG 205 - 6/17/58

2 1/2 SF HO.

State of Vt.  
J.E.A. 01807  
C.D. 00000  
EASTLE ROAD 54 1/2 FT  
1,050 Sq. Ft.

2ND REV.  
Δ 6° 42' RT.  
D 0° 30'  
R 1459.2  
T 670.8  
L 1340.0  
E 19.6  
OO 100' BANK

REV.  
Δ 5° 41' RT.  
D 0° 30'  
R 1459.2  
T 568.8  
L 1136.6  
E 14.1

#17  
LOYAL C. & LYLE B. HODGE  
STA 130 + 34 - 130 + 68 RT  
133 + 43 - 134 + 07 RT  
SLOPE RIGHTS  
WDOE 7/11/58  
RECORDED: BRAT - BK 101 - PG 219 - 7/16/58


2ND REV. P.C. 125 + 24.3 =  
125 + 25.2  
E.O. = -0.9

129 + 98  
350' VC  
292.92

125 + 24.3  
125 + 25.2  
E.O. = -0.9

123 + 23  
300' VC  
291.96

133 + 73  
400' VC  
311.44

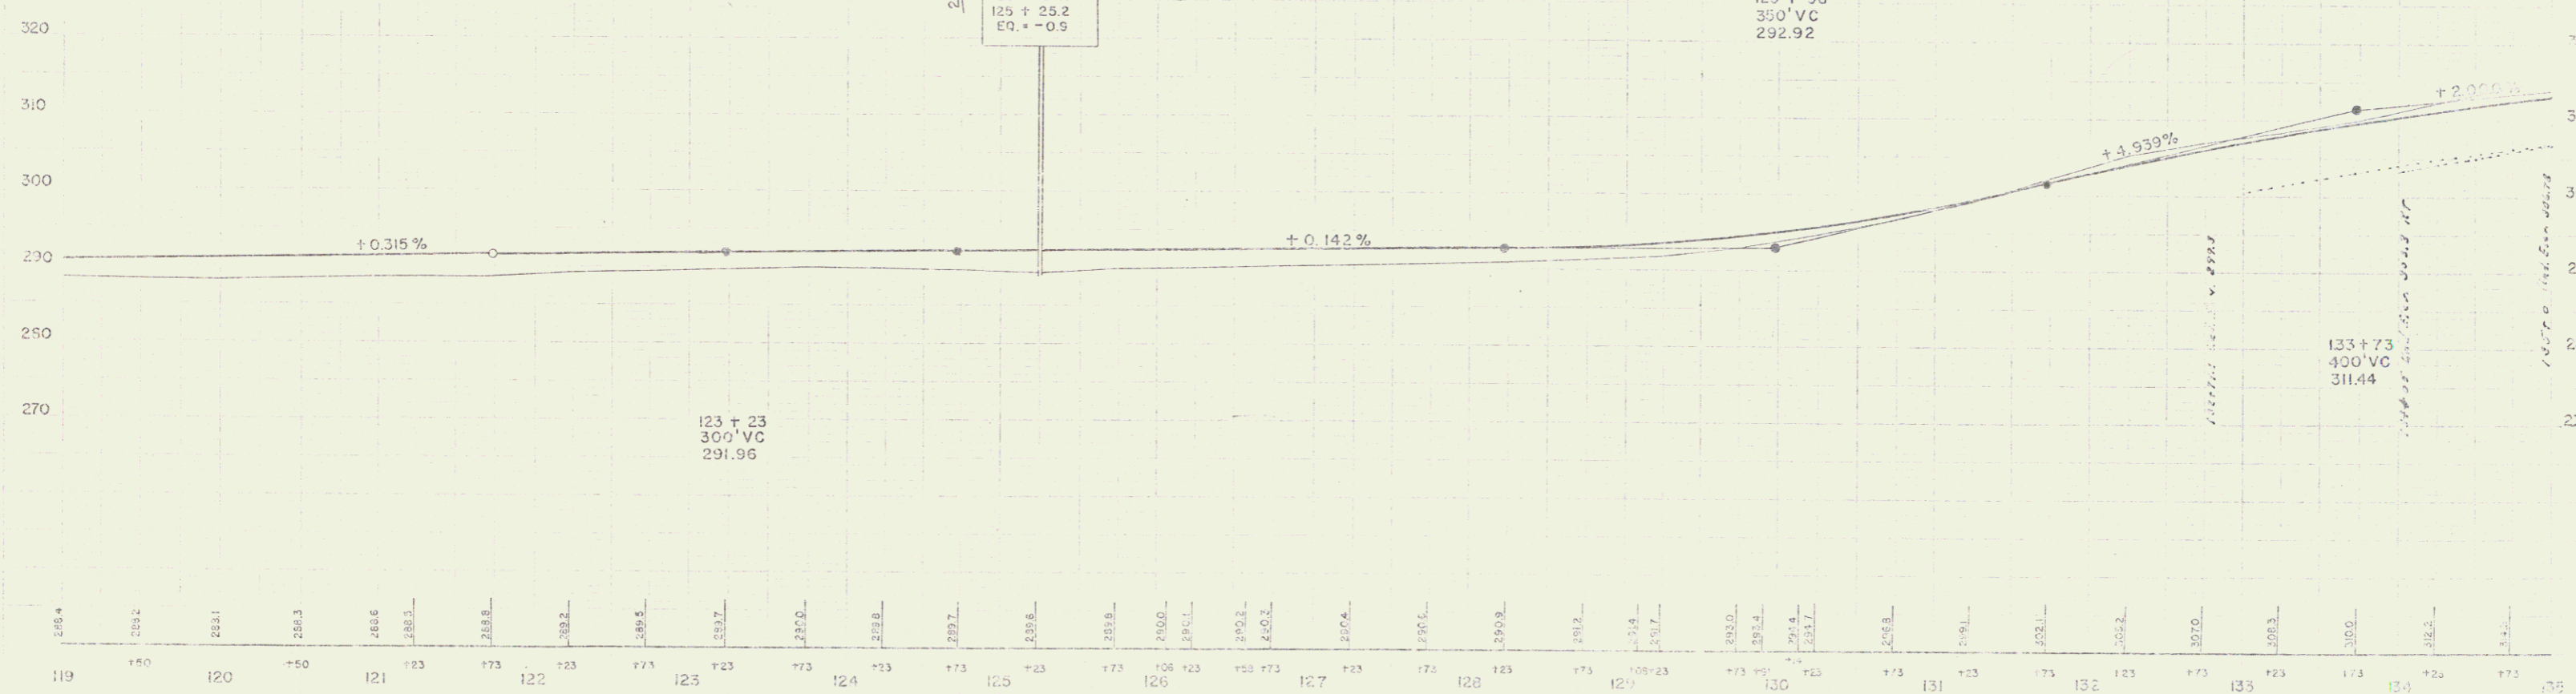

BM 1 119 + 00 - 120 + 00 - 121 + 00 - 122 + 00 - 123 + 00 - 124 + 00 - 125 + 00 - 126 + 00 - 127 + 00 - 128 + 00 - 129 + 00 - 130 + 00 - 131 + 00 - 132 + 00 - 133 + 00 - 134 + 00 - 135 + 00

BM 5 519 24' 41" - 8' 41" - Sta 126 + 86 - Elev 290.55

BM 6 619 24' 41" - 41' 41" - Sta 132 + 30 - Elev 306.20