


SURV. P.I. 106 + 78.8 =
 108 + 77.4
 Δ 14° 22' RT.
 D 6°
 REV. P.I. 106 + 78.8 =
 106 + 76.5

ITEM 314-A, SEE NOTE ON TYPICAL, SHEET 2 OF 71

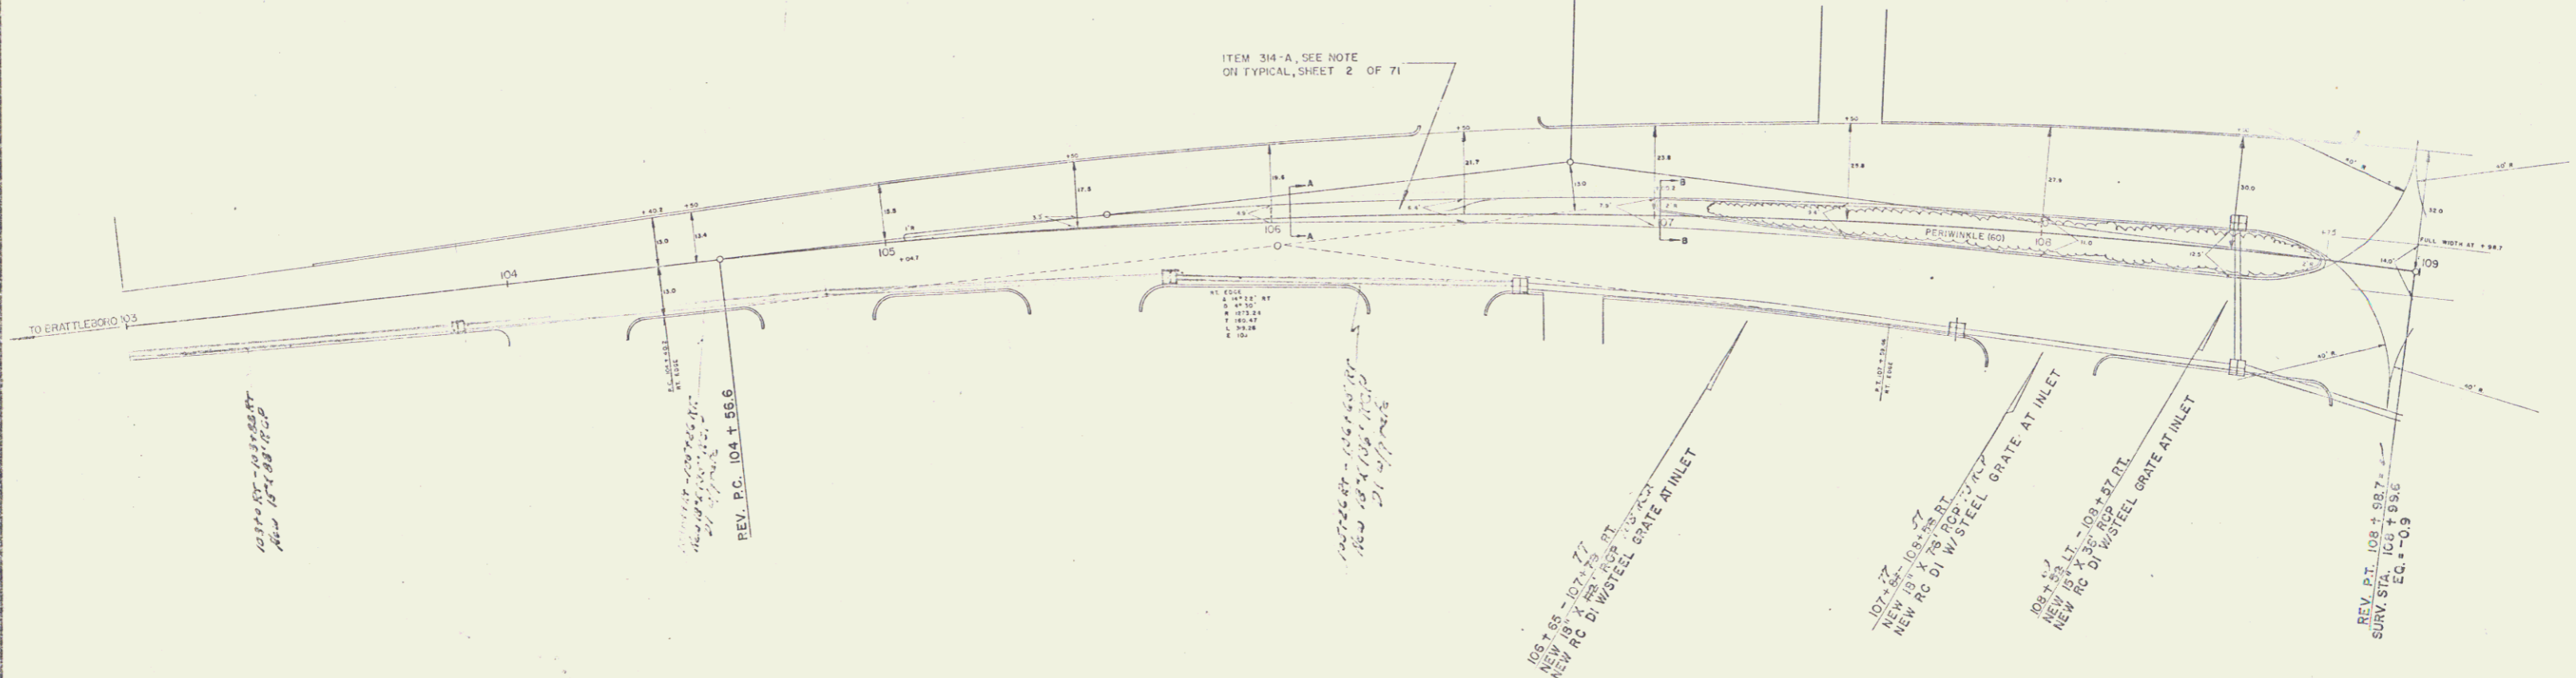

REV
 Δ 14° 22' RT
 D 3° 15'
 R 1763.2
 T 222.2
 L 442.1
 E 13.9

BRATTLEBORO
 PROJ. F NO 011-101
 SHEET 12 OF 72