


**Key Curve Data**  
 Δ 5° 41' 21"  
 D C 30'  
 R 1142.92  
 L 568.8  
 L 1156.6  
 L 13.9

PARCEL	INSTRUMENT	DATE	GRANTOR	GRANTEE	RECORDED BOOK	RECORDED PAGE	RECORDED DATE	REMARKS
A, B	W.D.O.E.	4-30-61	MARTHA E. PELTIER	ST. OF VT.	76	515	8-11-61	
A'	W.D.O.E.	2-16-45	LOYAL L. LYLE HODGE	ST. OF VT.	82	37	2-23-45	
A"	W.D.O.E.	12-28-45	L. E. & G. P. THOMAS	"	82	319	1-11-46	
B	"	"	"	"	82	319	1-11-46	
C	"	"	"	"	82	319	1-11-46	

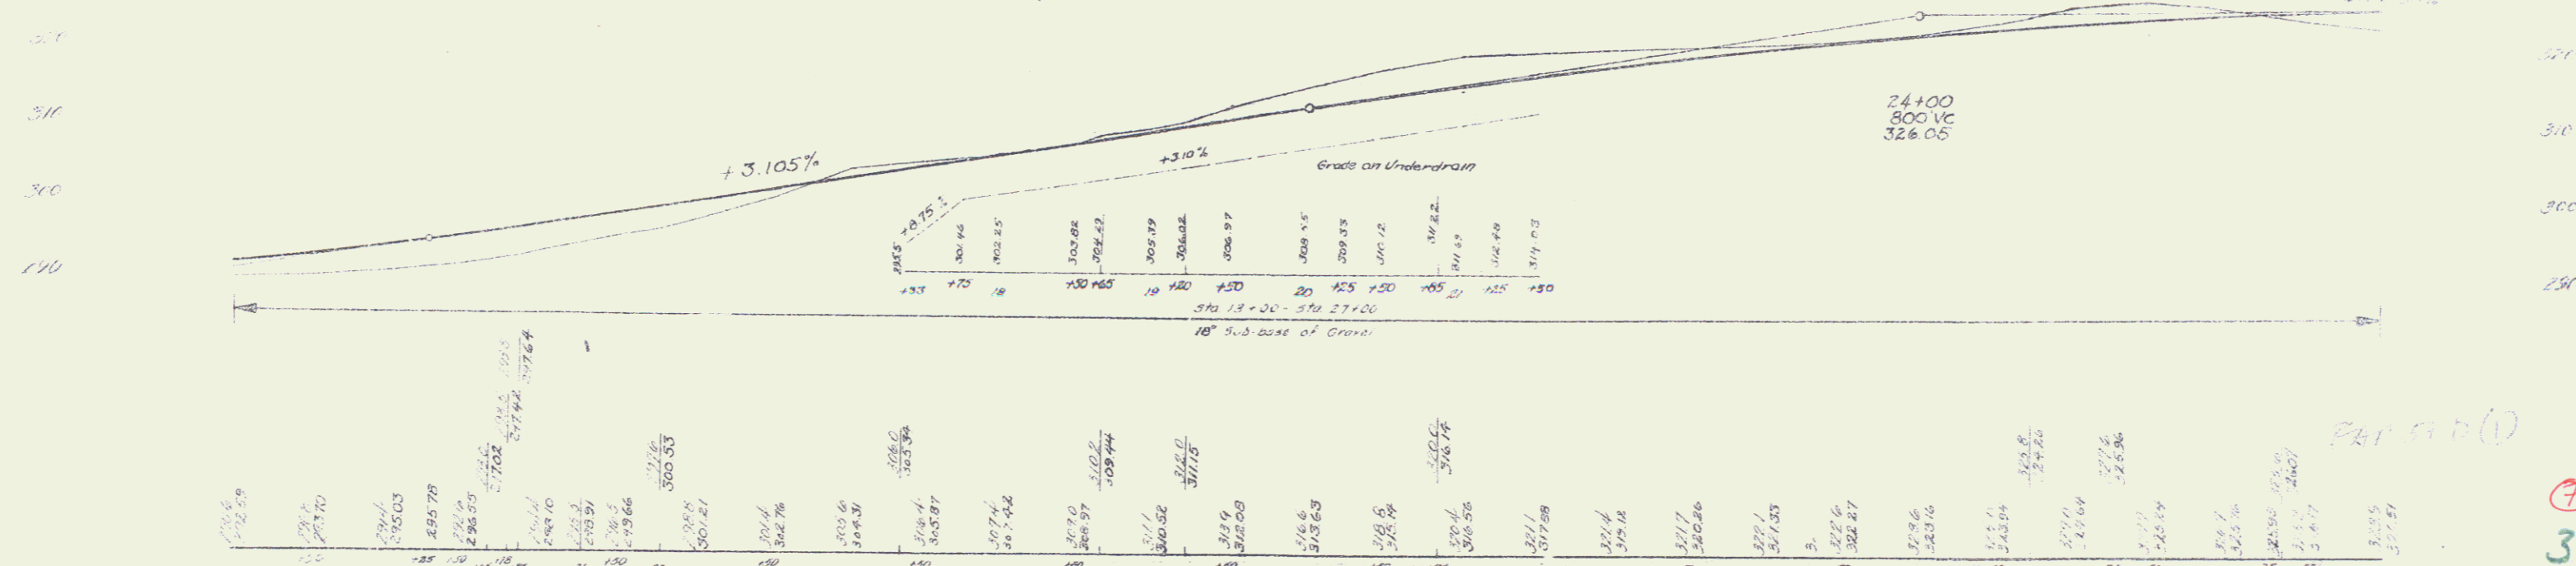

7  
3