


Margaret Bennett

PARCEL	INTRUMENT	DATE	GRANTOR	GRANTEE	RECORDED	REMARKS
A, B	W.D.C.	1-25-45	MARGARET BENNETT	JT OF VT	82 36	2-23-45
D	W.D.C.	12-28-45	L.C. & G.R. THOMAS	JT OF VT	82 519	1-11-46

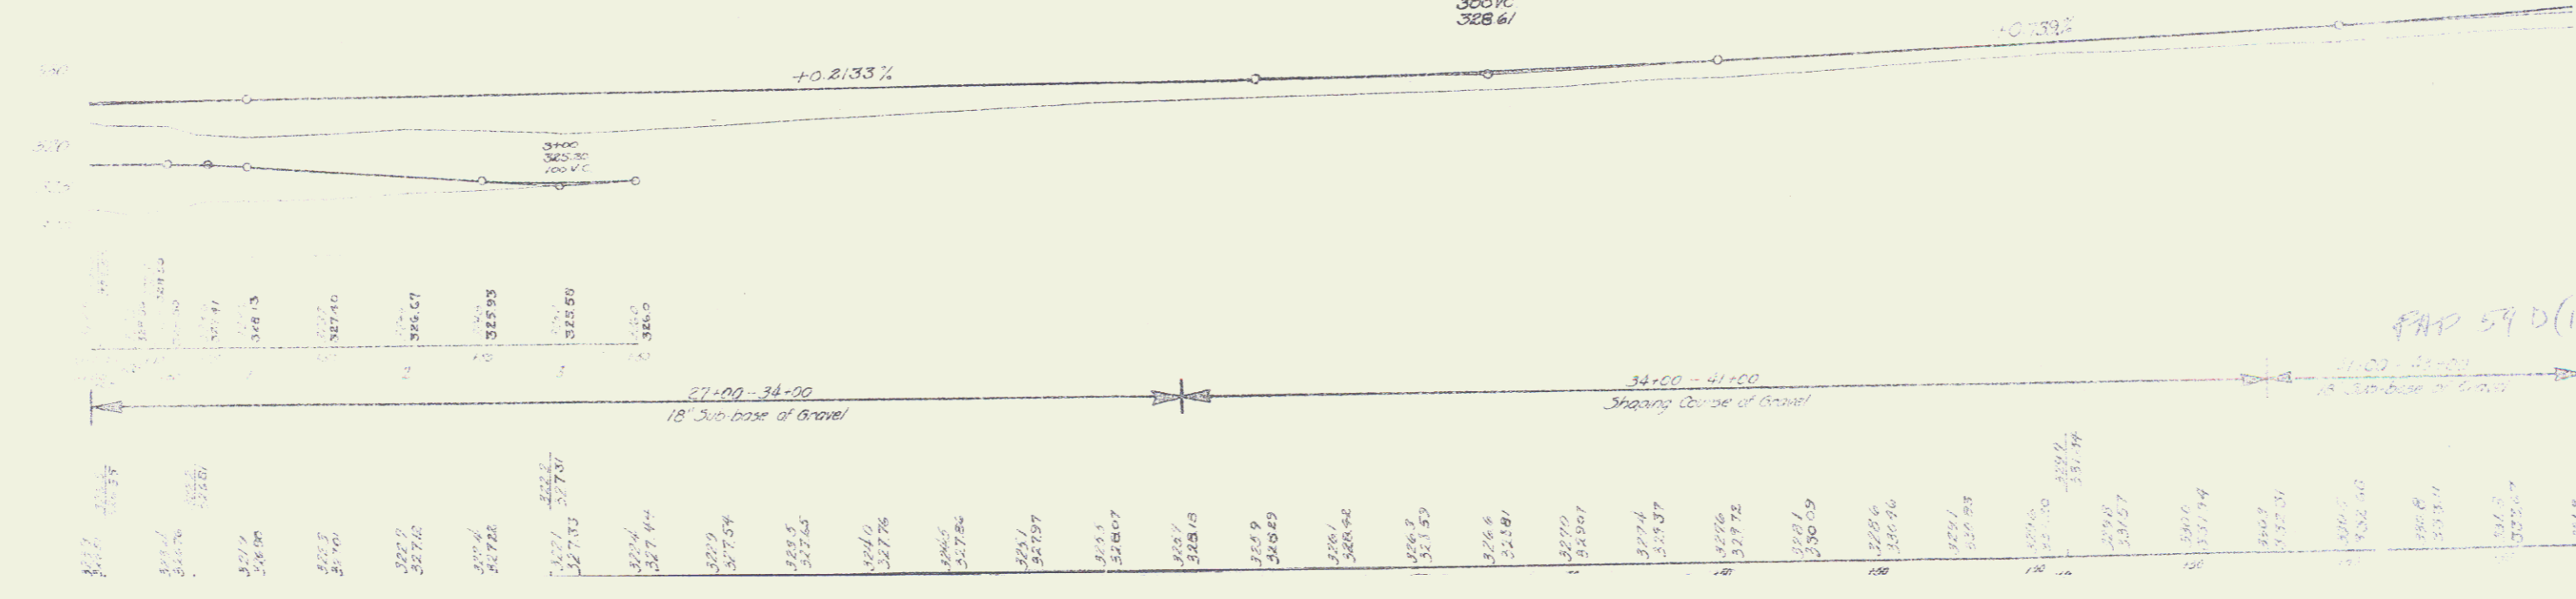

FAD 59 D(1)