

INDEX OF SHEETS

SHEET NO. 1	TITLE PAGE
2	TYPICAL CROSS-SECTION OF IMPROVEMENT (7 ONE COURSE CEMENT CONCRETE PAVEMENT, ITEM )
3,4	CONCRETE PAVEMENT DETAILS (2 SHEETS) & BANKING AND WIDENING TABLES
6	PLAN AND PROFILE
7	STANDARD STRUCTURE SHEET S-28 PIPE CULVERTS
8	" " " " S-30 GUARD RAIL
9	" " " " S-30-A STD. UNDERDRAIN
10	" " " " S-40 BARRICADES, SIGNS, AND LIGHTS
11	" " " " S-41 ROUNDING OF CUT SLOPES
12-16	CROSS SECTIONS

STATE OF VERMONT  
STATE HIGHWAY DEPARTMENT


PLAN AND PROFILE OF PROPOSED  
STATE HIGHWAY  
FEDERAL AID PROJECT

TOWN OF DUMMERSTON  
ROUTE U.S. 5

BRATTLEBORO - BELLOWS FALLS ROAD  
BEGINNING AT THE BRATTLEBORO - DUMMERSTON TOWN LINE AND EXTENDING  
NORTHERLY 0.220 MILES ON ROUTE U.S. 5


LENGTH OF PROJECT  
1162.9 FT = 0.220 MILES

FED. ROAD DIST. NO.	STATE	FED. AID PROJ. NO.	FISCAL YEAR	SHEET NO.	TOTAL SHEETS
9	Vt.	4(4)		1	16

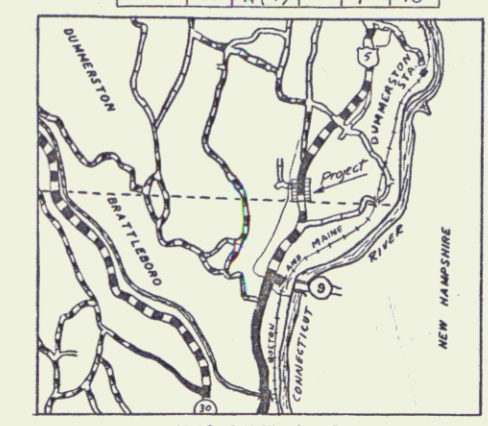

SCALE: 1 INCH = 1 MILE

RIGHT-OF-WAY DIVISION  
TOWN FILE  
PERPETUAL  
Town of U.S. 5  
(To Be Returned To R.O.W. Division)

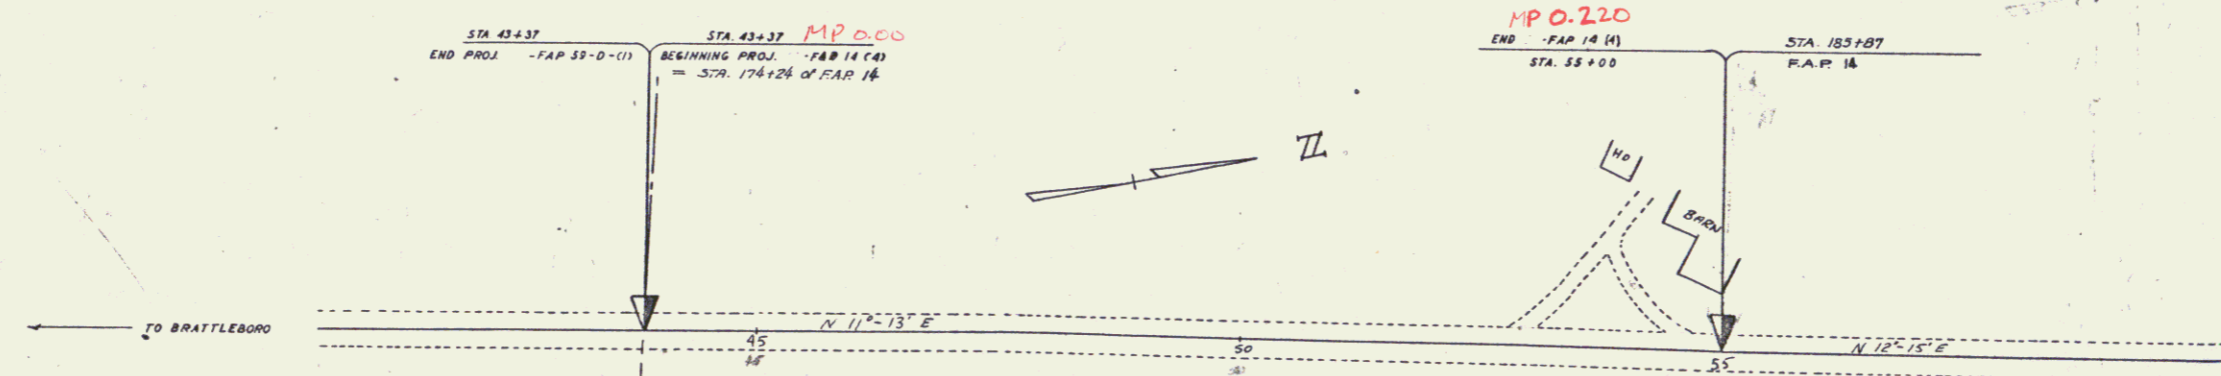

PROJECT NO.	14(4)
PROJECT NAME	BRATTLEBORO - BELLOWS FALLS ROAD
CONTRACTOR	
DESIGNER	
DATE	
SCALE	
PROJECT NUMBER	
LENGTH	
DATE	
SCALE	
PROJECT NUMBER	
LENGTH	
DATE	
SCALE	

GROUND ELEVATION	DATUM	LINE
GRADE ELEVATION	DATUM	LINE

CURVE DATA

DEFLECTION ANGLE	Δ
DEGREE OF CURVE	D
RADIUS OF CURVE	R
TANGENT DISTANCE	T
LENGTH OF CURVE	L
EXTERNAL DISTANCE	E
POINT OF INTERSECTION	P. I.
POINT OF CURVE	P. C.
POINT OF TANGENT	P. T.
POINT ON TANGENT	P. O. T.

SCALES

TITLE	1" = 100'
TYPICAL	1" = 100'
PLAN	1" = 50'
HORIZONTAL	1" = 50'
PROFILE VERTICAL	1" = 10'
CROSS SECTIONS	1" = 5'

THESE PLANS ARE SUBJECT TO SUCH REVISIONS AS MAY BE REQUIRED BY THE PUBLIC ROADS ADMINISTRATION OR THE COMMISSIONER OF HIGHWAYS.

CONSTRUCTION IS TO BE CARRIED ON IN ACCORDANCE WITH THE PLANS AND THE STANDARD ROAD AND BRIDGE SPECIFICATIONS OF 1936, AS APPROVED DECEMBER 29TH, 1936 BY THE PUBLIC ROADS ADMINISTRATION, INCLUDING ALL SUBSEQUENT APPROVED REVISIONS AND SUCH REVISED SPECIFICATIONS AND SPECIAL PROVISIONS AS ARE SUBMITTED WITH THE PLANS.

RECOMMENDED FOR APPROVAL

DISTRICT ENGINEER  
PUBLIC ROADS ADMINISTRATION  
FEDERAL WORKS AGENCY

APPROVED

DISTRICT ENGINEER  
PUBLIC ROADS ADMINISTRATION  
FEDERAL WORKS AGENCY

APPROVED *[Signature]*  
ROAD ENGINEER

APPROVED *[Signature]*  
DISTRICT HIGHWAY COMMISSIONER

SERIES Project  
SHEET 1 OF 16