


TOWN OF DUMMERSTON
 Pin # 99R 253 6/3/1981
 Route US 5
 Project # WPGS 214A


STA 50+00 MP 0.126
 STA 77+00 MP 0.637

PARCEL	INSTRUMENT	DATE	GRANTOR	GRANTEE	RECORDED	REMARKS
A	W.D.	7-7-36	MAUDE CROSBY	STOFFT	26	179 7-8-36
A'	W.D.	11-11-36	MRS. WALTER MURPHY	"	26	196 11-16-36
A''	O.C.D.	8-28-37	E.A. DRURY & L.H. NEUBATEN	"	26	234 8-14-37

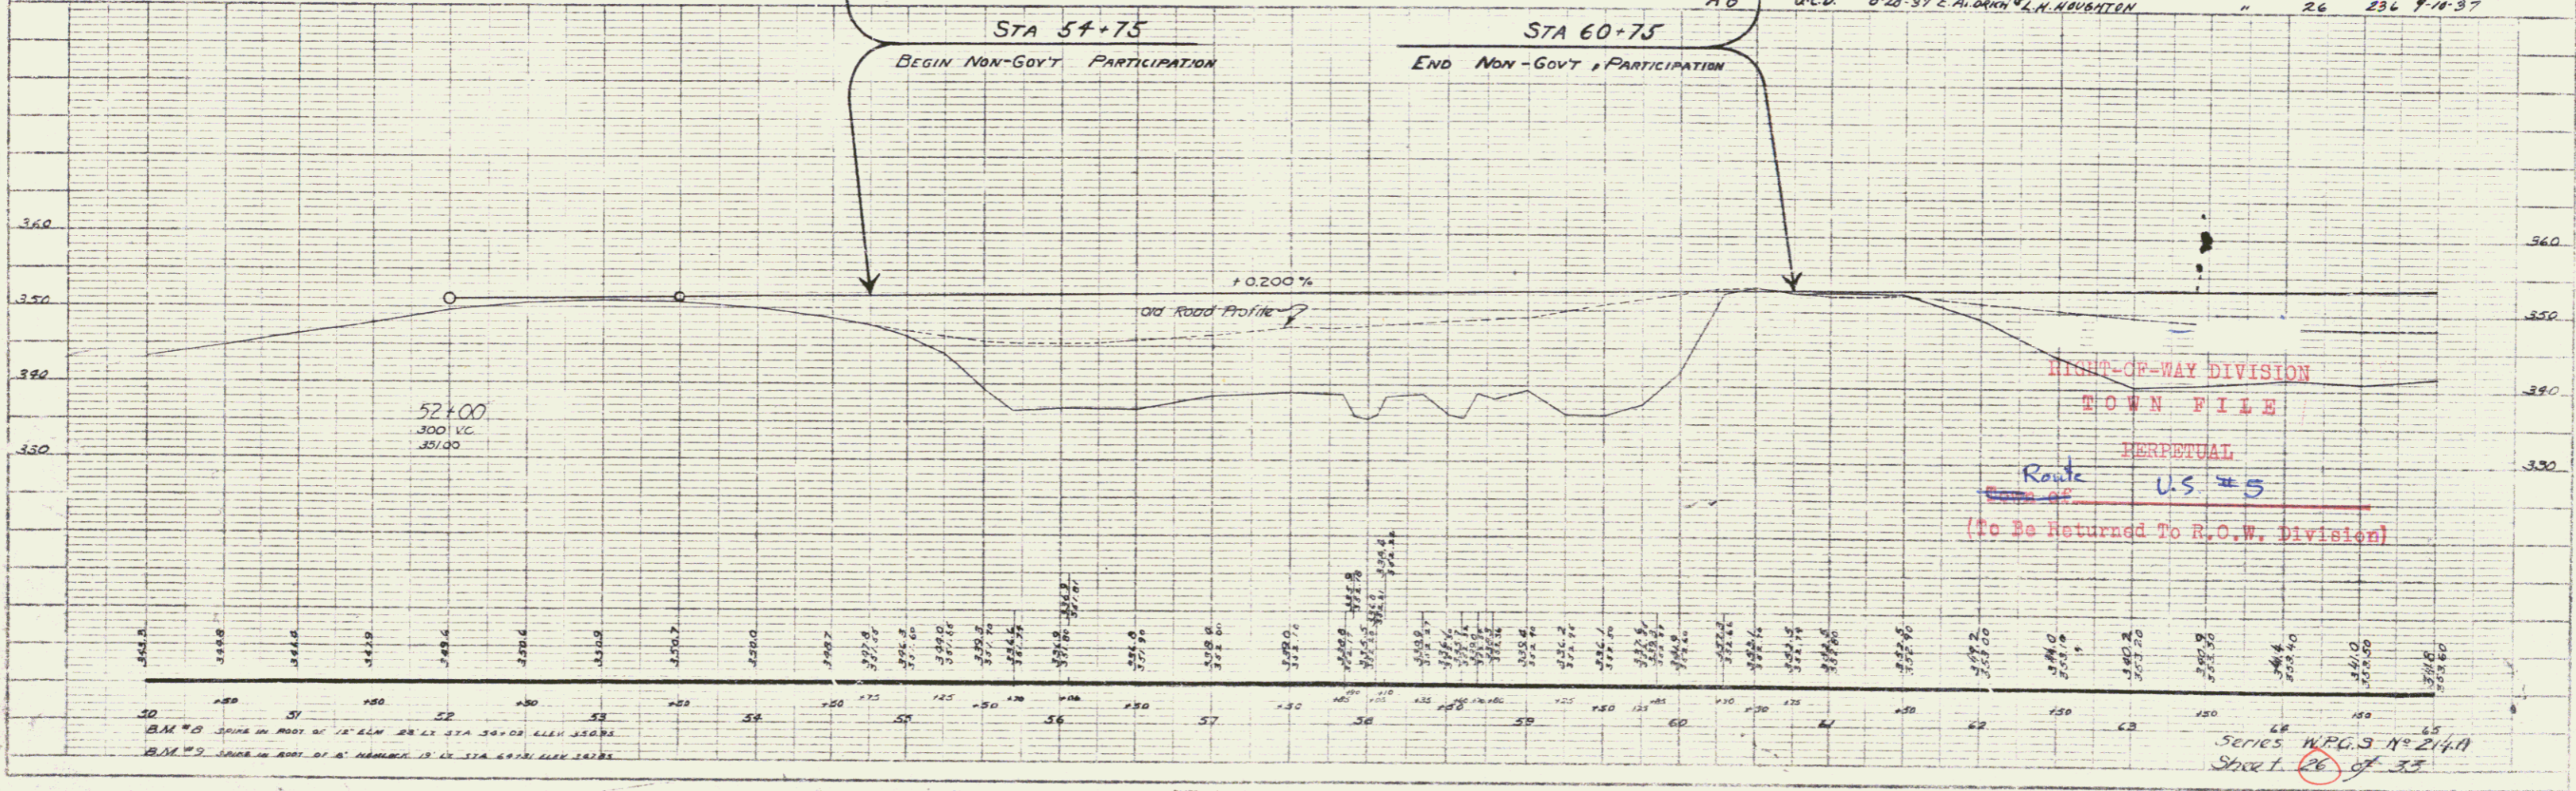


PLAN
 DATE 6/3/81
 BY [Signature]

PROFILE
 DATE 6/3/81
 BY [Signature]

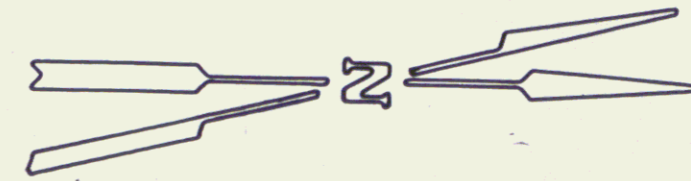


STA 60+00
MP 0.126

STA 77+00
MP 0.637

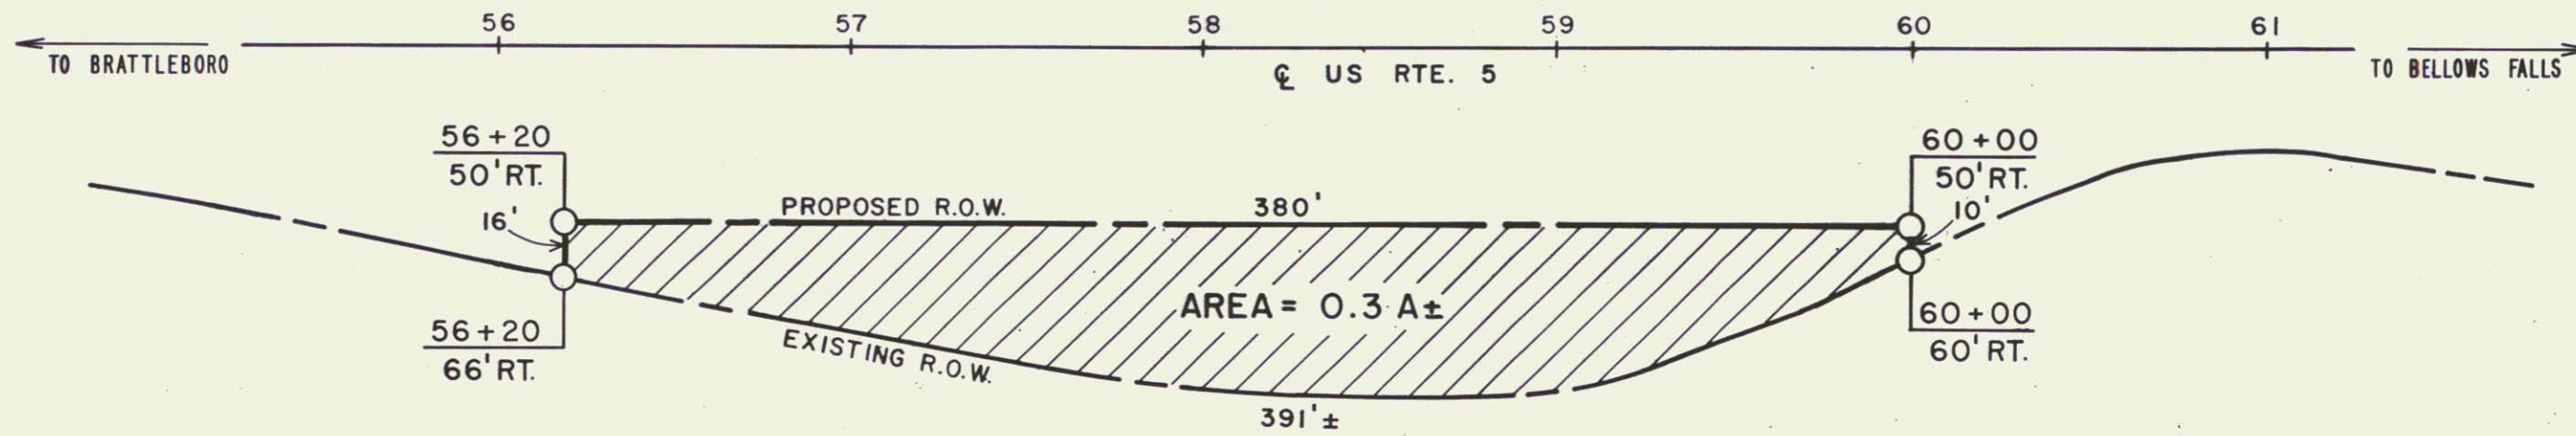

STATE OF VERMONT TO TRI.-STATE AUTOMOTIVE WAREHOUSE, INC.
By Q.C.D. on 6/16/81; DUMMERSTON L.R. BK 17/87
MP

mz 7/8/80

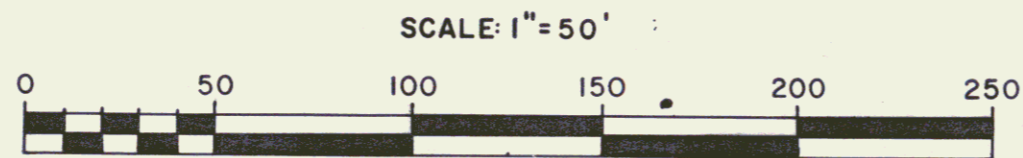

REF. SHEET NO. 26 OF 33		
STATE OF VERMONT AGENCY OF TRANSPORTATION (26A)		
TOWN OF DUMMERSTON		
PROJECT	WPGS 214A	
APPROX. SCALE 1" = 50'	DATE 6/3/81	DRAWN BY B.A.M.

