


PARCEL	INSTRUMENT	DATE	GRANTOR	GRANTEE	RECORDED	BOOK	PAGE	DATE	REMARKS
3	COND.	3-19-54	WILLIAM APPEL	STOFVT DUMMERSTON	35	4-9	3-22-54		See report and notice of hearing & Sheet 8
4	W.D.O.E.	5-10-54	SUSIE S. RIX	STOFVT DUMMERSTON	35	41	5-11-54		See also Sheet 8

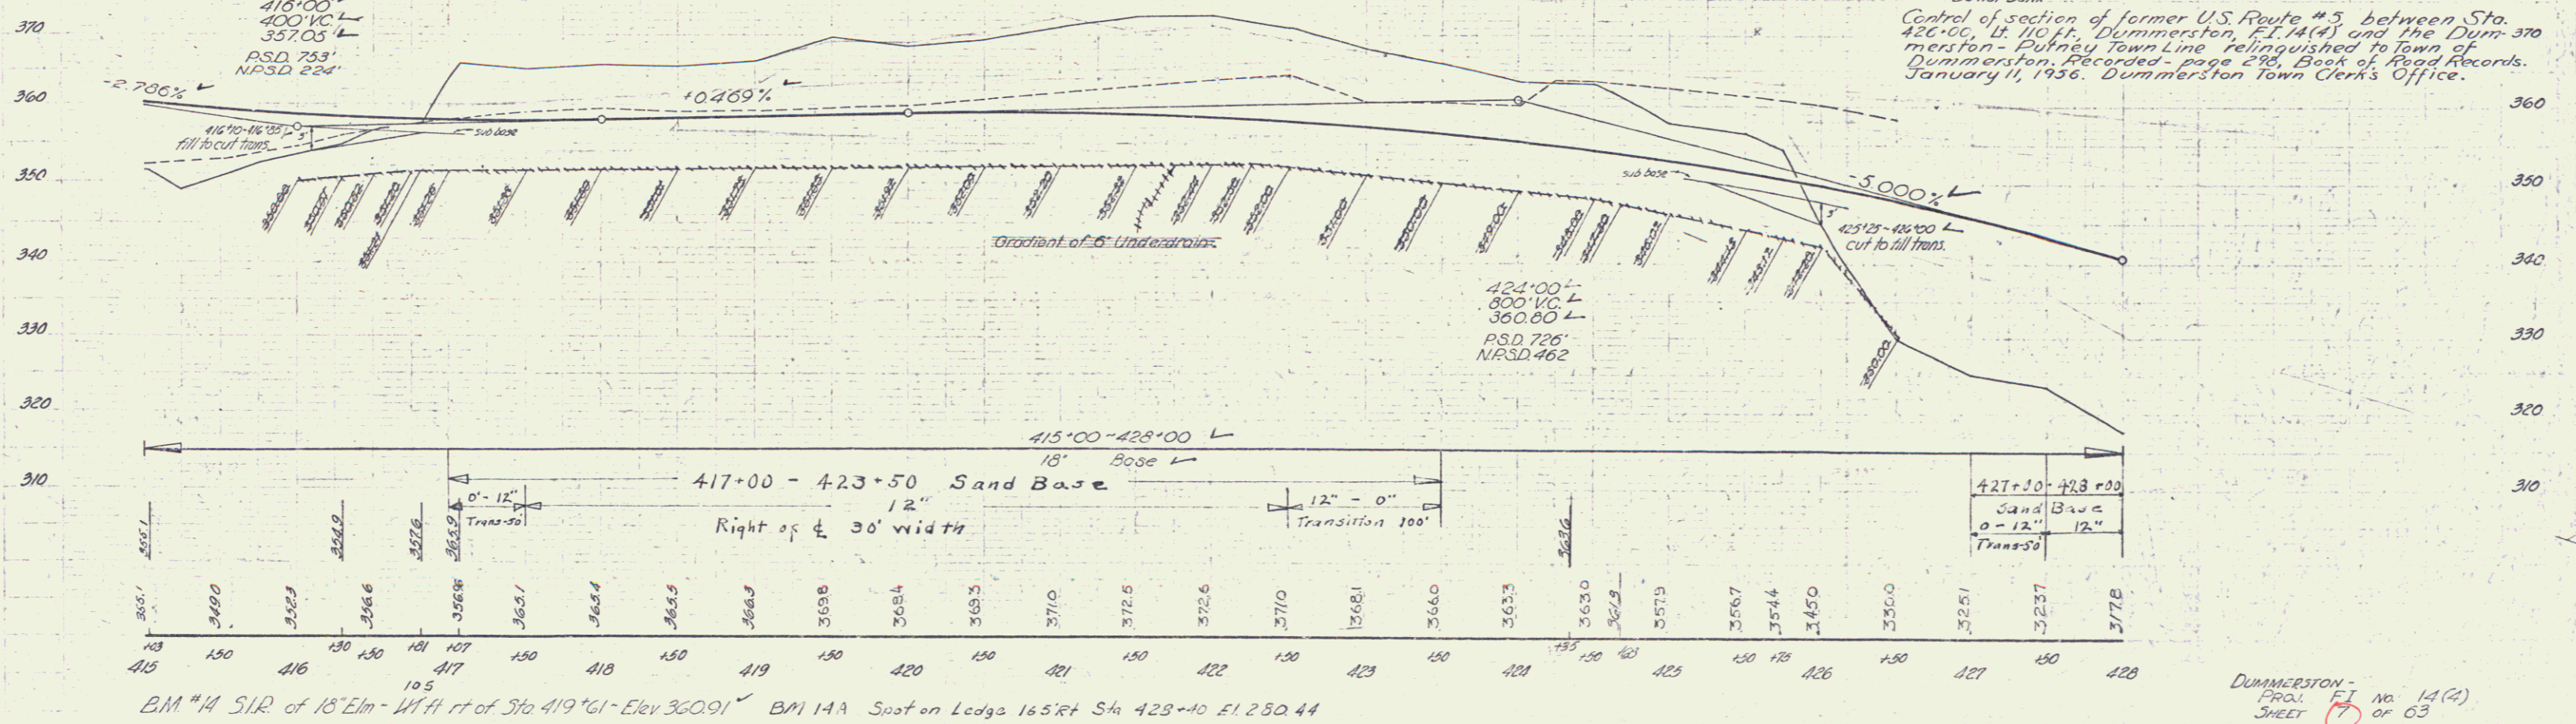

BM #14 S1R of 18' Elm - W 1/4 of Sta 419+61 - Elev 360.91' BM 14A Spot on ledge 165' Rt Sta 428+40 El. 250.44