



GEORGE E & ROMIE J. HOLT

PUTNEY

Δ	47°50' LT	PARCEL INSTRUMENT DATE	GRANTOR	GRANTEE RECORDED	Book Page	Date	REMARKS
D	3°30' L	7	TRUSTEE'S DEED 6-3-54	ELLEN M WILLARD ESTATE STORVE PUTNEY	33 3740	6-9-54	see also sheet 12. Hwy Proj. FI14(4) Dummerston
R	1637.3						
T	726.0						
L	1366.7						
E	153.8						
							Bank 1/2 per ft

PLAN
SCALE
DATE
BY
CHECKED BY
APPROVED BY

PROFILE
SCALE
DATE
BY
CHECKED BY
APPROVED BY

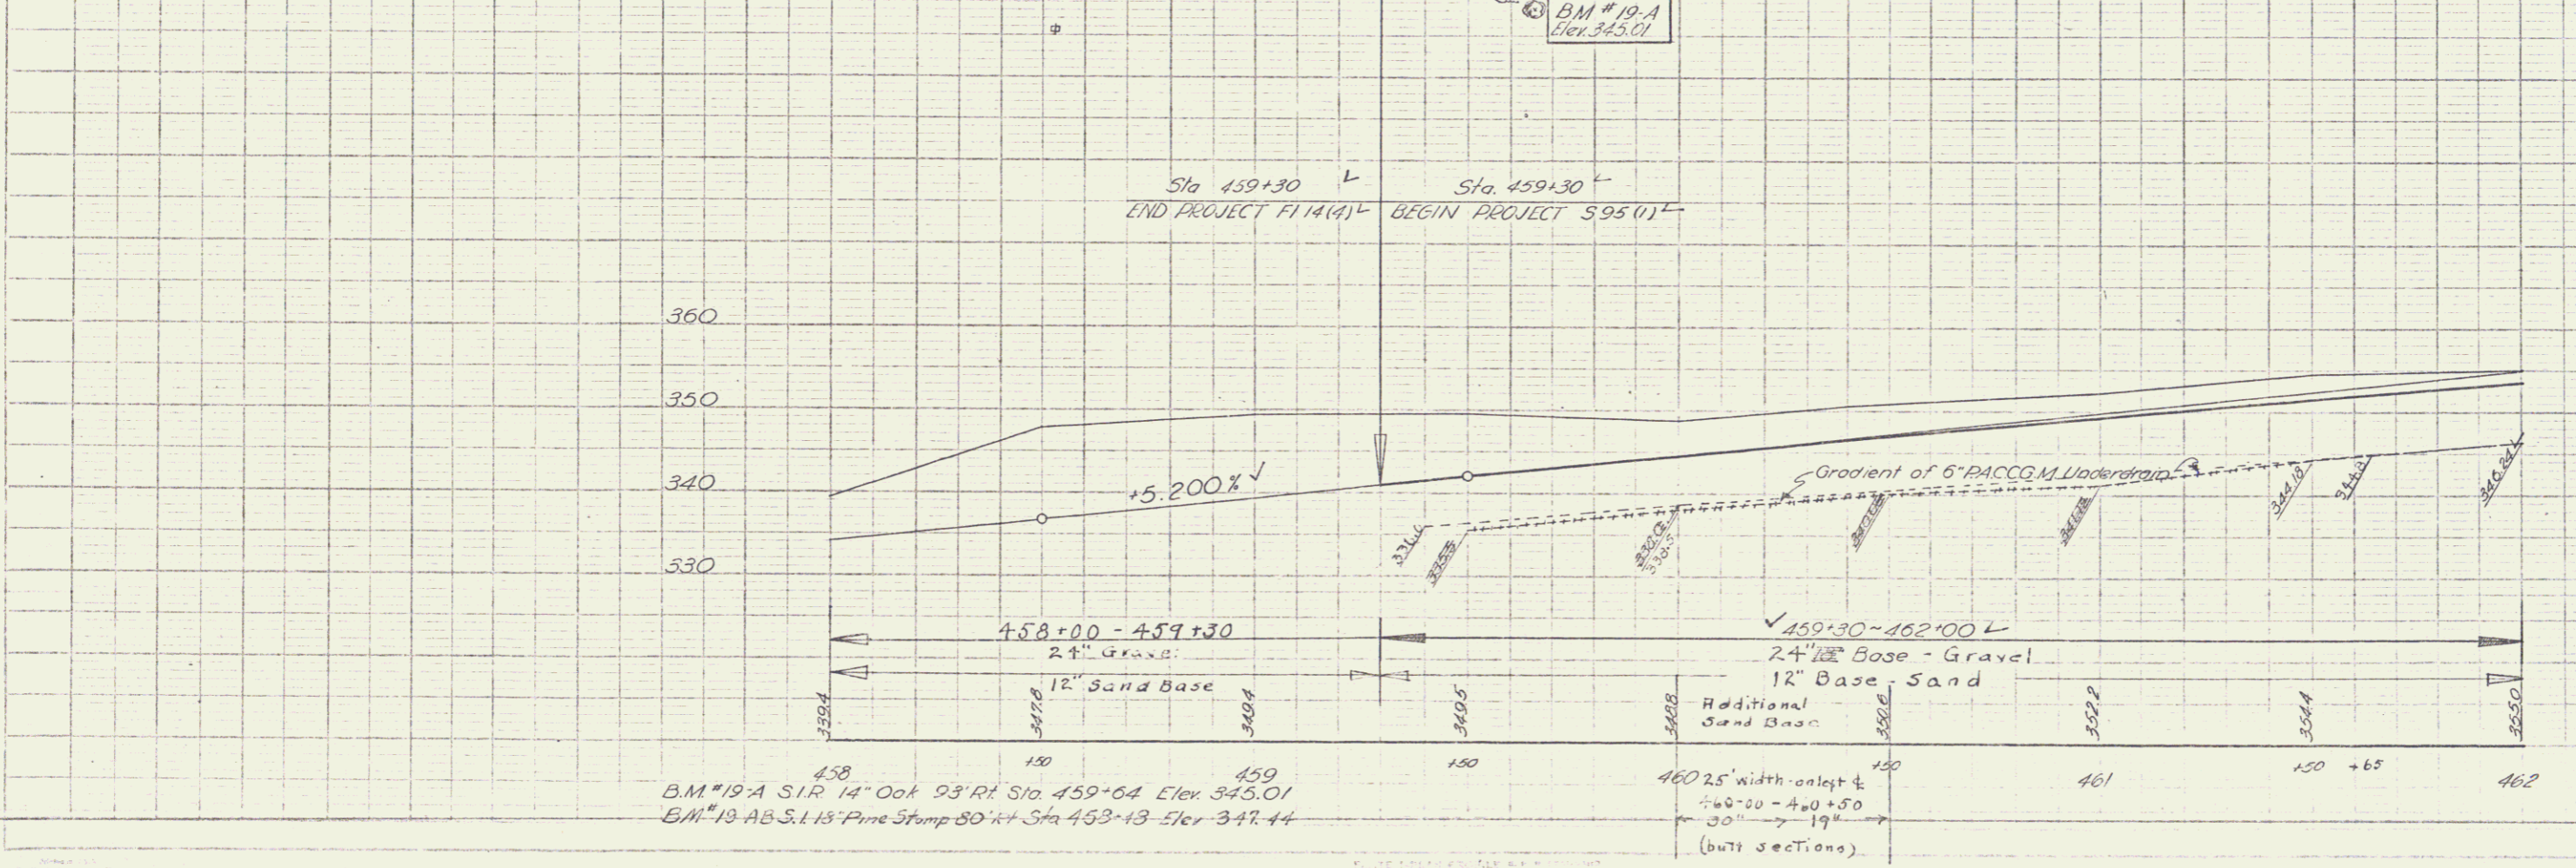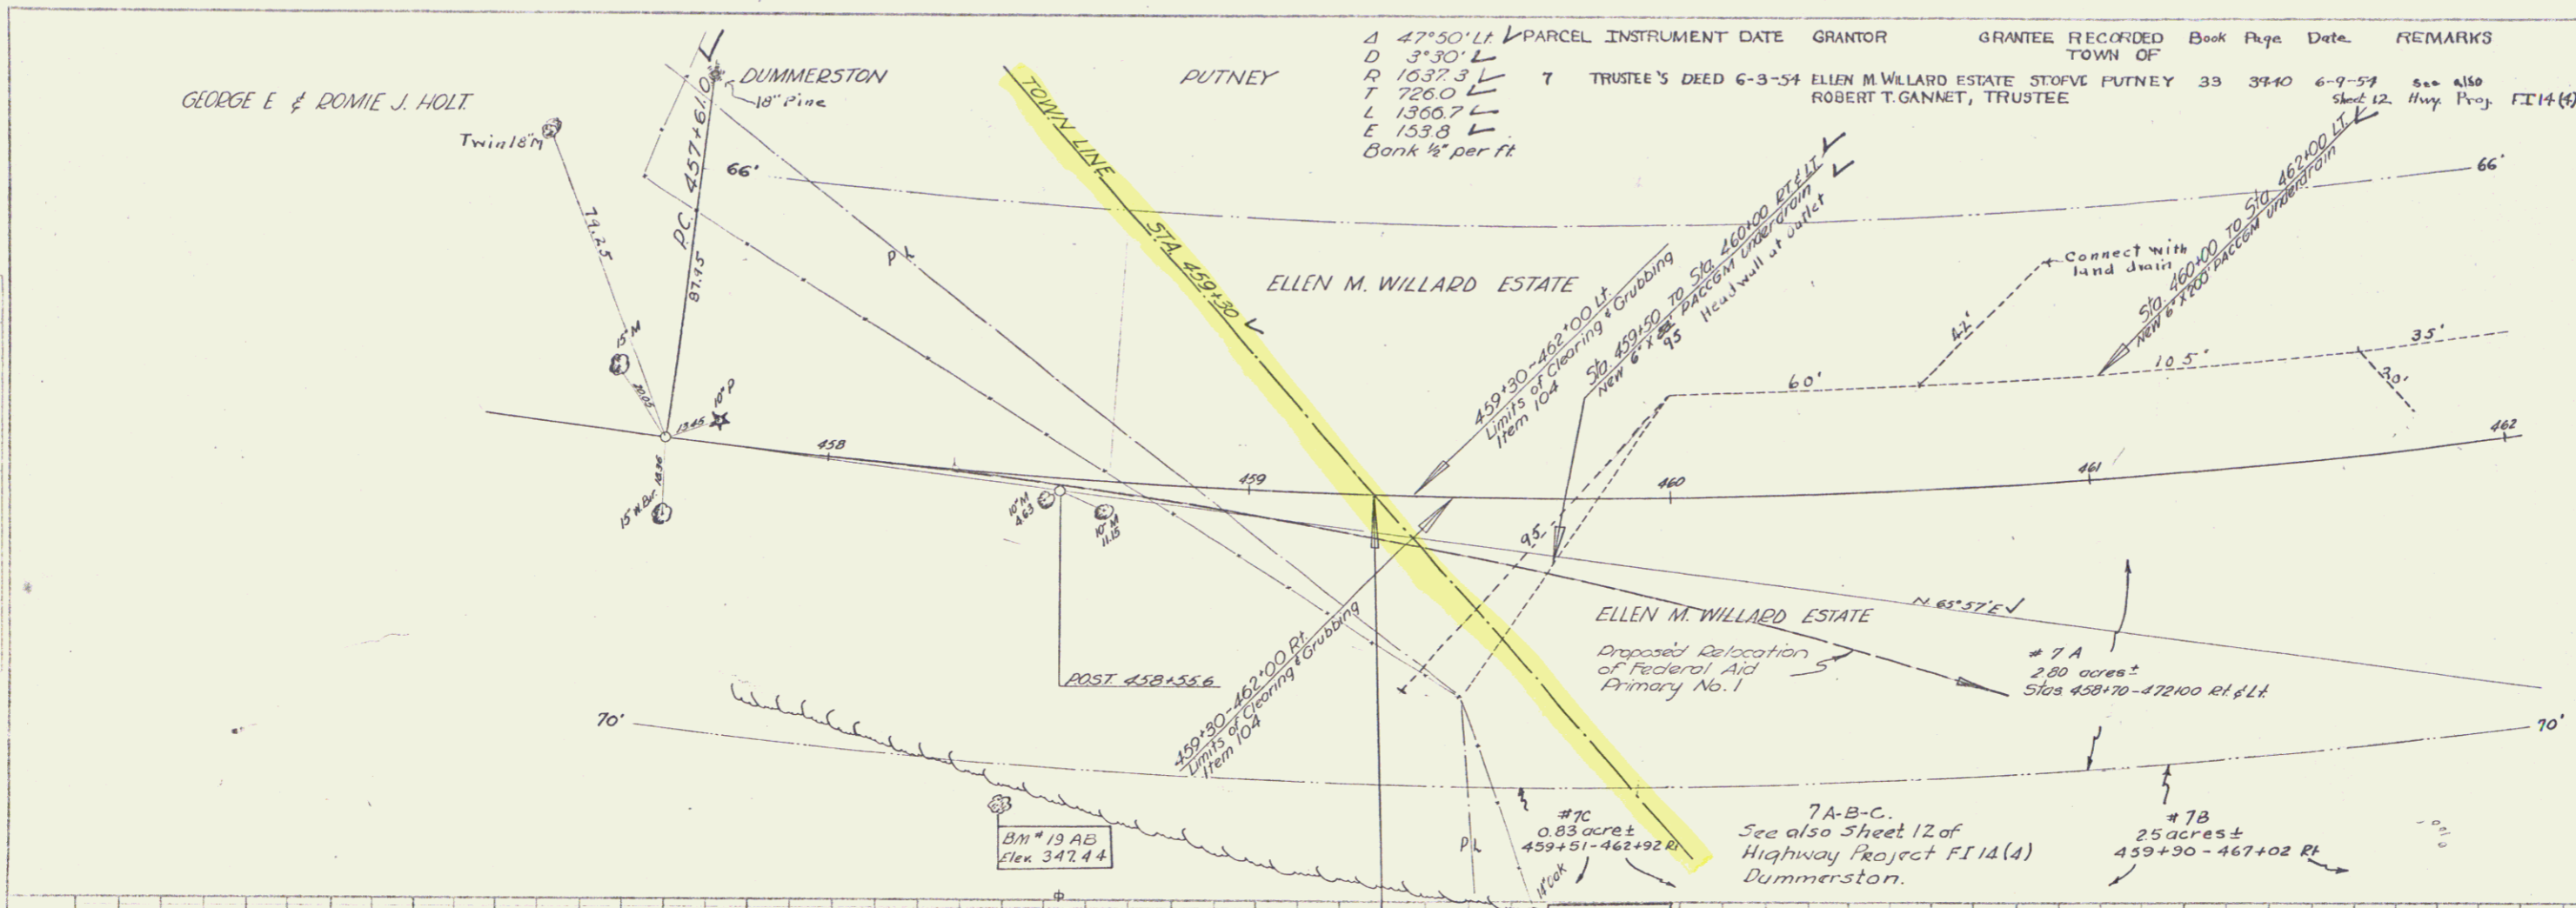

PUTNEY
Project 5, no 95(1)
Sheet 2 of 50