


NON GOVT PARTICIPATION 489'75
Install sleeve for water pipe across roadway. Item 103-A

CONSTRUCT DRIVES
Right
Left
487+28
488+00
488+62
489+00
489+32

CONSTRUCT APPROACH
488+61 R/L
489+15 L/L

A-17702E
11'10" LT
D-17706
7-17702E 12+5
L-17702E 2+3.1
E-6.2

CLAUDE

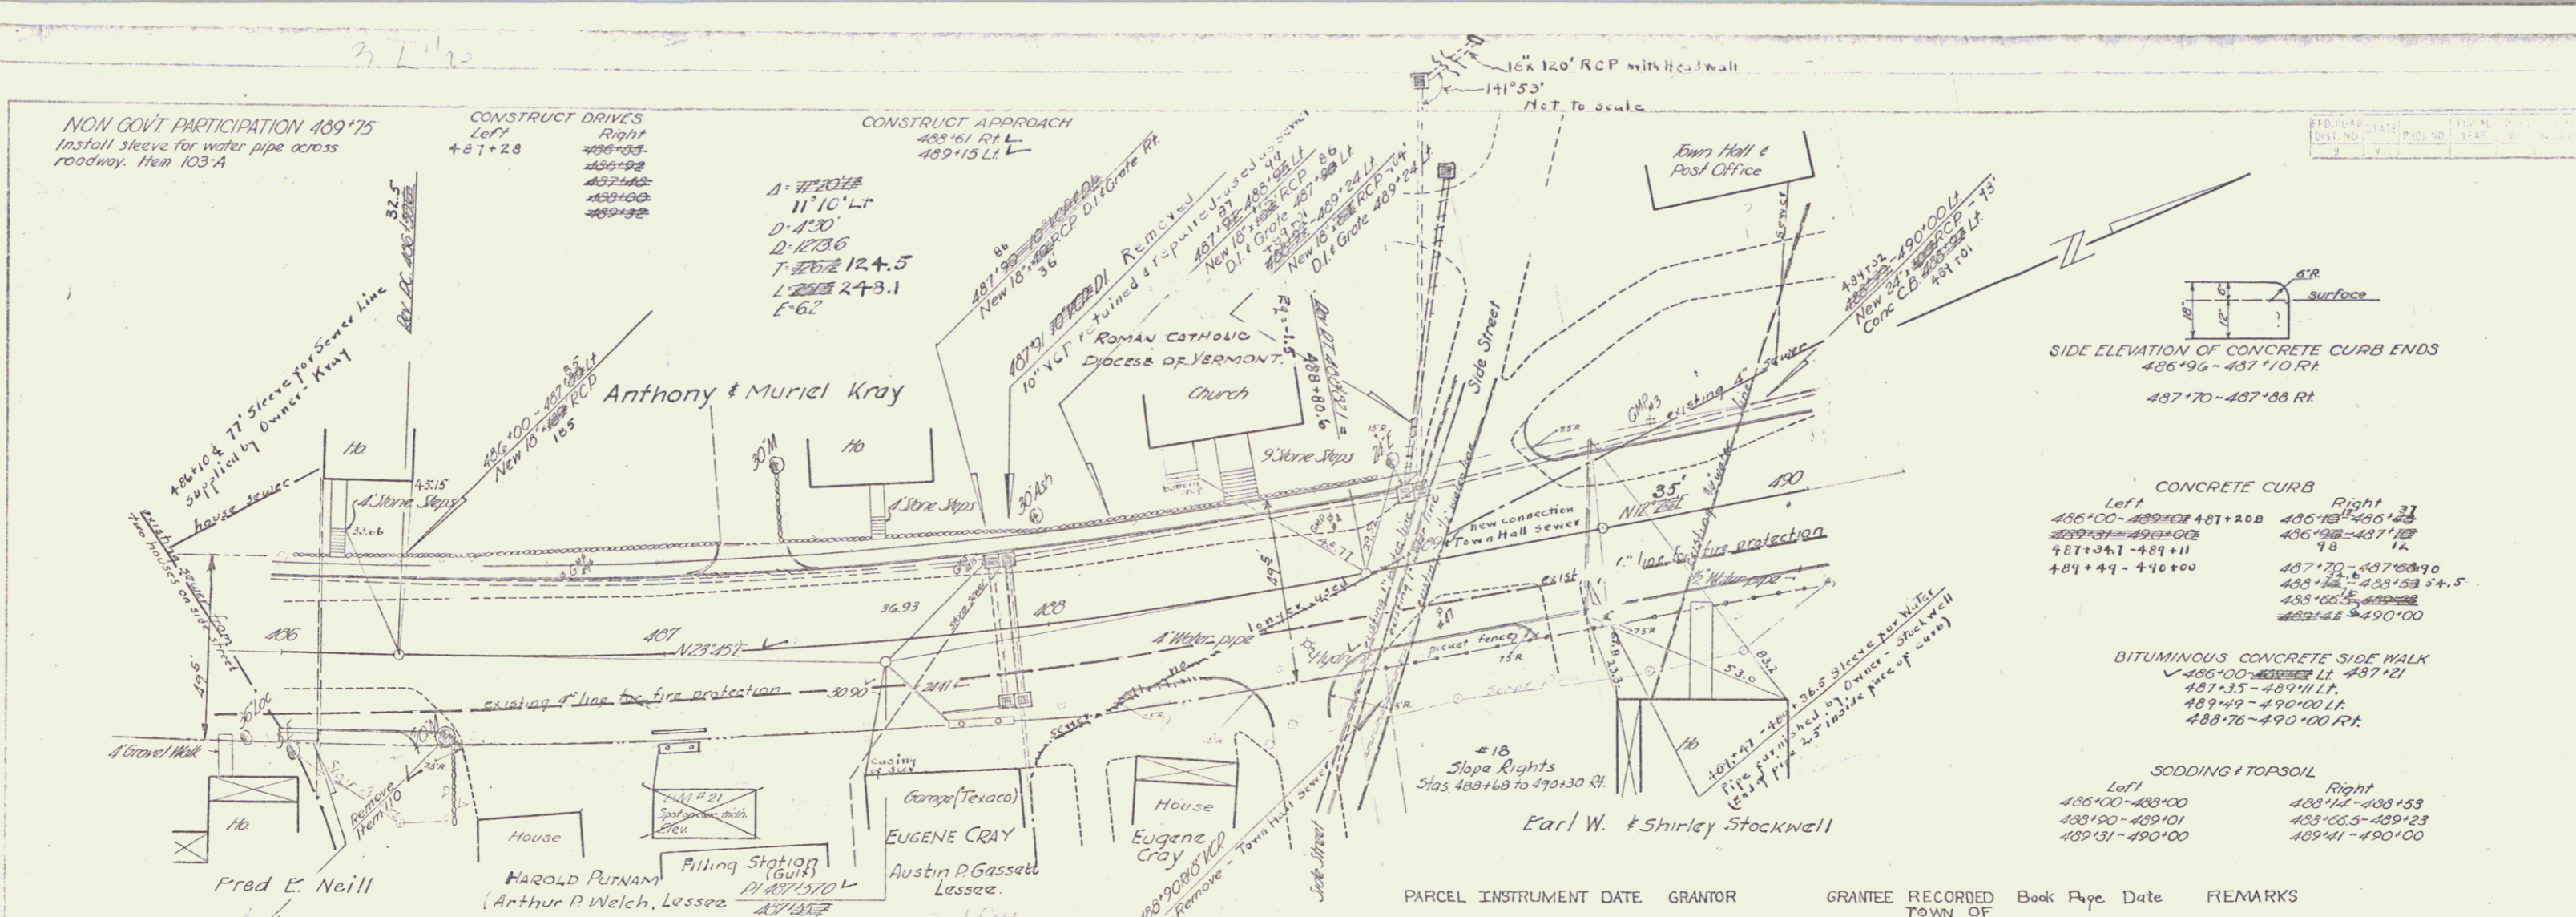




SIDE ELEVATION OF CONCRETE CURB ENDS
486+96 - 487+10 RT
487+70 - 487+88 RT

CONCRETE CURB
Left Right
486+00 - 487+28 486+37 - 487+37
487+28 - 487+37 486+37 - 487+37
487+37 - 487+49 487+37 - 487+49
487+49 - 487+60 487+37 - 487+49

BITUMINOUS CONCRETE SIDE WALK
486+00 - 487+21 LT 487+21
487+35 - 489+11 LT
489+09 - 489+00 LT
488+76 - 489+00 RT

SCODDING & TOPSOIL
Left Right
486+00 - 488+00 488+14 - 488+53
488+00 - 489+01 488+53 - 489+23
489+31 - 490+00 489+41 - 490+00

PARCEL INSTRUMENT DATE	GRANTOR	GRANTEE	RECORDED TOWN OF	Book	Page	Date	REMARKS
18	W.D.O.E.	EARL W. and SHIRLEY STOCKWELL	PUTNEY	33	3	5-14-54	See also Sheet 15

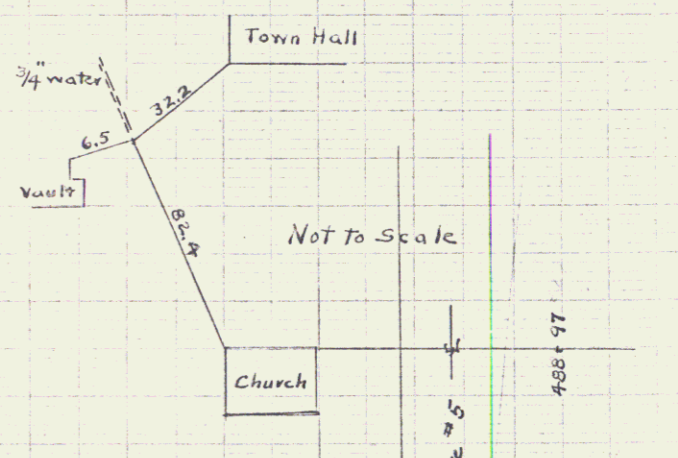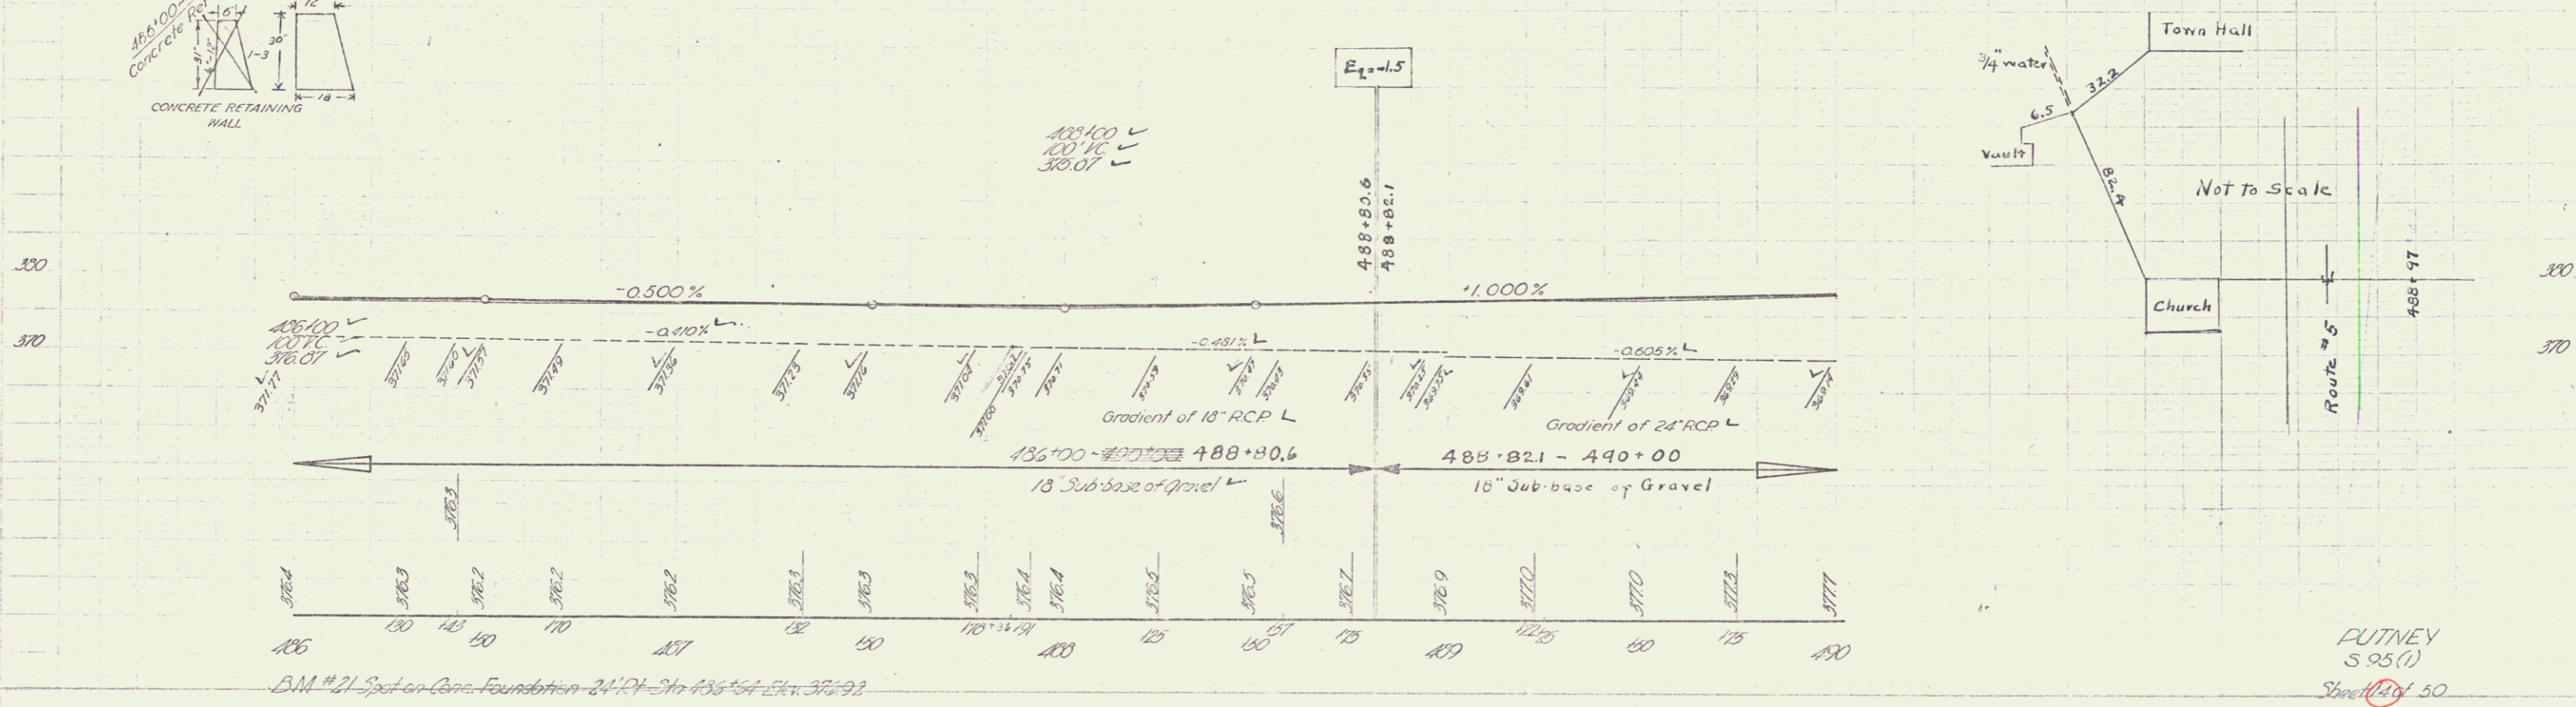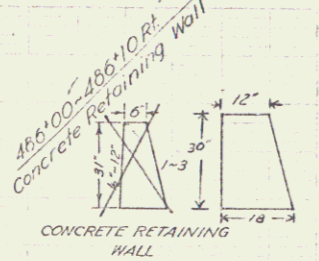

PUTNEY
S 95 (1)
Sheet 44 of 50