


NOTE: STA 13+50 RE. A' DIRECTED BY THE ENGINEER. OP'S TO BE CUT BACK AT APPROACH TO IMPROVE VISIBILITY. THIS WORK TO BE PAID FOR UNDER ITEMS 10 #10-11

PARCEL	INSTRUMENT	DATE	GRANTOR	GRANTEE	RECORDED	REMARKS
D-E	Q.C.D.	5-17-38	CHARLOTTE B. CLOGSTON	ST. OF VT.	BOOK PAGE DATE	
A	Q.C.D.	9-27-38	CHARLOTTE B. CLOGSTON	ST. OF VT.	18 168-9-170 5-24-38	18 10-3-38

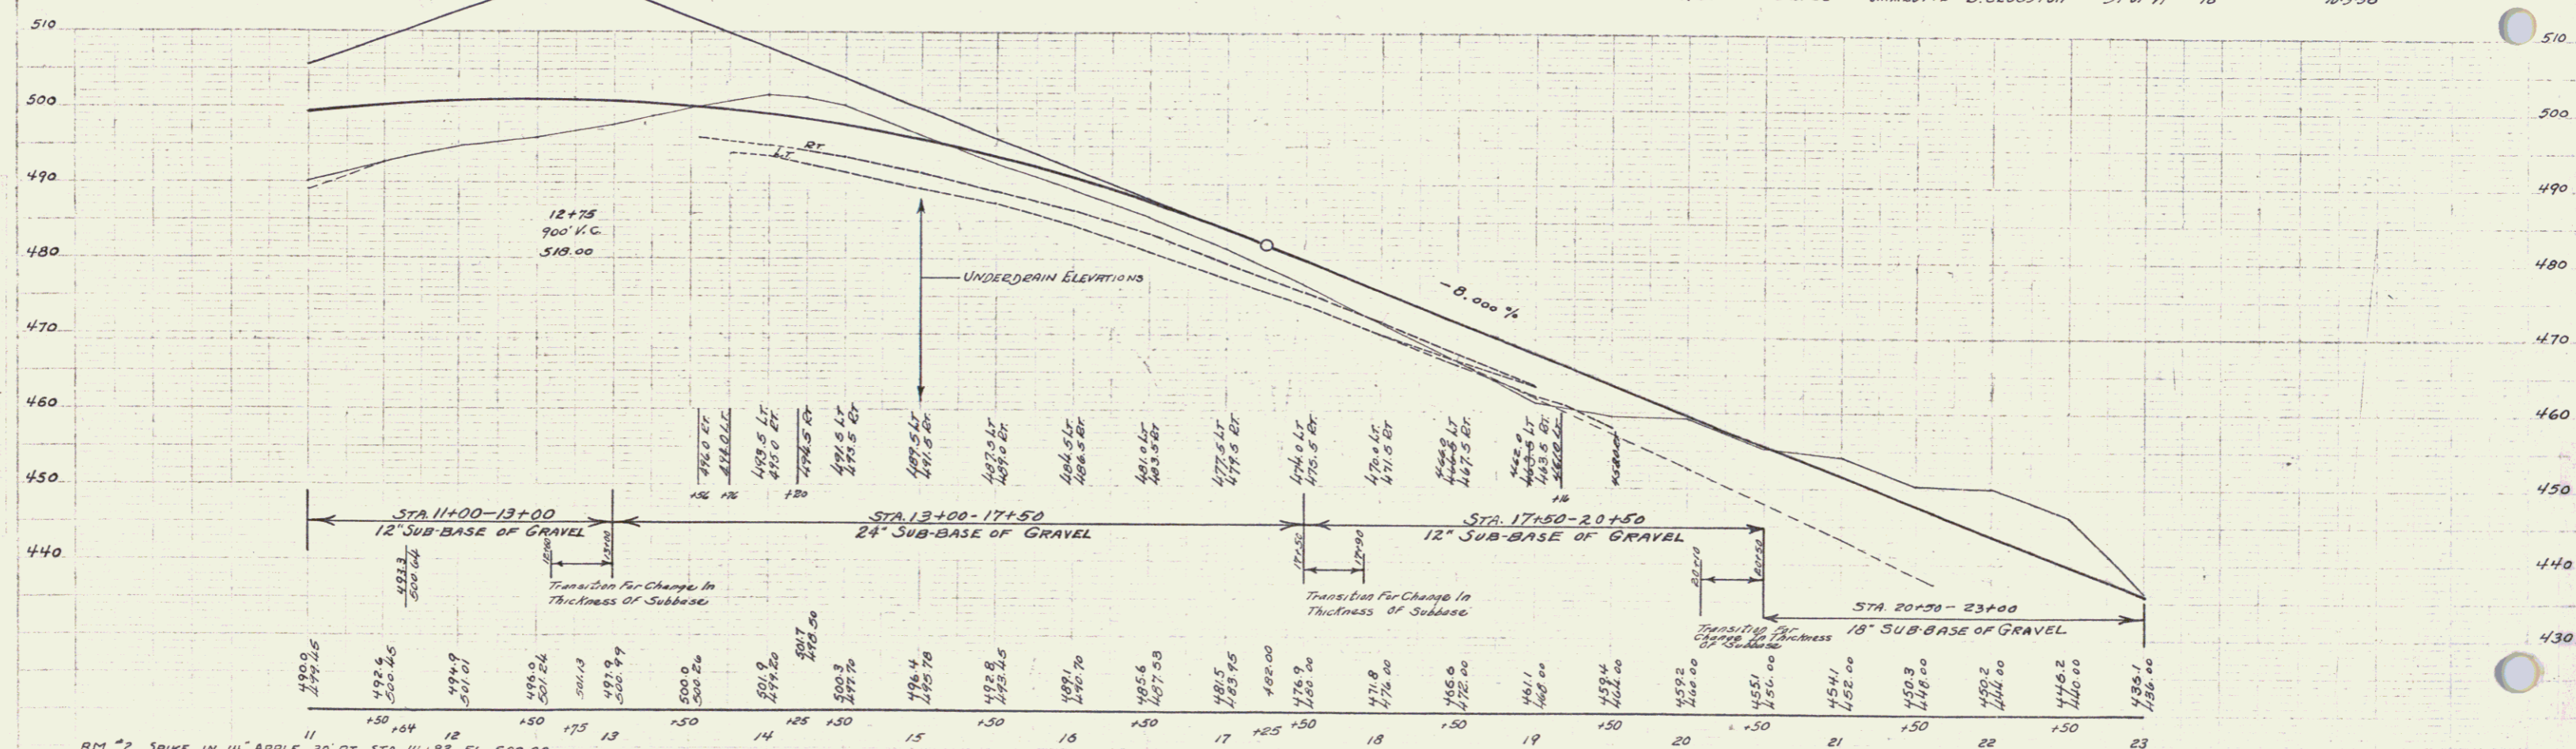

BM #2 SPIKE IN 14' APPLE 30' RT STA 14+02 EL 500.00
 BM #3 SPIKE IN ROOT 30' OAK 15' RT STA 20+40 EL 452.03