

**INDEX OF SHEETS**

1	Title Page
2	Typical Sheet
3	Item Quantity and Drainage Sheet
4	Earthwork Sheet
5-6	Layout and Profile Sheets
7	20 Scale Detail Sheet
8	Traffic Sign Location Sheet
9	Traffic Sign Summary Sheet
10	Traffic Sign Construction Details
11	Traffic Sign Assembly Details
12	Traffic Sign Support Details
13	Street Lighting (Underground System)
14	Blank
15	C-1 Slope Edging
16	C-1a Curbs
17	D-2 Headwalls
18	D-8 Drop Inlets
19	D-9 Drop Inlet Top
20	D-11 Grates
21	D-13 Catch Basin
22	E-11 Interstate Route Markers
23	E-12 U.S. Route Markers
24	E-14 Regulatory Signs
25	E-15 Regulatory Signs
26	E-16 Warning Signs
27	E-18 Guide Signs
28	E-20 Delineators and Hazard M.v.c.
29	E-22 Breakaway-Type Galvanized Sign Supp'rs
30	E-23 Yielding-Type Aluminum Sign F. Post
31	E-25 Standard Sign Placement
32	E-26 Standard Sign Placement
33	E-31 Federal Aid Construction Identification Signs
34	E-31 Concrete Bases and Pull Boxes
35	J-1 Project Markers
36	J-2 Standard Concrete Steps
37, A, B	Utility Construction Details
38-41	Cross Sections

For R.O.W. Details see R.O.W. Plans for this project.

**RECORD PLANS PAVT. AREA.**  
**MATERIALS 2,753 S.Y.**

SUBBASE OF GRAVEL—BATCHELDER PIT—FAIRLEE, VT.  
 PLANT MIXED BASE COURSE & BITUMINOUS CONCRETE—L.M. PIKE PLANT #604—W. LEBANON, N.H.  
 CONCRETE CLASS B—MILLER'S READY MIX CONCRETE, INC.—W. LEBANON, N.H.  
 REINFORCING STEEL—BANCROFT & MARTIN, INC.—S. PORTLAND, ME.  
 REINFORCED CONCRETE PIPE, GUARD RAIL & EROSION CONTROL ITEMS & TRAFFIC SIGNS—S.T. GRISWOLD & CO., INC.—WILLISTON, VT.  
 C.B. OR M.H. & C.I. GRATE—E.L. LEBARON FOUNDRY CO.—BROCKTON, MA.  
 GRANITE SLOPE EDGING & CURB—BARRETTO GRANITE CO.—MILFORD, N.H.  
 STREET LIGHTING—TRAFFIC ENGINEERING ASSOCIATES—NAUGATUCK, CT.

CONTRACTOR—S.V. ROSSI, INC.  
 TORRINGTON, CT.  
 RESIDENT ENGINEER—PRENTISS KARR.  
 INSPECTORS—S. MORRIS, L. TESSIER, A. STONE, L.  
 GRAHAM, B. FRESSETT & S. MURRAY.  
 RECORD PLANS—A.G. SPIDLE.

CONTRACT DATED—AUGUST 25, 1969.  
 STARTED—SEPTEMBER 2, 1969.  
 COMPLETED—JUNE 28, 1971.  
 ACCEPTED—JUNE 28, 1971.

**STATE OF VERMONT**  
**DEPARTMENT OF HIGHWAYS**

**PROPOSED IMPROVEMENT**



FEDERAL AID PROJECT

**TOWN OF FAIRLEE** Pin # 99R262  
**COUNTY OF ORANGE**  
**U.S. ROUTE 5 TO INTERSTATE I 91 CONNECTION**




BEGINNING AT A POINT 0.090 MILE WESTERLY OF U.S. ROUTE 5  
 AND EXTENDING EASTERLY 0.090 MILE TO U.S. ROUTE 5

LENGTH OF ROADWAY 476.46 FEET + 0.090 MILE  
 LENGTH OF PROJECT 476.46 FEET + 0.090 MILE

ADT	1970	2965
ADT	1990	5400
DHV	1990	890
D		57%
T		6%
V		40 MPH.

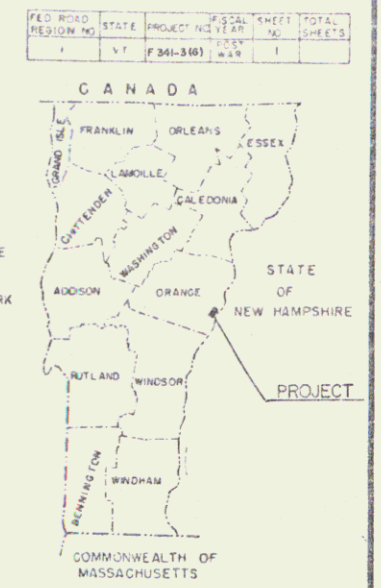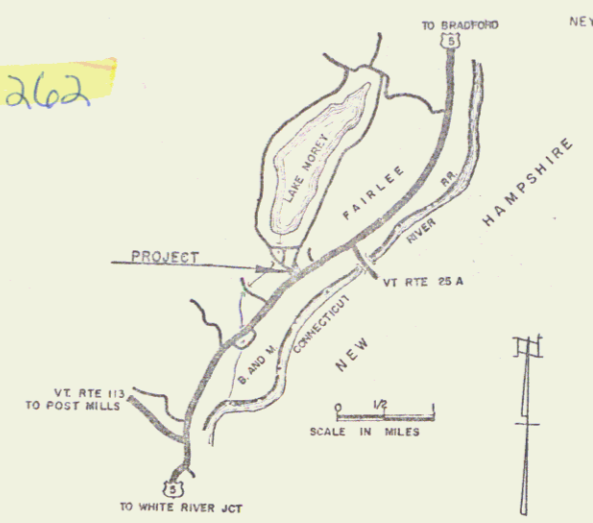

**CONVENTIONAL SIGNS**

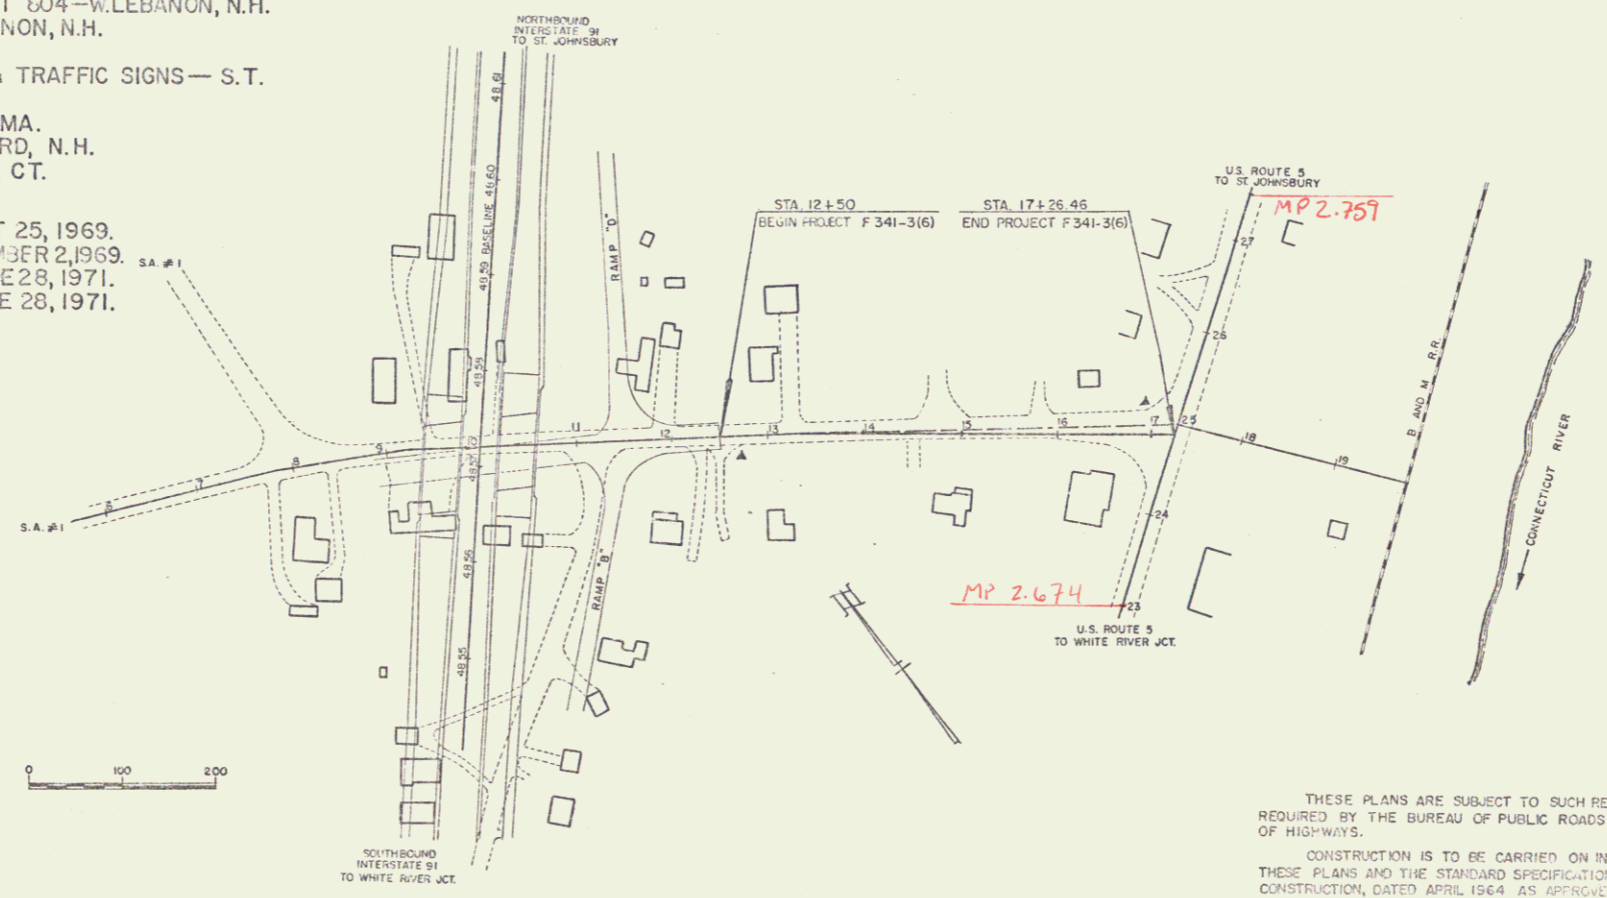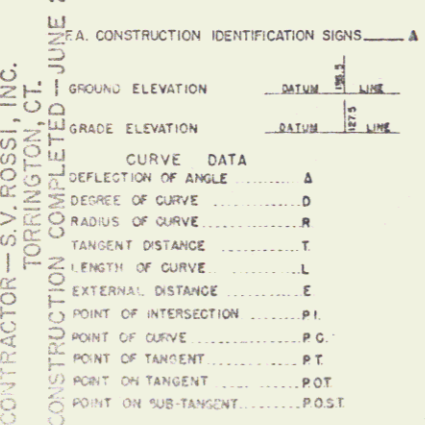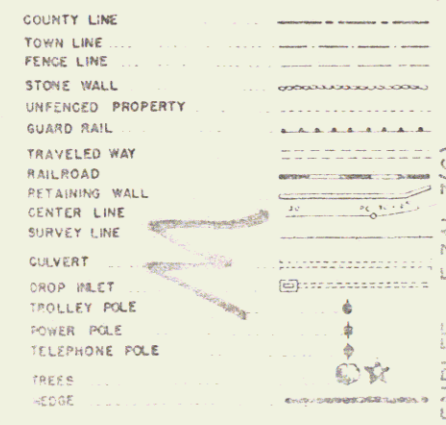

MP 2.7±  
 RIGHT-OF-WAY DIVISION  
 TOWN FILE  
 PERPETUAL  
 (To Be Returned To R.O.W. Division)  
 Town of  
 PERPETUAL  
 TOWN FILE  
 RIGHT-OF-WAY DIVISION

NOTE: ANY FURTHER INFORMATION CONCERNING FINAL QUANTITIES, AMOUNTS OR OTHER DETAILS RELATIVE TO THIS PROJECT MAY BE FOUND IN EITHER THE FIELD BOOKS OR THE ESTIMATE FILE.

SINGLE STAGE CONSTRUCTION  
 FAIRLEE

THESE PLANS ARE SUBJECT TO SUCH REVISIONS AS MAY BE REQUIRED BY THE BUREAU OF PUBLIC ROADS OR THE COMMISSIONER OF HIGHWAYS.  
 CONSTRUCTION IS TO BE CARRIED ON IN ACCORDANCE WITH THESE PLANS AND THE STANDARD SPECIFICATIONS FOR HIGHWAY AND BRIDGE CONSTRUCTION, DATED APRIL 1964 AS APPROVED BY THE BUREAU OF PUBLIC ROADS ON OCTOBER 12, 1964, INCLUDING ALL SUBSEQUENT APPROVED REVISIONS AND SUCH REVISED SPECIFICATIONS AND SPECIAL PROVISIONS AS ARE INCORPORATED IN THESE PLANS.

APPROVED DATE 6/25/65	APPROVED DATE 6/25/65	APPROVED DATE 6/25/65	APPROVED DATE 7/7/65	APPROVED DATE 6/25/65	APPROVED DATE 6/25/65
--------------------------	--------------------------	--------------------------	-------------------------	--------------------------	--------------------------

DEPARTMENT OF TRANSPORTATION  
 BUREAU OF PUBLIC ROADS

APPROVED

DIVISION ENGINEER DATE

PROJECT - F - NO. 341-3 (6)

SHEET 1 OF 41 SHEETS