


CULVERT REPAIR REQUIRED
 Sta. 1+50
 Concrete Headwall - Lower End 1/2, as yd.

FED. ROAD DIST. NO.	STATE	FED. AID PROJ. NO.	FISCAL YEAR	SHEET NO.	TOTAL SHEETS
0	VT	6	1952	3	20

Checked by
 Date
 Approved by
 Date

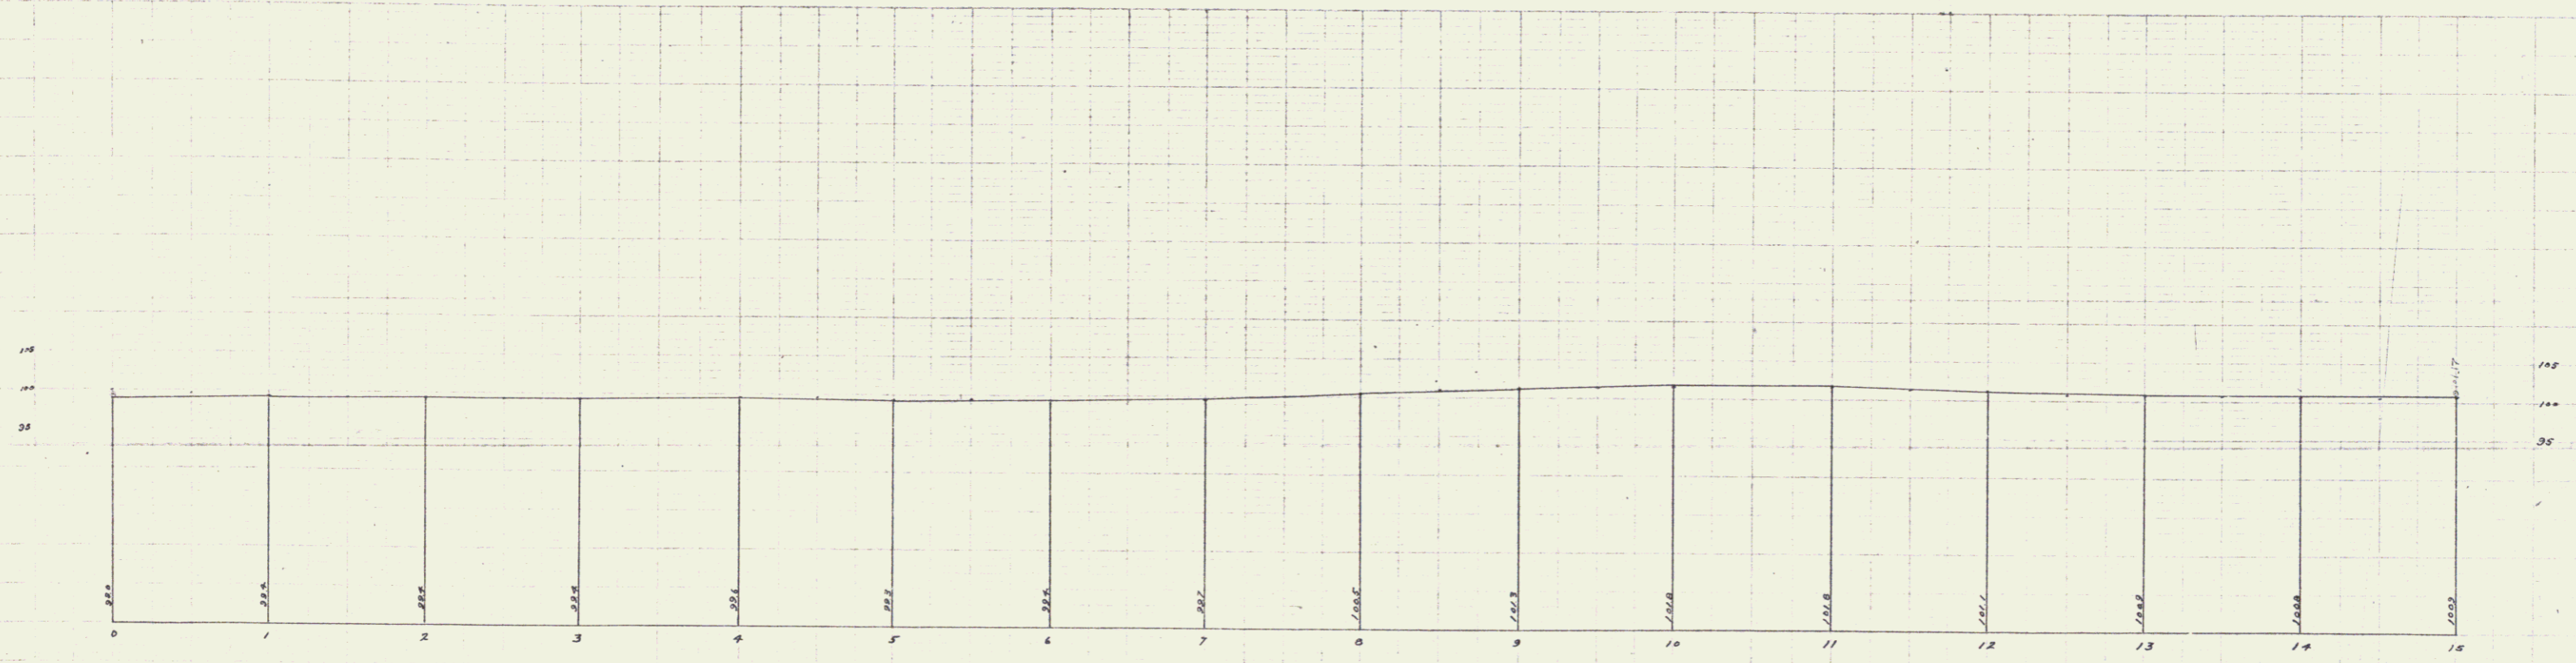

B.M. 5 - W. cor. of gasline platform of Garage E. I. 100.00 (Assumed)

Note - Sta. 0+00 to Sta. 25+75 to be resurfaced as per Section 24-3.3 shown on Sheet 2. Check then shoulers.

Sheet No. 6 of 20
 Date of 20