


FED. ROAD DIST. NO.	STATE	PROJ. NO.	FISCAL YEAR	SHEET NO.	TOTAL SHEETS
9	VT.				

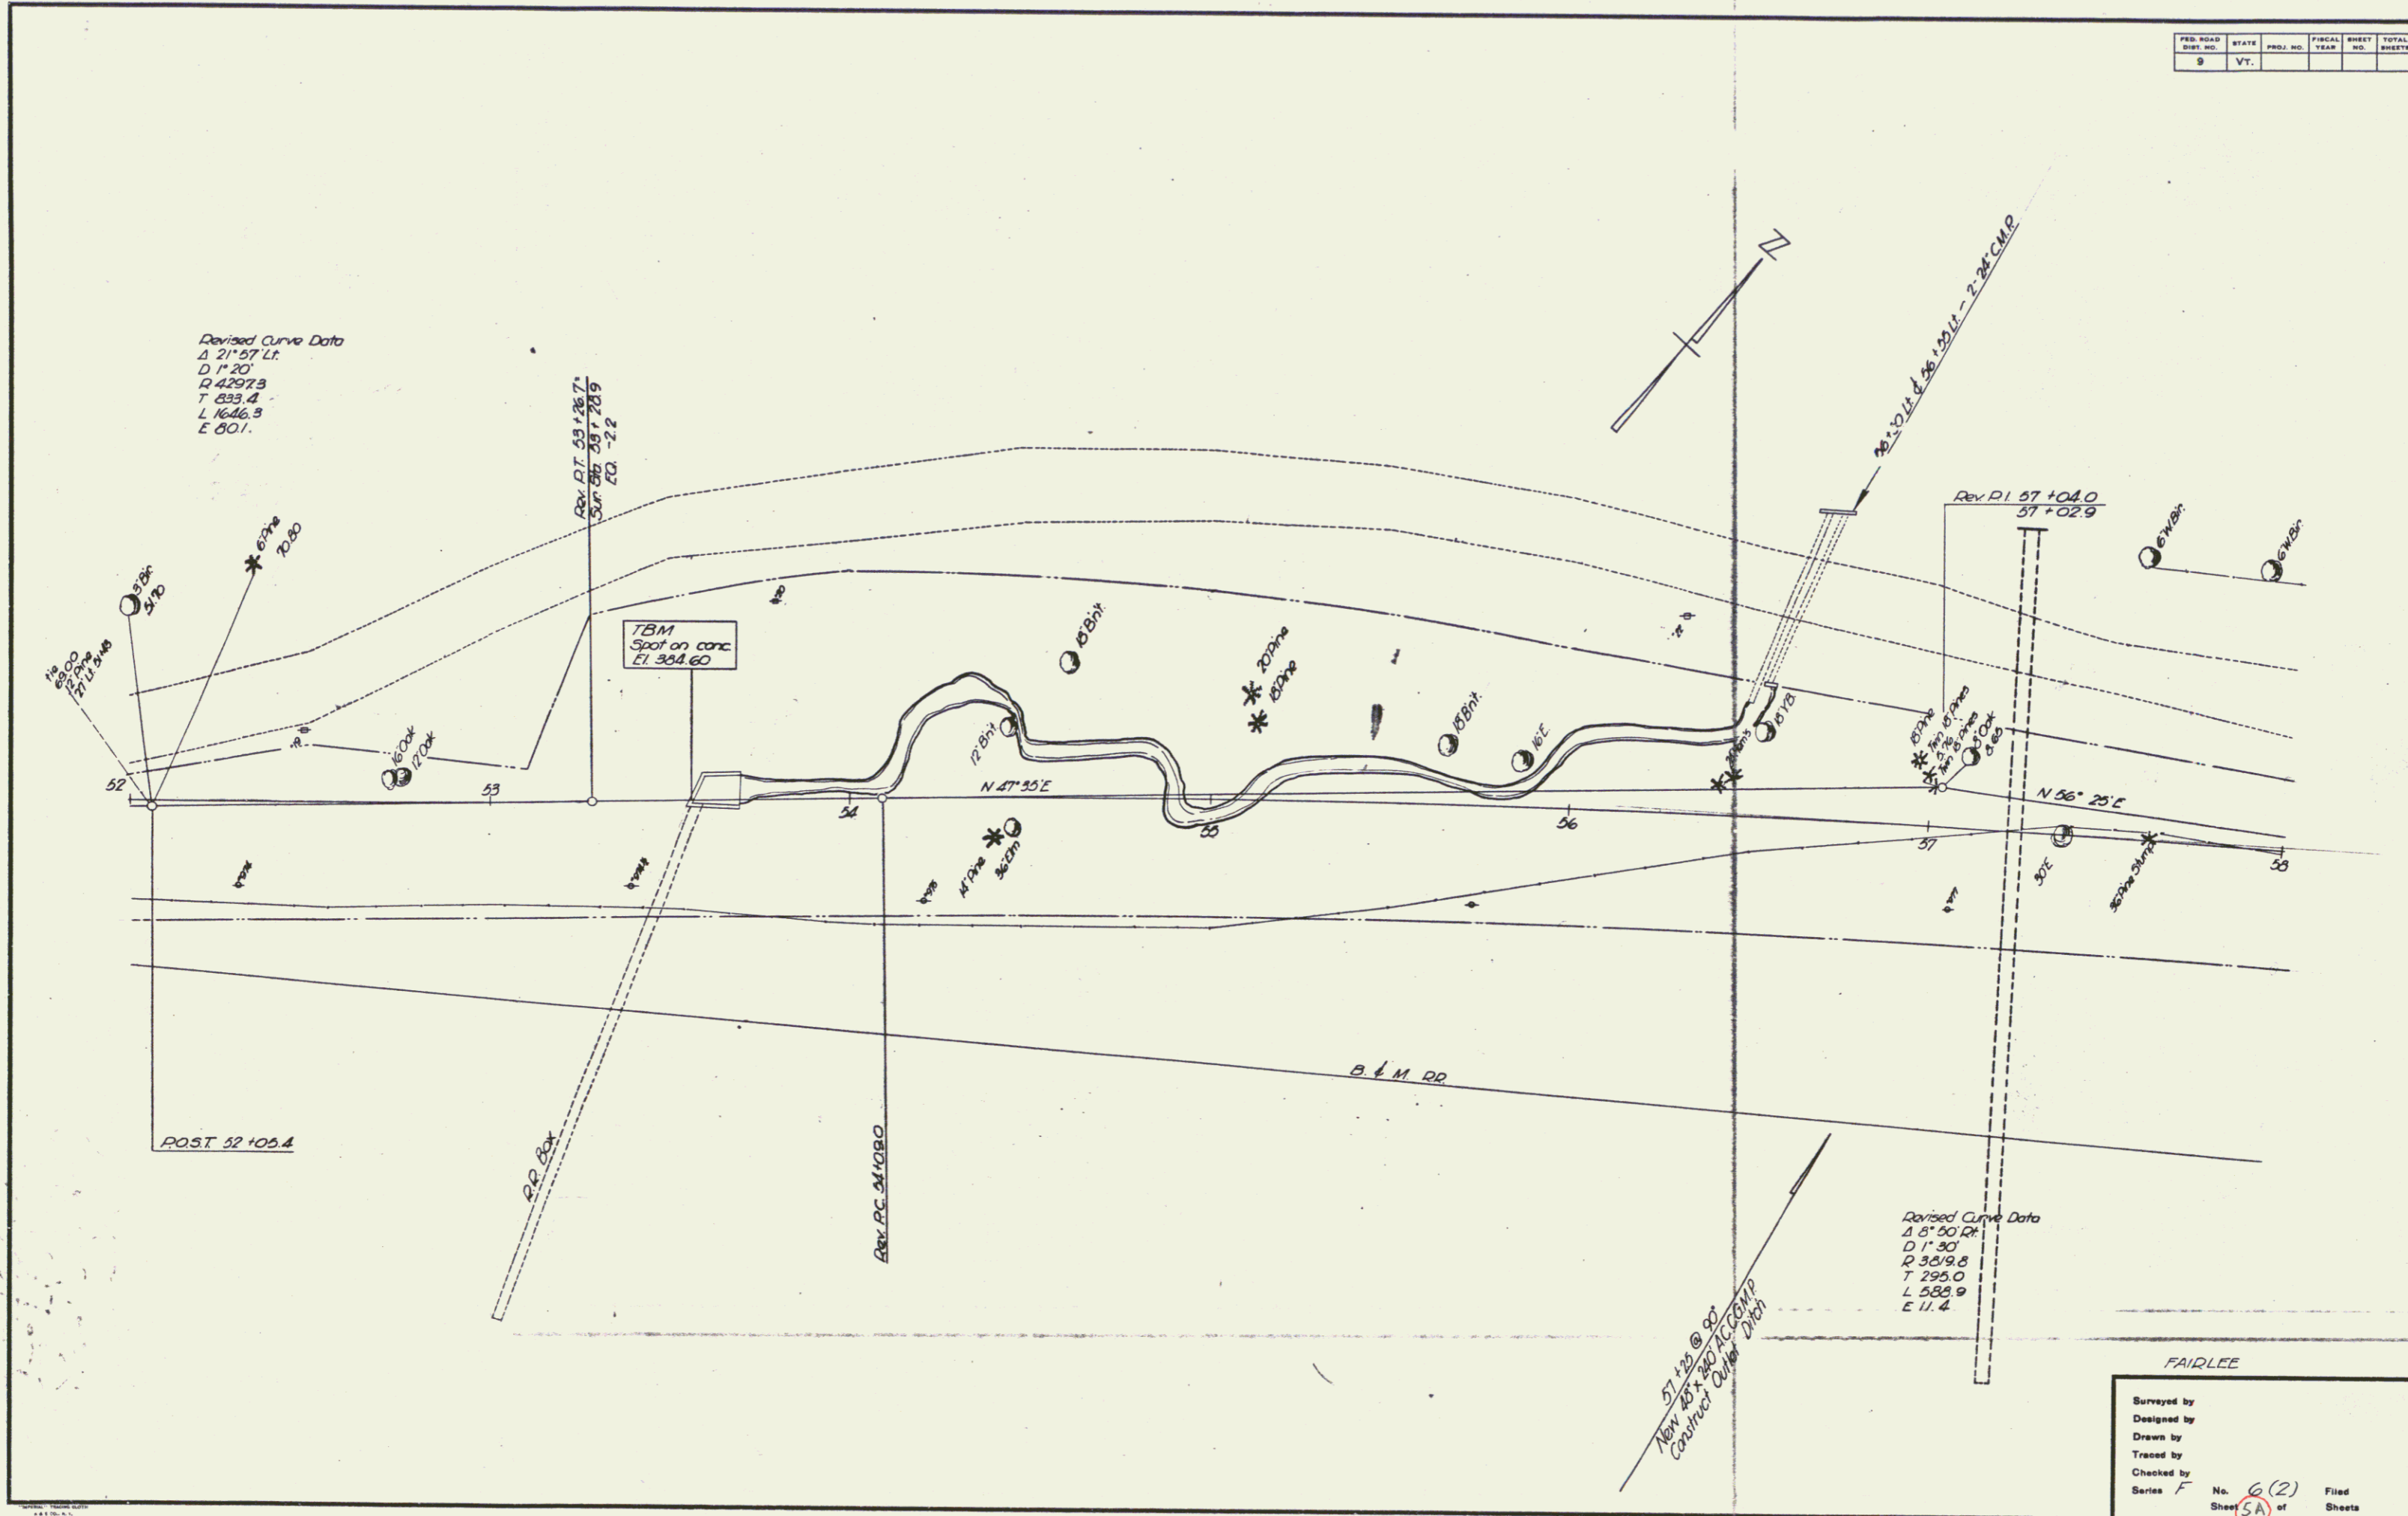

Surveyed by
 Designed by
 Drawn by
 Traced by
 Checked by
 Series F No. 6(2) Filed
 Sheet 5A of Sheets