



Construct Special U-Turn
Sta. 311+12.4 - 314+30 LT

Construct Drives
305+80 RT ✓
307+85 RT ✓
(Dove) 309+25 RT ✓ 309+100 RT ✓
310+40 RT ✓ 310+80 RT ✓
312+00 RT (Comm) ✓
305+25 - 307+00 LT
309+25 LT
307+00 RT ✓
307+25 - 307+60 LT

Granite Slope Edging Item 556-A
(for Islands Area) (Special U-Turn)
Sta. 311+02 - 313+00E Sta. 311+00 - 313+00LT

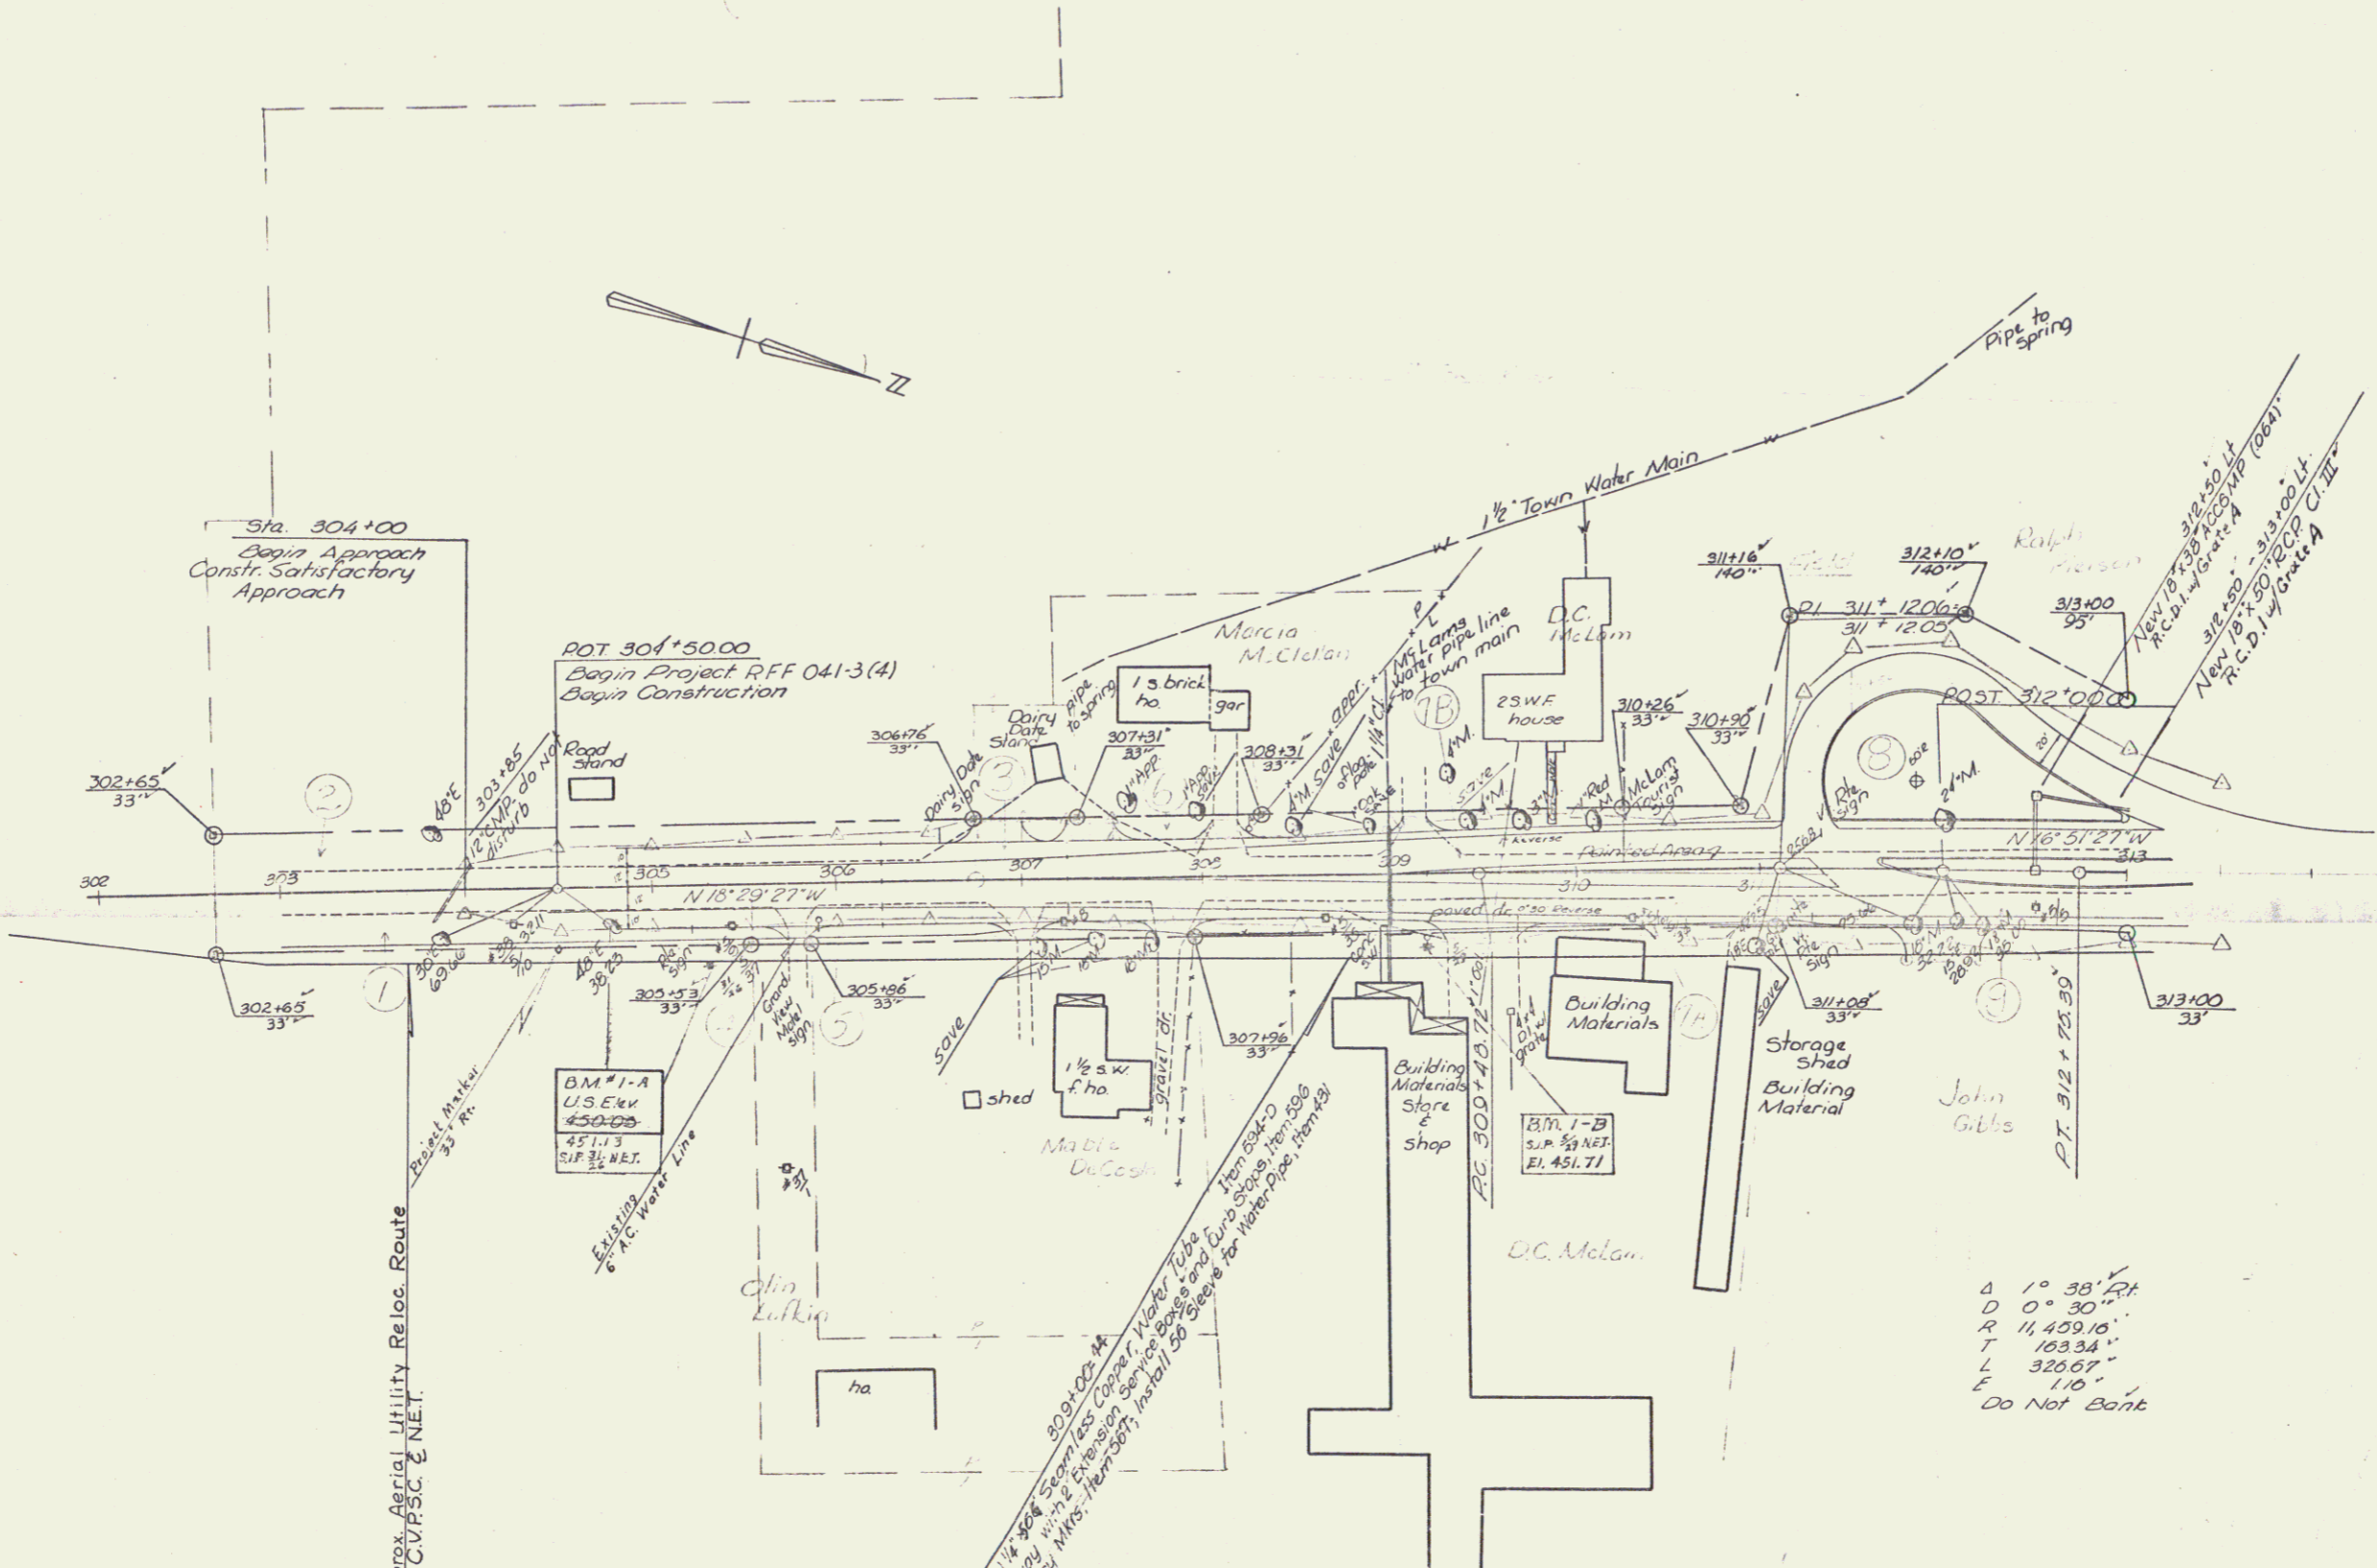

Δ 1° 38' RT
D 0° 30' RT
R 11,459.10'
T 103.54'
L 326.67'
E 110'
Do Not Bank

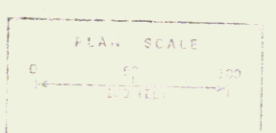

SURVEYED BY Spaulding DATE 6/16/5
DRAWN BY Shultz DATE 6/16/5
TRACED BY L. Clark DATE 6/16/5
BRADFORD
PROJ. RFF NO. 041-3(4)
SHEET 76 OF 140