
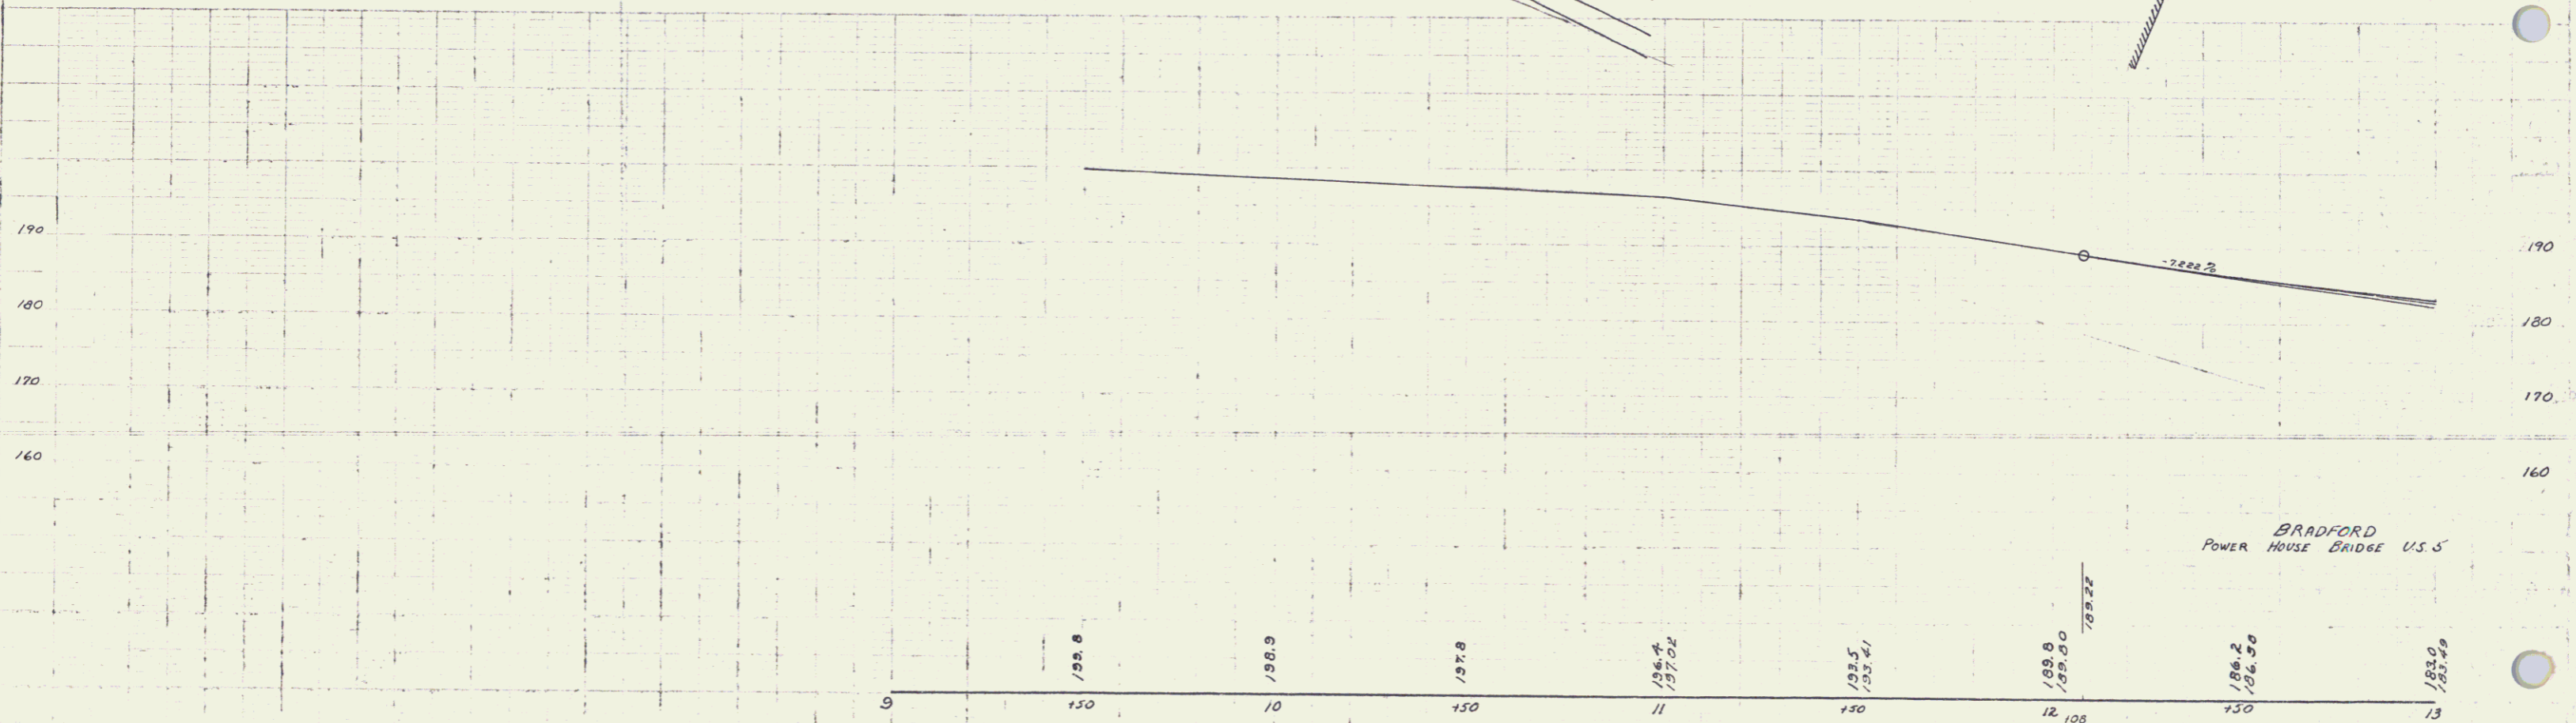


W.H. DeWitt
 E.P. Perkins
 W.J. Brock

1/28
 1/28
| STATE | PLANNING DIST. NO. | PROJECT NO. | SHEET NO. | TOTAL SHEETS |
|-------|--------------------|-------------|-----------|--------------|
| VT | 128 | 7050 | 4 | 10 |

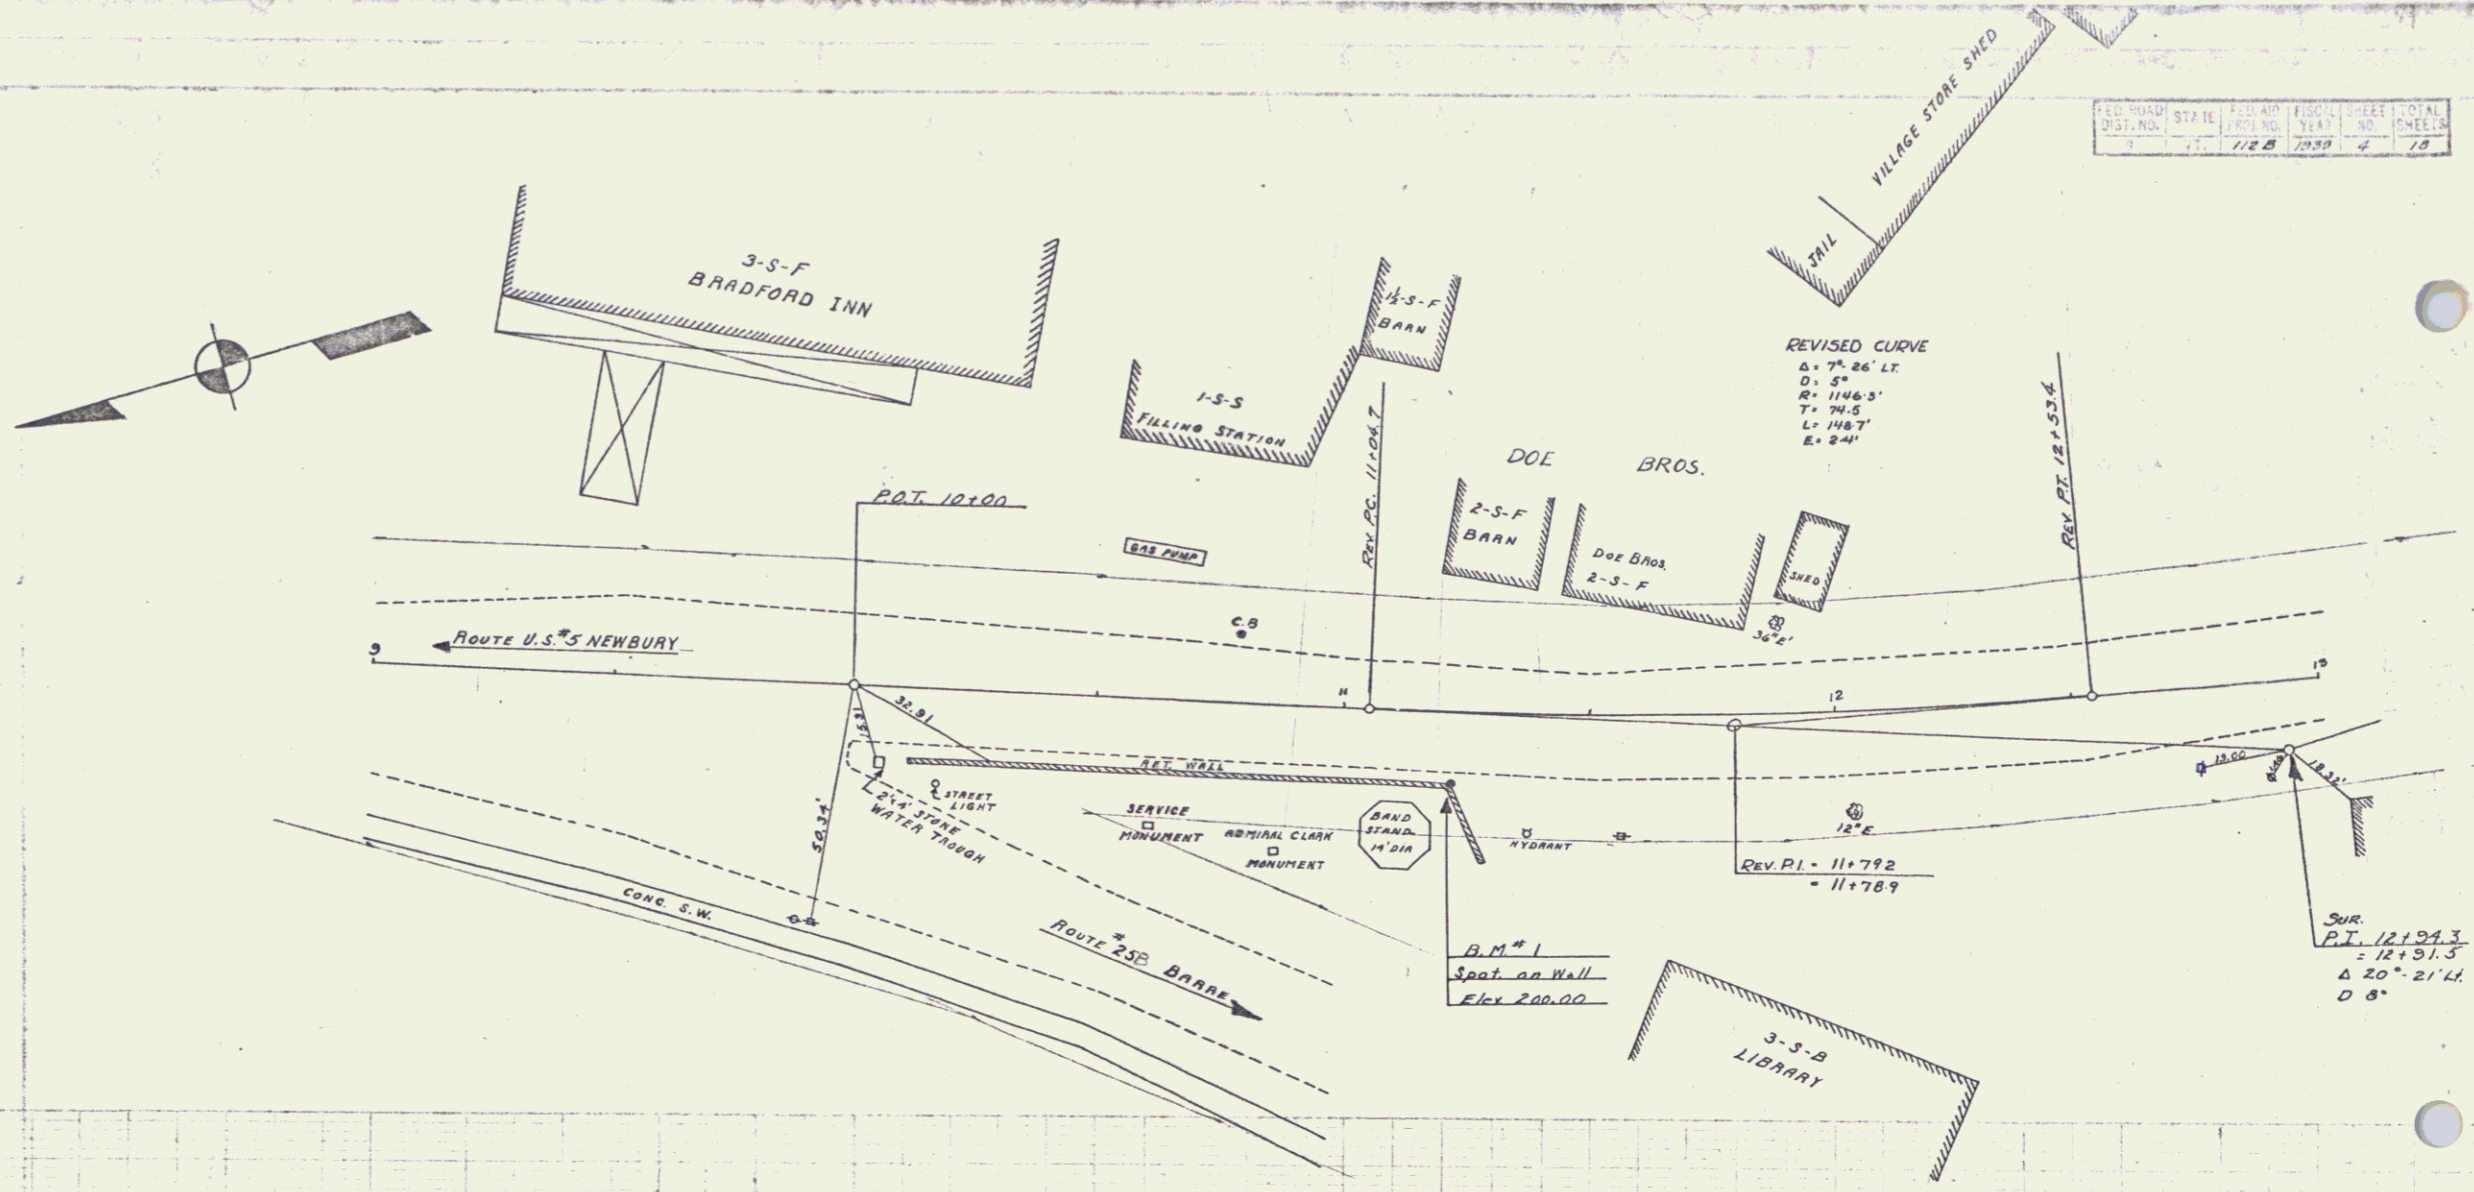

B.M. #1 SPOT ON CONCRETE ART. WALL 15' RT. STA. 11+22. ELEV. 200.00

BRADFORD POWER HOUSE BRIDGE U.S. 5
 Series EAP No 1128
 Sheet 4 of 10