


Surveyed by
Traced by
Hurley B. G.

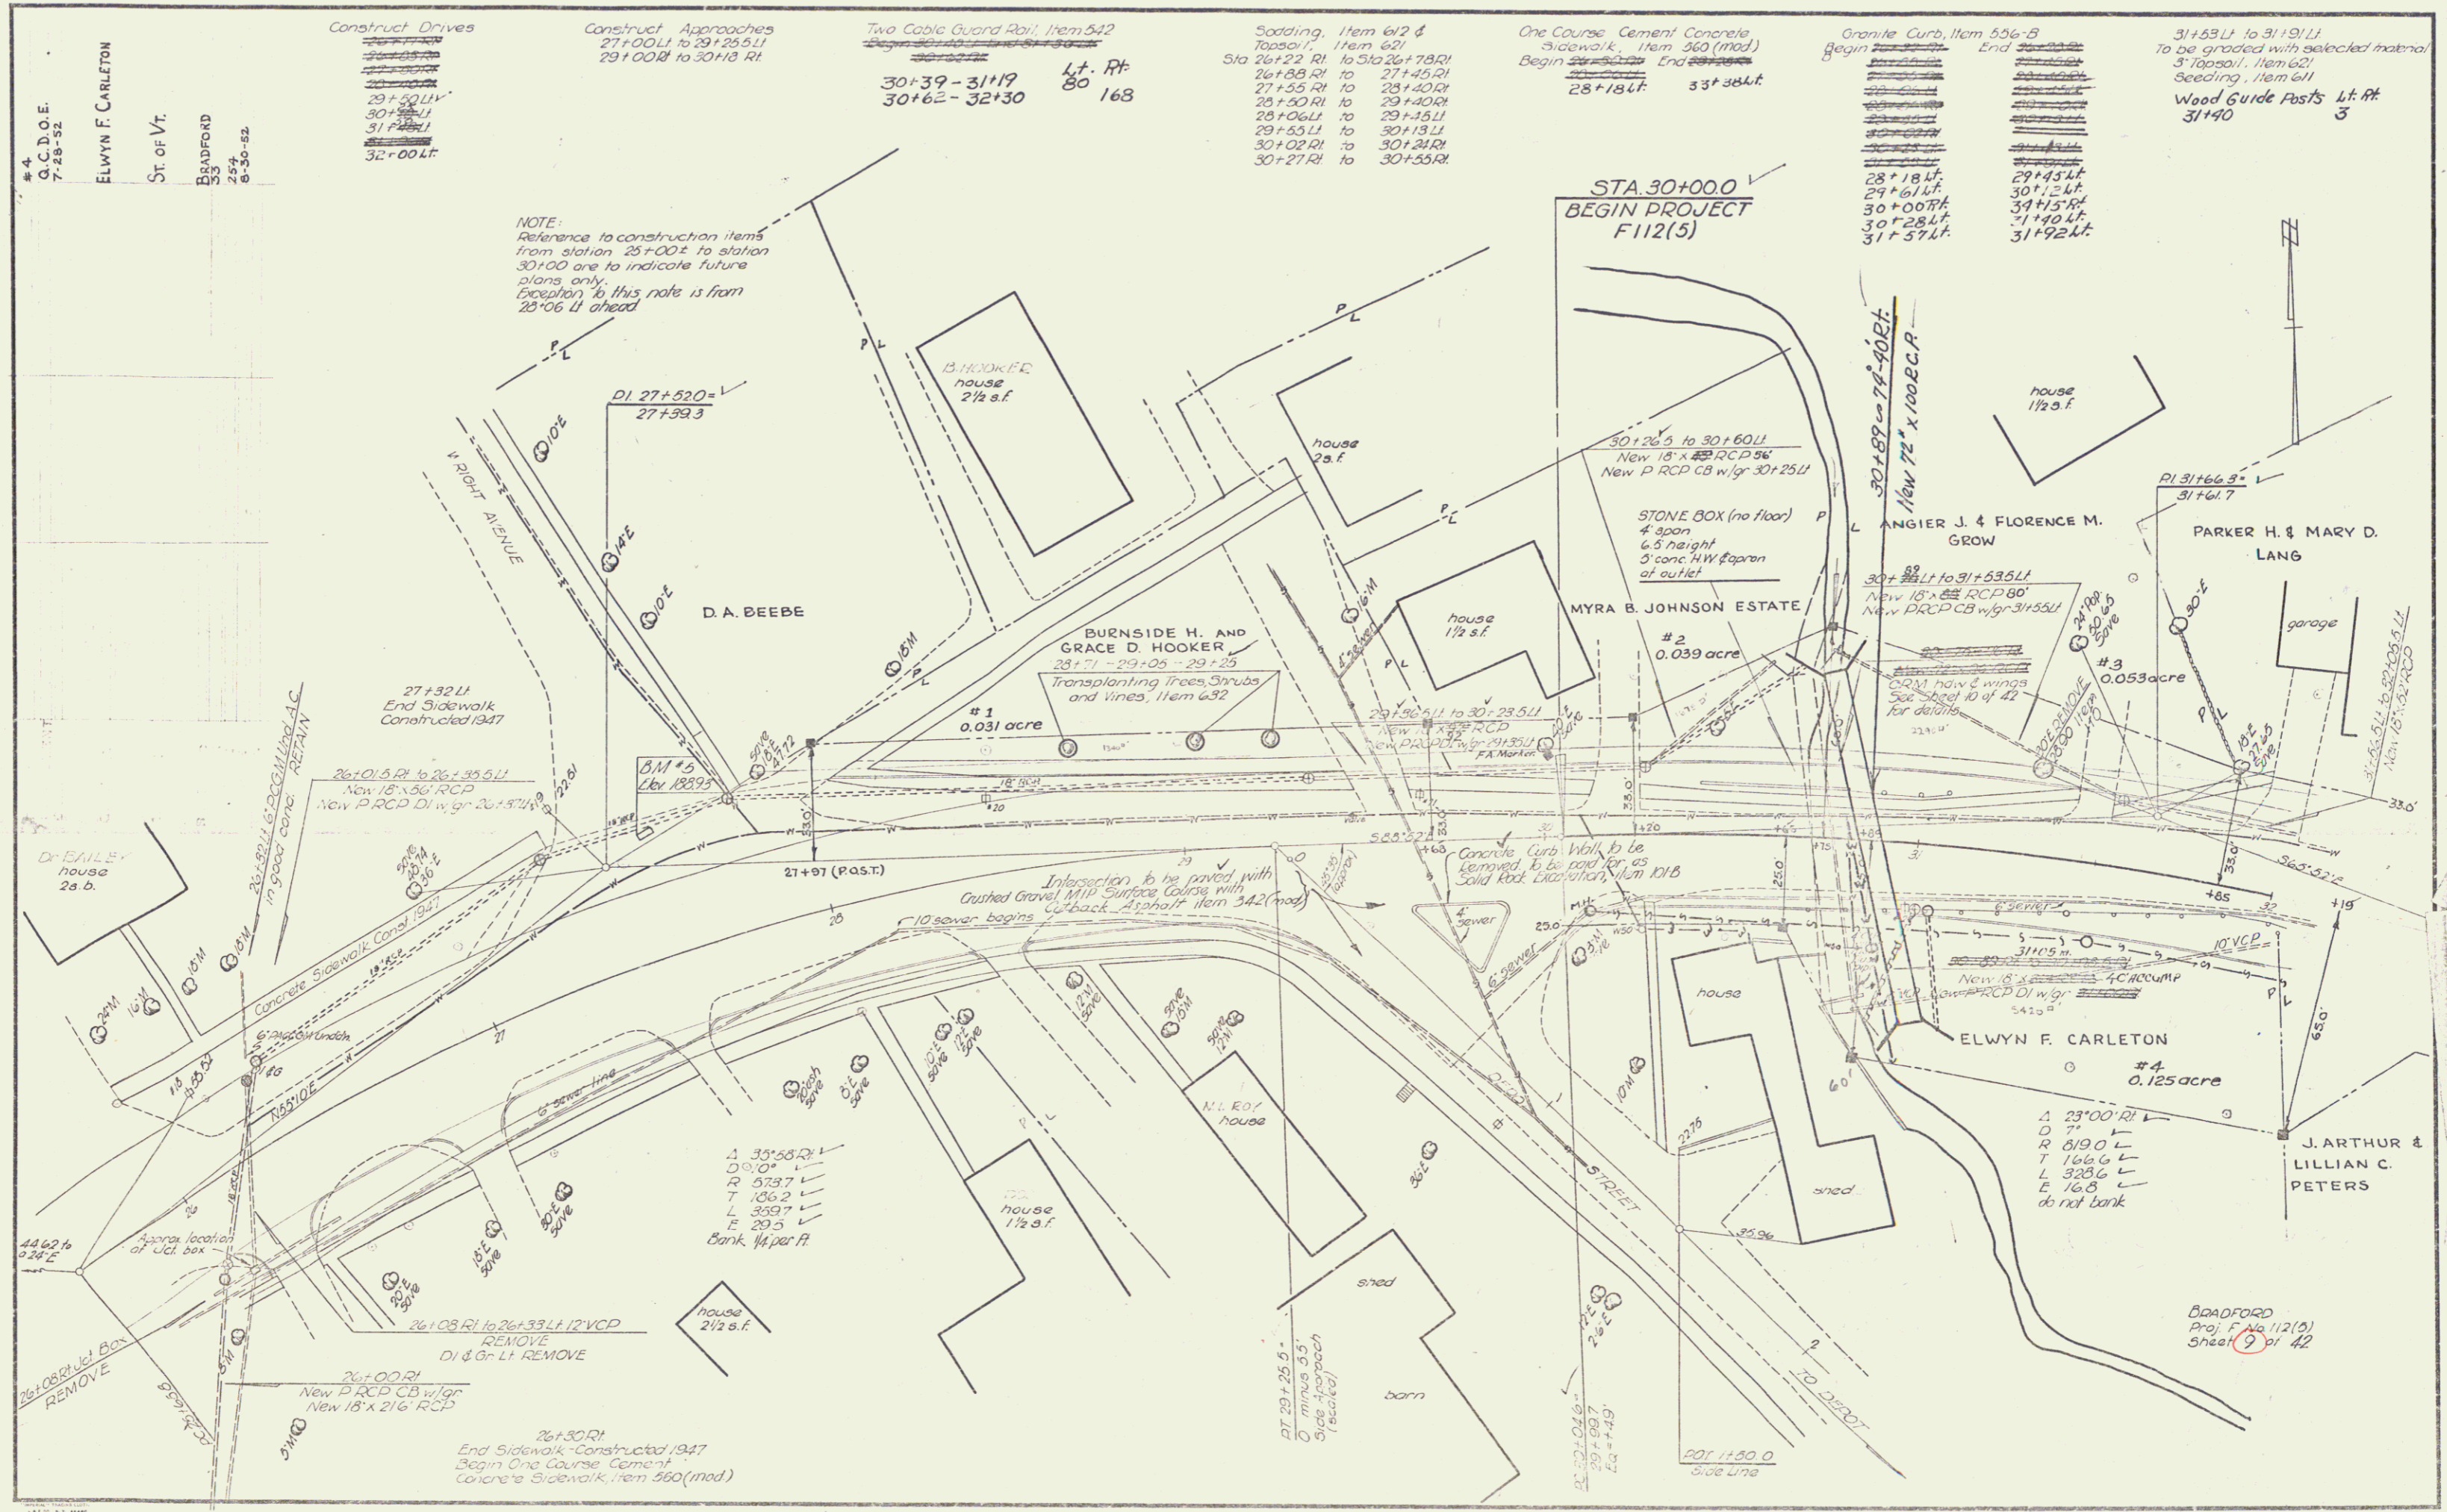

#4
G.C.D.O.E.
7-28-52
ELWYN F. CARLETON

St. of Vr.
BRADFORD
33
6-30-52

Construct Drives
29+30.00' L
30+30.00' L
31+30.00' L
32+00.00' L

Construct Approaches
27+00.00' to 29+25.50' L
29+00.00' to 30+13.00' R

Two Cable Guard Rail, Item 542
30+39-31+19 L
30+62-32+30 R
L.F. 80
R.F. 168

Sodding, Item 612 & Topsoil, Item 621
Sta 26+22.00' to Sta 26+78.00' L
26+88.00' to 27+45.00' R
27+55.00' to 28+40.00' L
28+50.00' to 29+40.00' R
29+55.00' to 30+13.00' L
30+02.00' to 30+31.00' R
30+27.00' to 30+55.00' L

One Course Cement Concrete Sidewalk, Item 560 (mod)
Begin 28+18.00' End 33+38.00'

Granite Curb, Item 556-B
Begin 28+18.00' End 29+45.00' L
29+61.00' L
30+00.00' L
30+28.00' L
31+57.00' L
29+45.00' L
30+12.00' L
30+15.00' L
31+40.00' L
31+92.00' L

31+83.00' to 31+91.00' L
To be graded with selected material
3" Topsoil, Item 621
Seeding, Item 611
Wood Guide Posts L.F. R.F.
31+40 3

NOTE:
Reference to construction items
from station 25+00.00' to station
30+00.00' are to indicate future
plans only.
Exception to this note is from
28+06.00' ahead

STA. 30+00.0
BEGIN PROJECT
F112(5)

30+89.00' to 31+40.00' L
New 7' x 10' B.C.P.

LANGIER J. & FLORENCE M. GROW

PARKER H. & MARY D. LANG

MYRA B. JOHNSON ESTATE

ELWYN F. CARLETON

J. ARTHUR & LILLIAN C. PETERS

Dr. BAILEY house
2 s. b.

D. A. BEEBE

BURNSIDE H. AND GRACE D. HOOKER

house
1 1/2 s.f.

house
1 1/2 s.f.

garage

house

house
1 1/2 s.f.

house
1 1/2 s.f.

barn

shed

44.00 to 33.00 E

26+08.00' to 26+10.00' L
REMOVE

26+00.00' L
New P.R.C.P. CB w/gr
New 18' x 216' R.C.P.

26+30.00' R
End Sidewalk - Constructed 1947
Begin One Course Cement Concrete Sidewalk, Item 560 (mod)

Δ 30' 58.20' L
D 0' 10' L
R 0' 37.70' L
T 106.2 L
L 309.7 L
E 20.5 L
Bank 1/4 per ft

Δ 23' 00' RI
D 7' L
R 169.0 L
T 166.6 L
L 328.6 L
E 16.8 L
do not bank

BRADFORD
Proj. F. No. 112(5)
Sheet 9 of 42