


Scale	1" = 40'
Spreading	7.5'
Height	6.5'

Note: 33+50 to 46+00 ft
Shoulders to be surfaced with Double
Rock Coat or Bituminous Material with Peat-treated
Red Stone Seal Prime Coat of Refined Tar and
Seal Coat of Cutback Asphalt, Item 312

Wood Guide Posts 4.1 ft
35+05 /
36+82 /
36+98 /

Parcel	INSTR. DATE	GRANTOR	GRANTEE	RECORDED - BOOK-PAGE-DATE	REMARKS
#5A					
#6	W.D.O. 7-21-51	J. ARTHUR & LILLIAN C. PETERS	ST. OF VT.	BRADFORD 53-251 8-31-51	
#7	W.D. 3-30-51	HUGH W. & JESSIE S. HASTINGS	ST. OF VT.	BRADFORD 53-151 3-28-51	SUB. SHEET 12
#8	W.D.O.E. 7-21-51	C. SPENCER & KATHERINE M. PHILLIPS	ST. OF VT.	BRADFORD 53-258 8-30-51	
#9	W.D.O.E. 9-16-51	MARION E. & AZEL F. BLAKE	ST. OF VT.	BRADFORD 53-265 9-10-51	

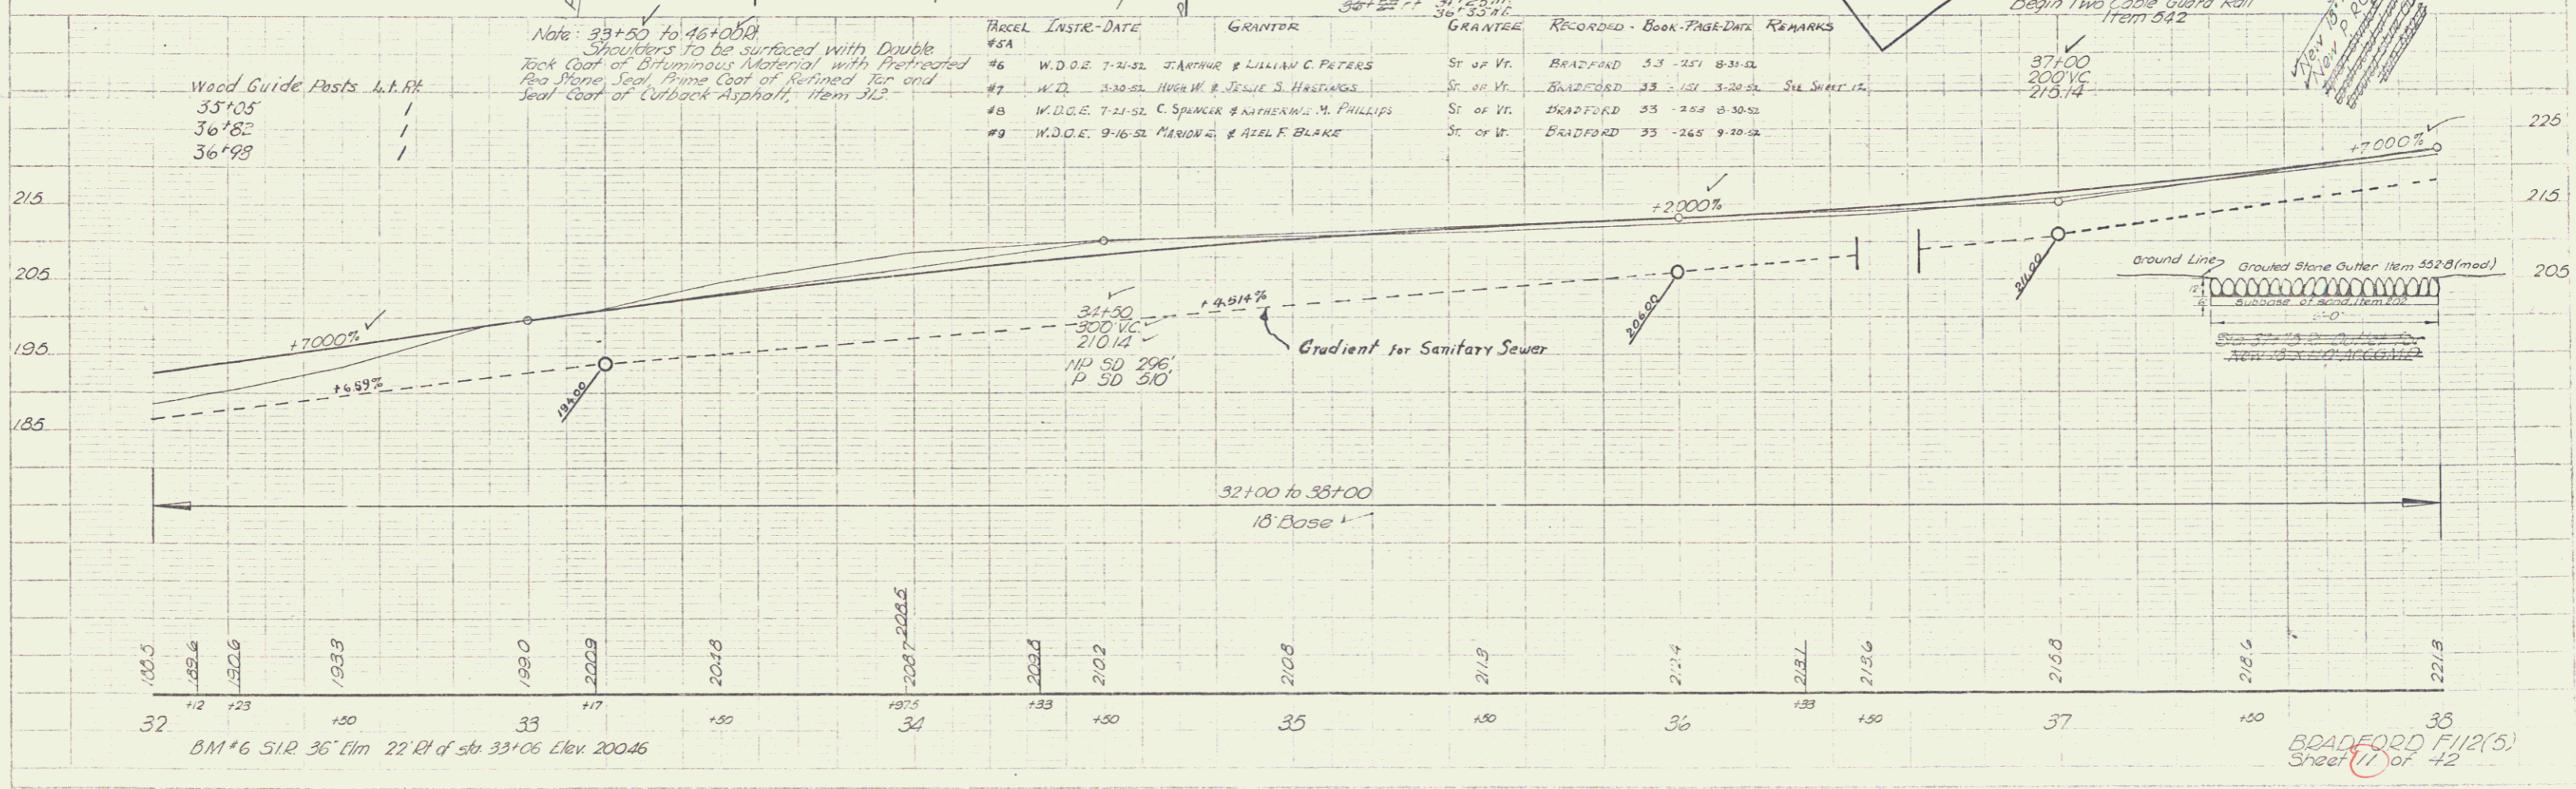

Scale	1" = 40'
-------	----------

BRADFORD F/12(5)
Sheet 11 of 42