


DATE	11/23	
BY	ALB	
SCALE	AS SHOWN	
PROJECT	FRANK E. & VIRGINIA PETERS	
DESCRIPTION	CONSTRUCT DRIVE	
REVISIONS		
NO.	DATE	DESCRIPTION
1		

DATE	11/23	
BY	ALB	
SCALE	AS SHOWN	
PROJECT	FRANK E. & VIRGINIA PETERS	
DESCRIPTION	CONSTRUCT DRIVE	
REVISIONS		
NO.	DATE	DESCRIPTION
1		

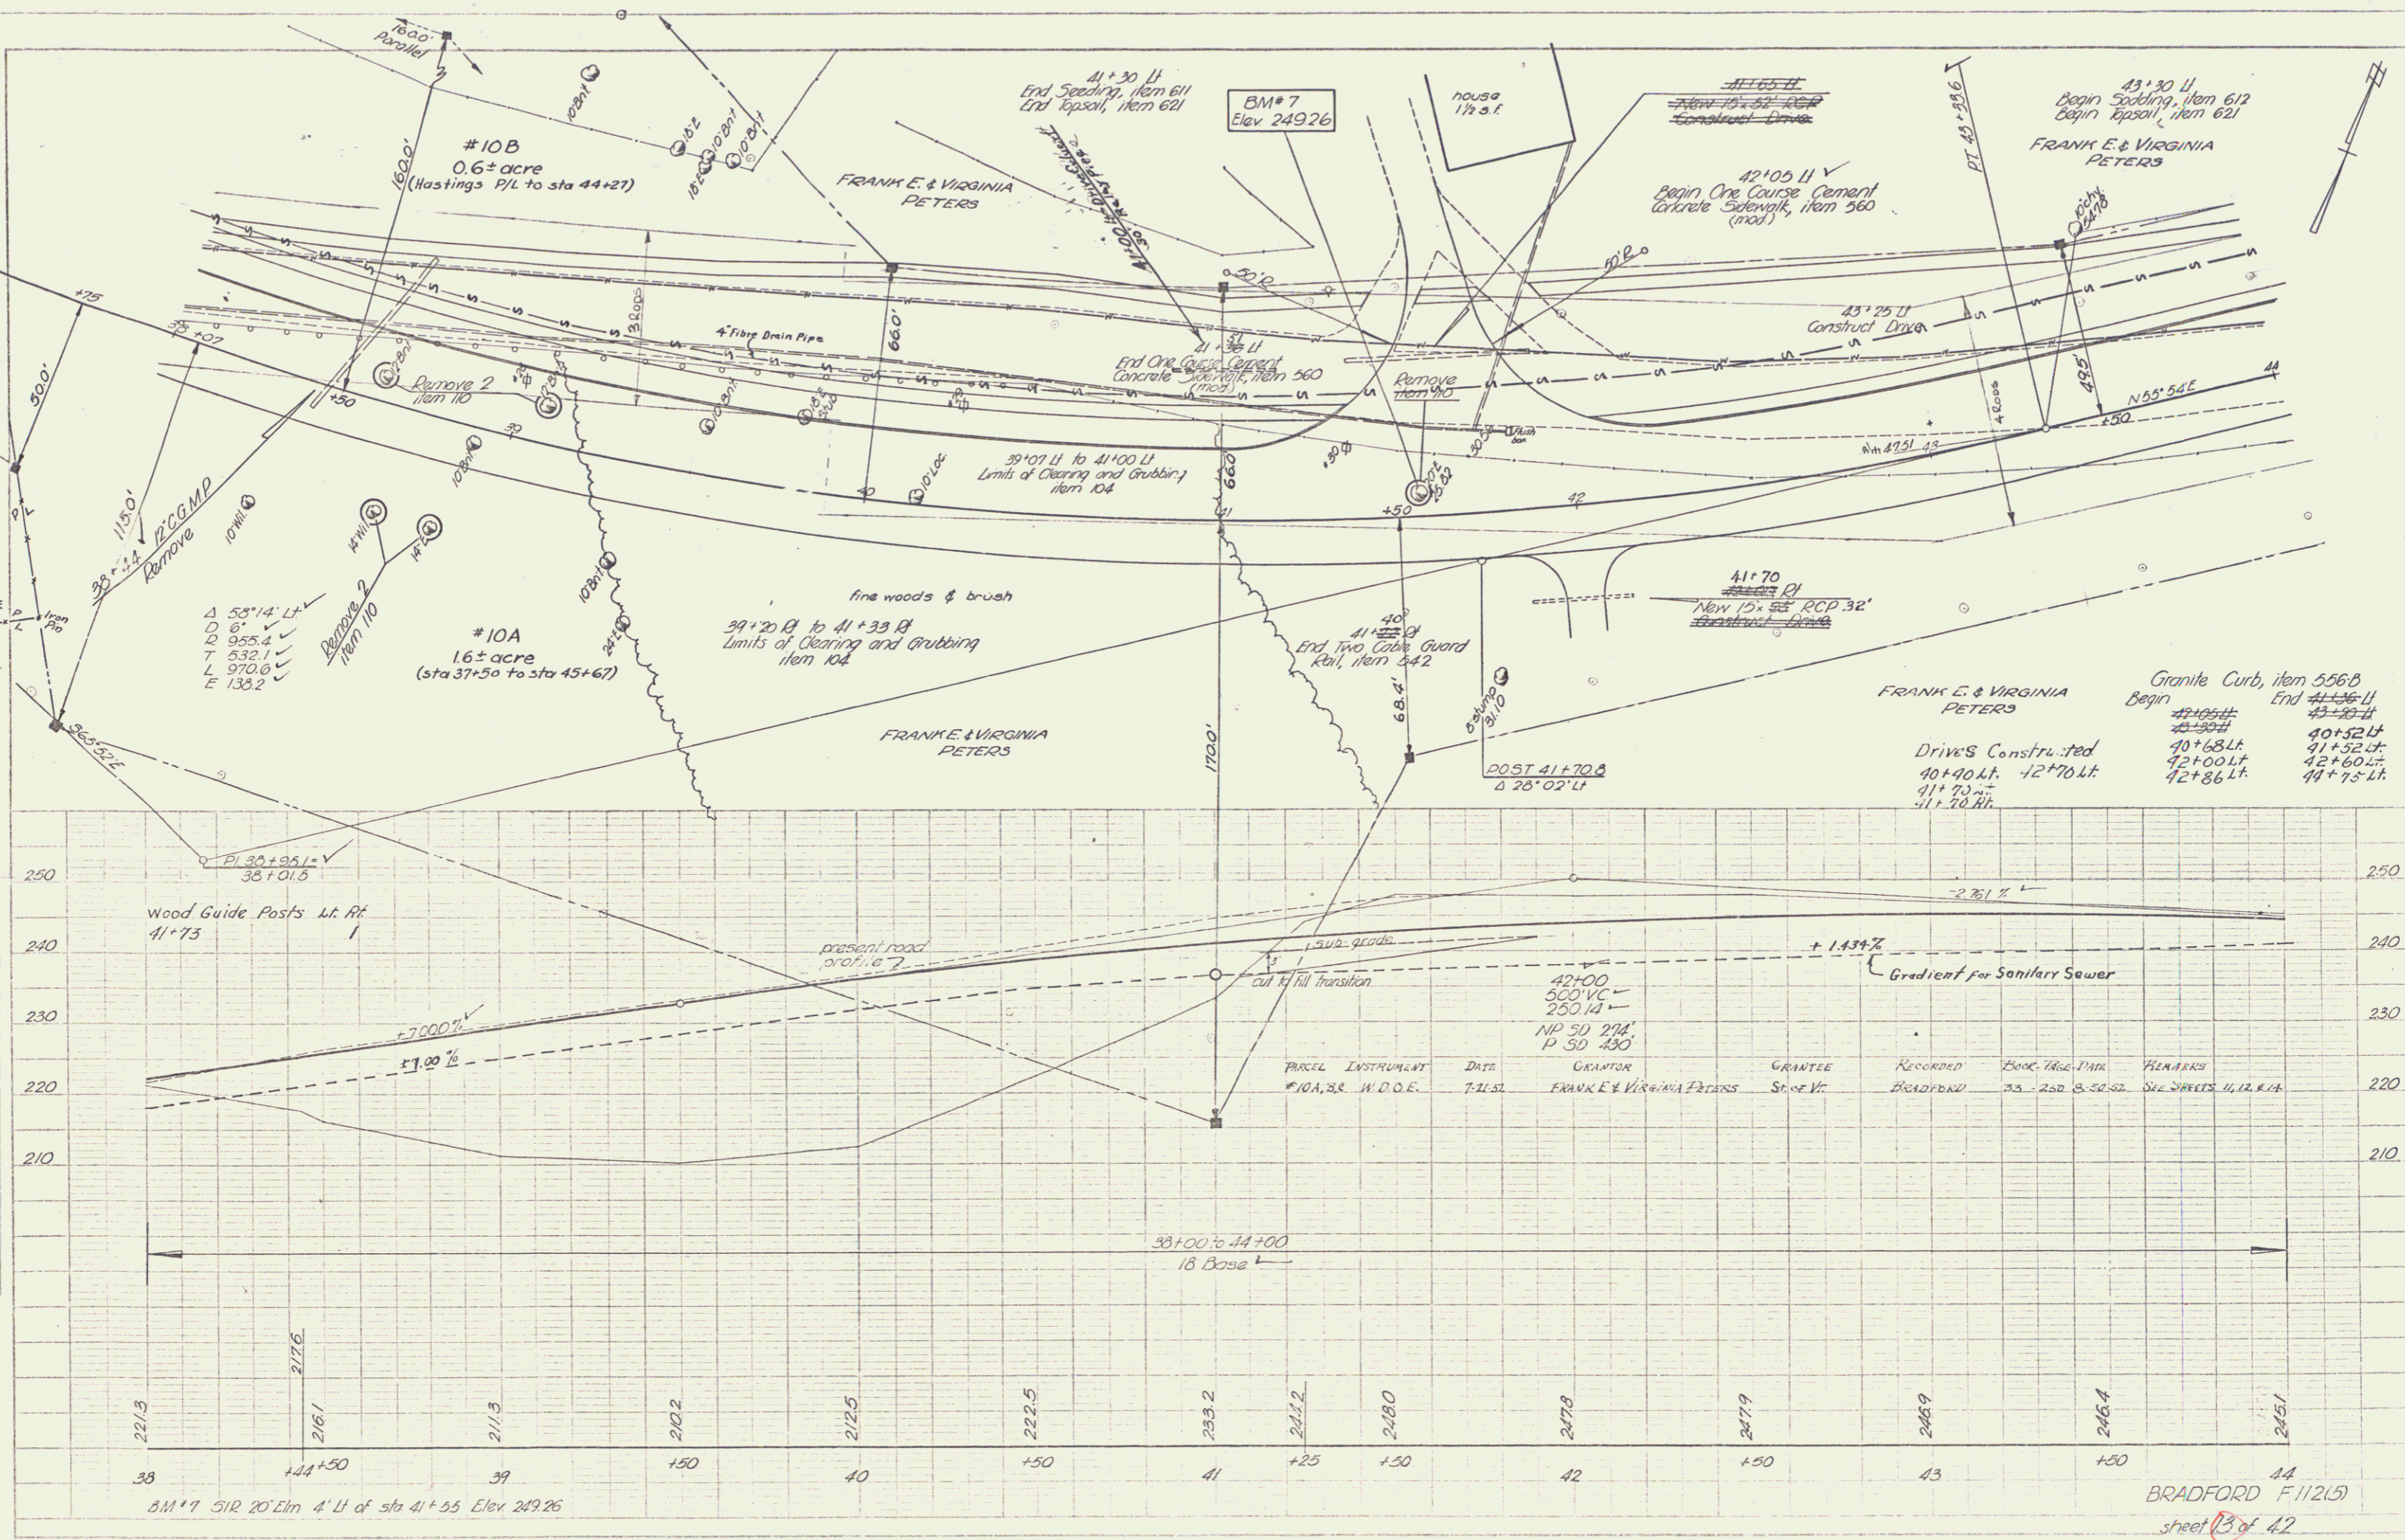

BM#7 51R 20' Elm 4' Lt of sta 41+55 Elev. 249.26

BRADFORD F11215
sheet 13 of 42

6