


PLAN	2-40
DATE	12-10-51
BY	W. J. ...
CHECKED	...
APPROVED	...

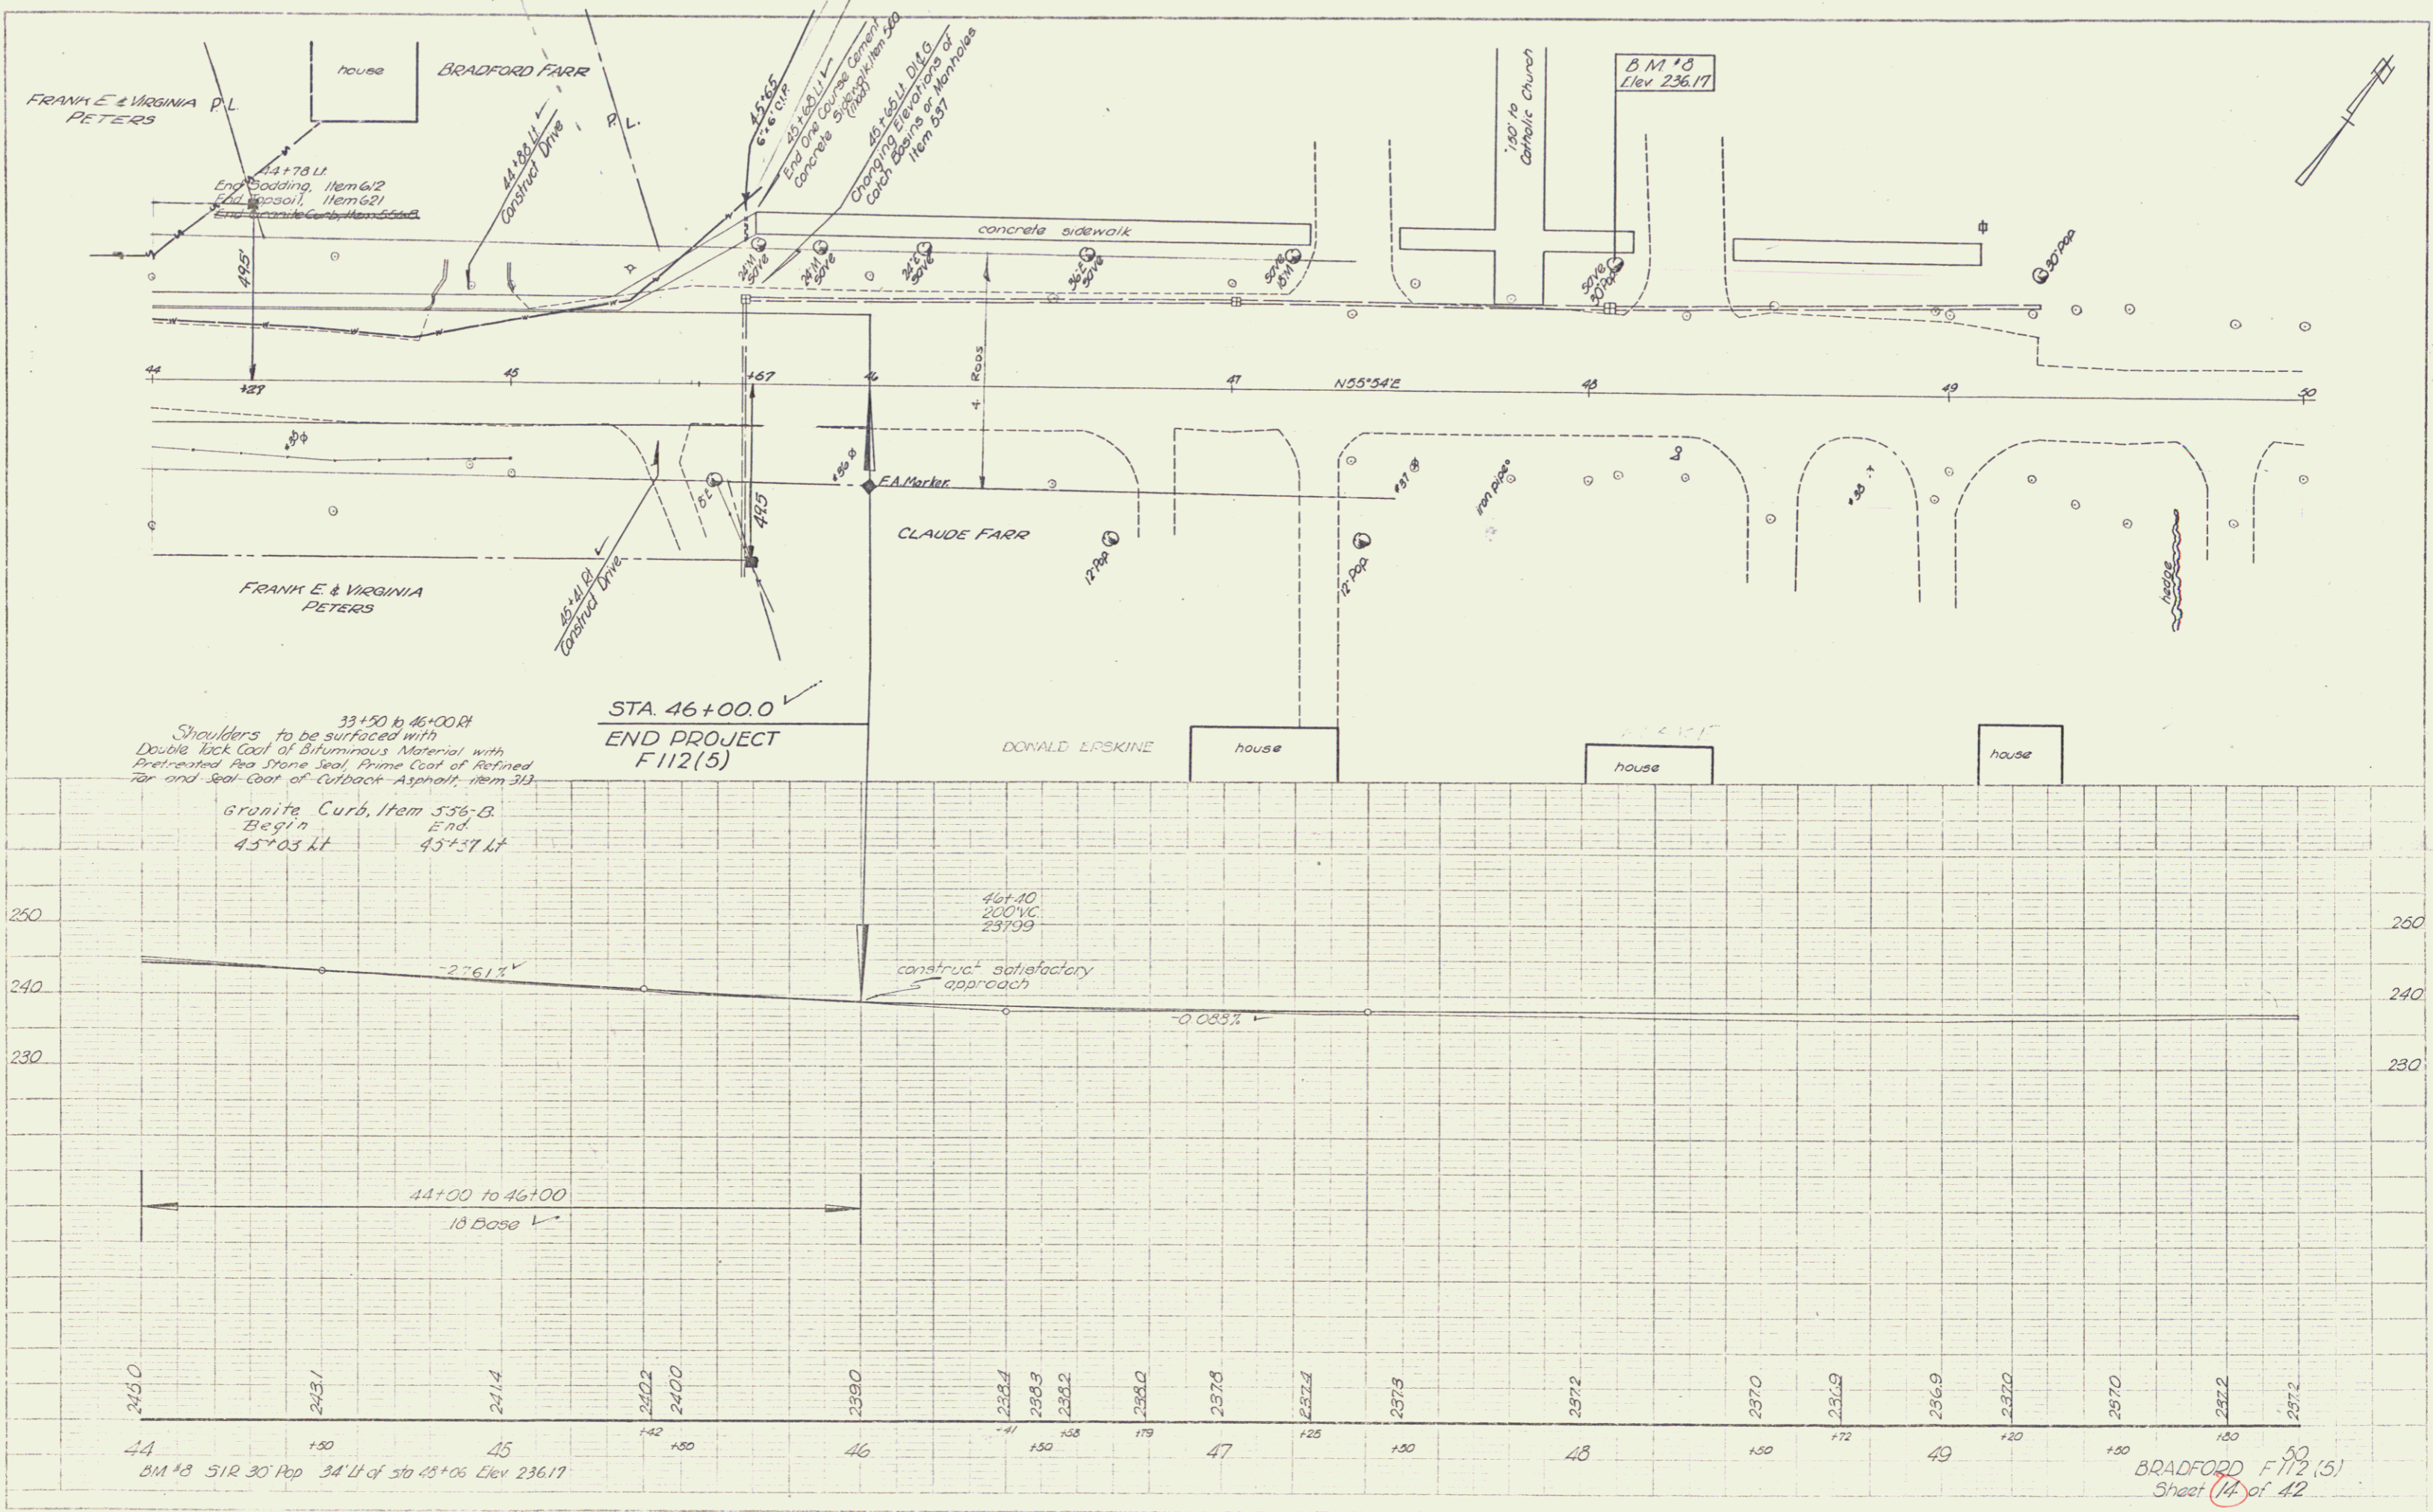

BRADFORD F112(5)
Sheet 14 of 42