


PLAN
 REVISIONS
 PLotted
 DATE
 BY
 CHECKED
 NO.

PROFILE
 DATE
 BY
 CHECKED
 NO.

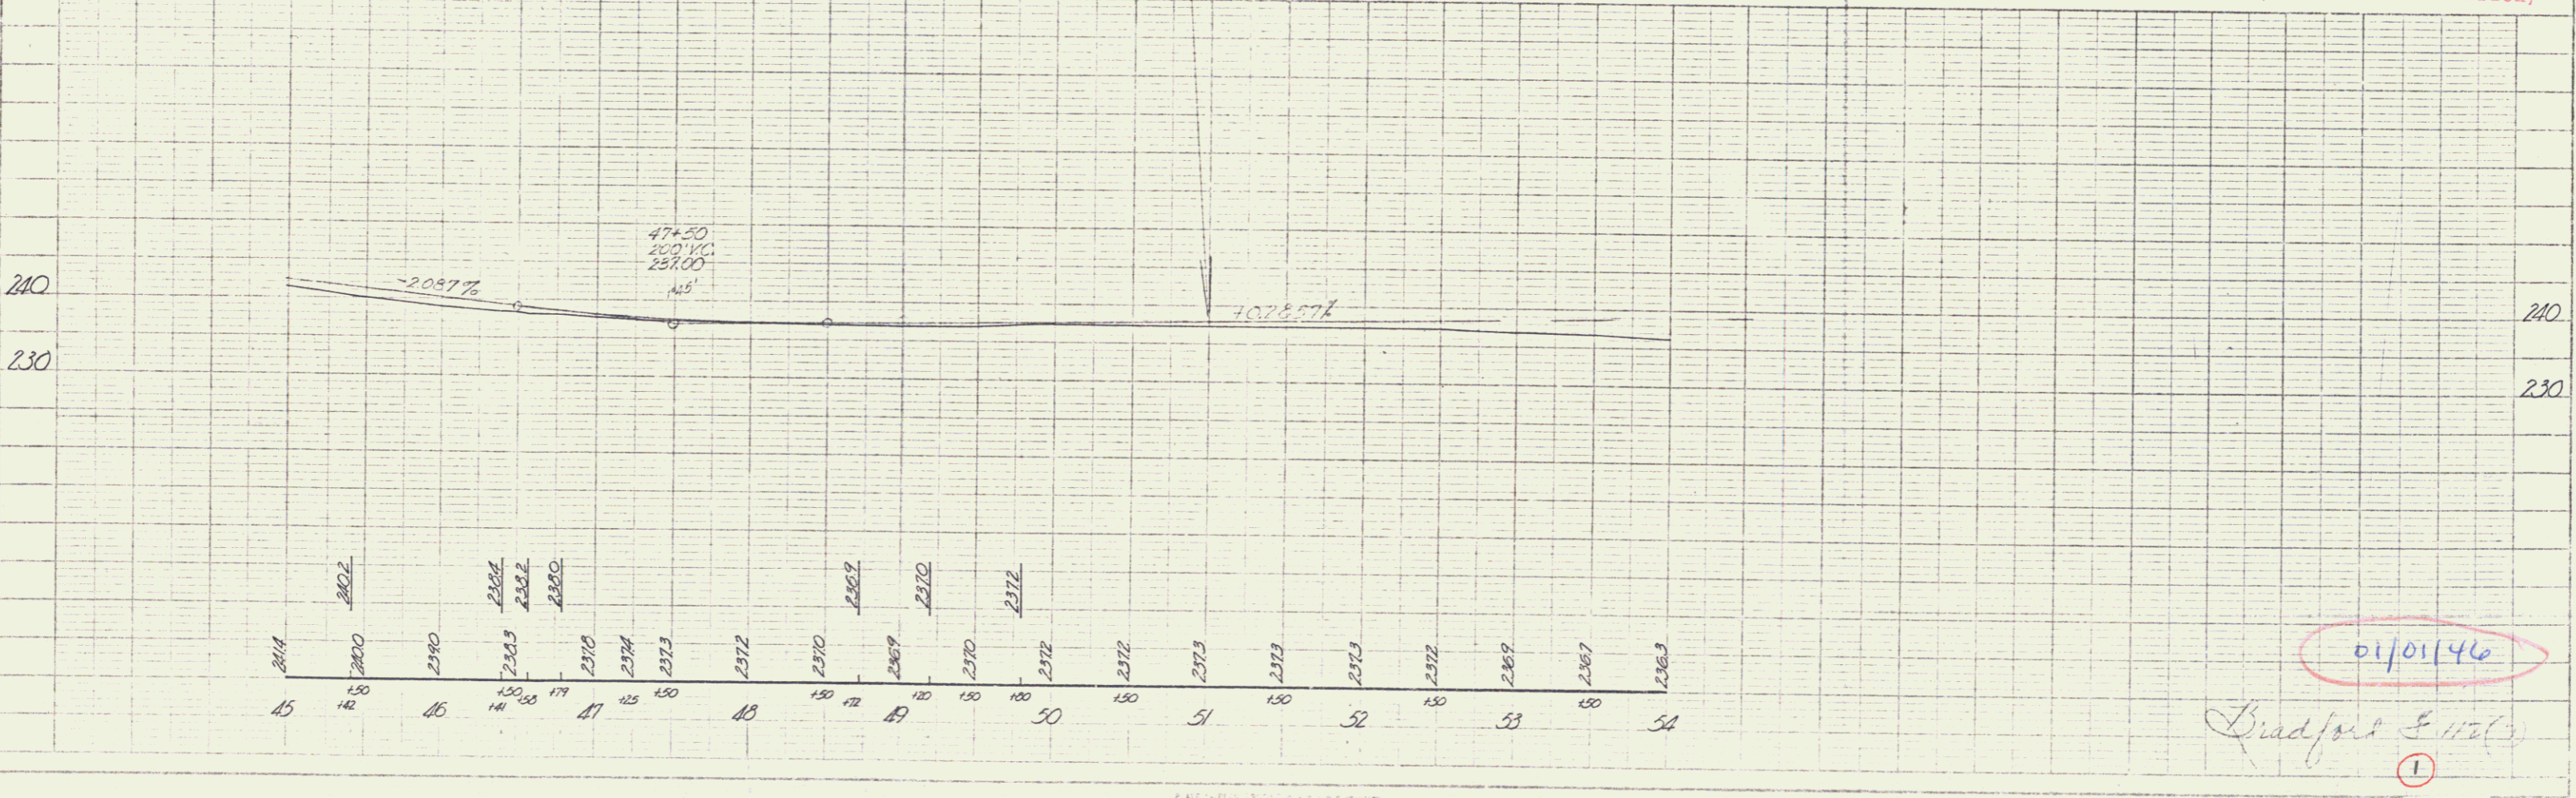

Pin# 99R 270
 Town: Bradford
 Project: F112(3)
 RIGHT-OF-WAY DIVISION
 TOWN FILE
 PERPETUAL
 Town of US 5
 (To Be Returned To R.O.W. Division)

01/01/46

Bradford F112(3)