


# 9 A PUTNAM W. B. MARILYN G. BLODGETT  
 STA. 151+50-182+54  
 8.12 ACRES ±  
 COND. 3/16/56  
 RECORDED: BRADFORD-BK34-P6 150/156  
 159/160-3/23/56

# 12 BOSTON & MAINE RAILROAD COMPANY  
 STA. 146+50-151+60  
 STA. 151+60-157+50  
 SLOPE RIGHTS  
 STA. 149+25, 155+55, 155+55-157+00  
 CULVERT RIGHTS  
 COND. 3/16/56  
 RECORDED: BRADFORD-BK 34-PG 150/156-159/160-3/23/56  
 STA. 147+00-158+00  
 FENCE AGREEMENT 5/31/55  
 RECORDED: BRADFORD-BK34-PG 391-6/15/57

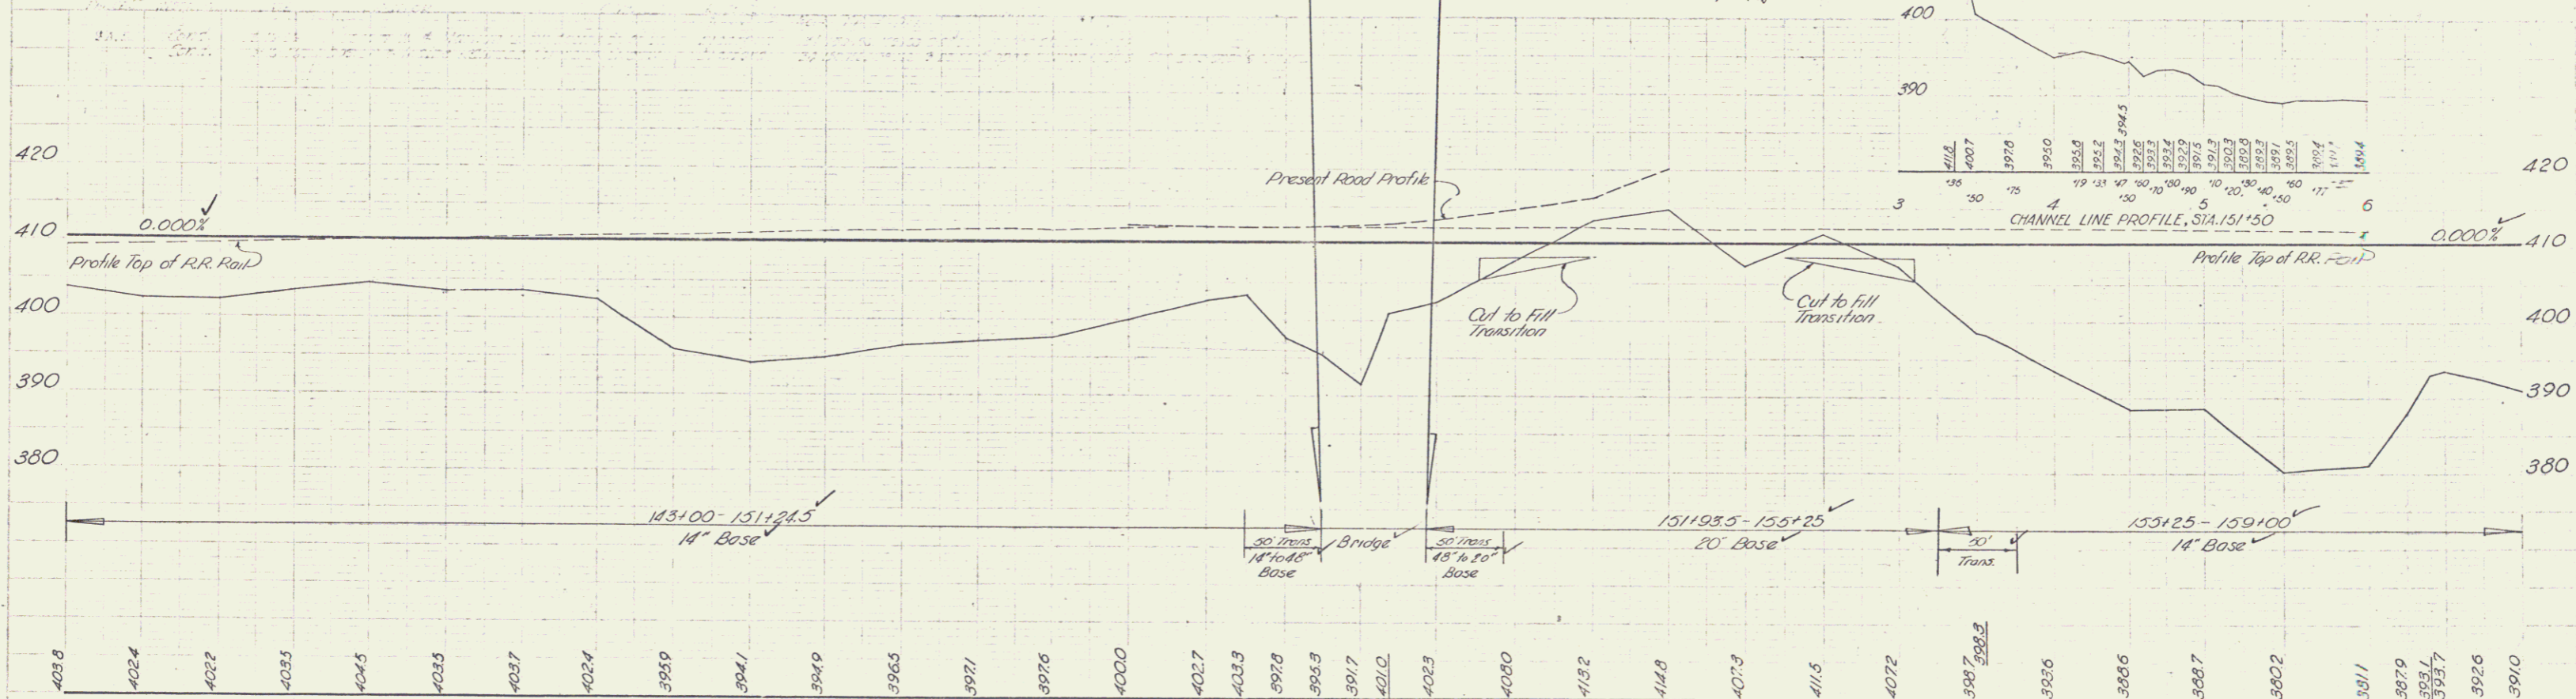

403.8 402.4 402.2 403.5 404.5 403.5 403.7 402.4 395.9 394.1 394.9 396.5 397.1 397.6 400.0 402.7 403.3 397.8 396.9 397.7 401.0 402.3 400.0 413.2 414.8 407.3 411.5 407.2 398.7 398.3 392.6 386.6 388.7 380.2 381.1 387.9 398.1 393.7 392.6 391.0

143 144 145 146 147 148 149 150 151 152 153 154 155 156 157 158 159

B.M. # 9 S.I.R. 24' Elm 103' Lt., Sta. 145+08 El. 410.83  
 416A H.W. 1936  
 410A H.W. 1927

B.M. # 10 S.I.T. 18' Elm 90' Lt., Sta. 155+55 El. 418.61  
 BRADFORD-NEWBURY  
 PROJ. E. 10. 112(6)  
 Sheet 12 of 25