



8/14
MILLER
6/14
TRACED

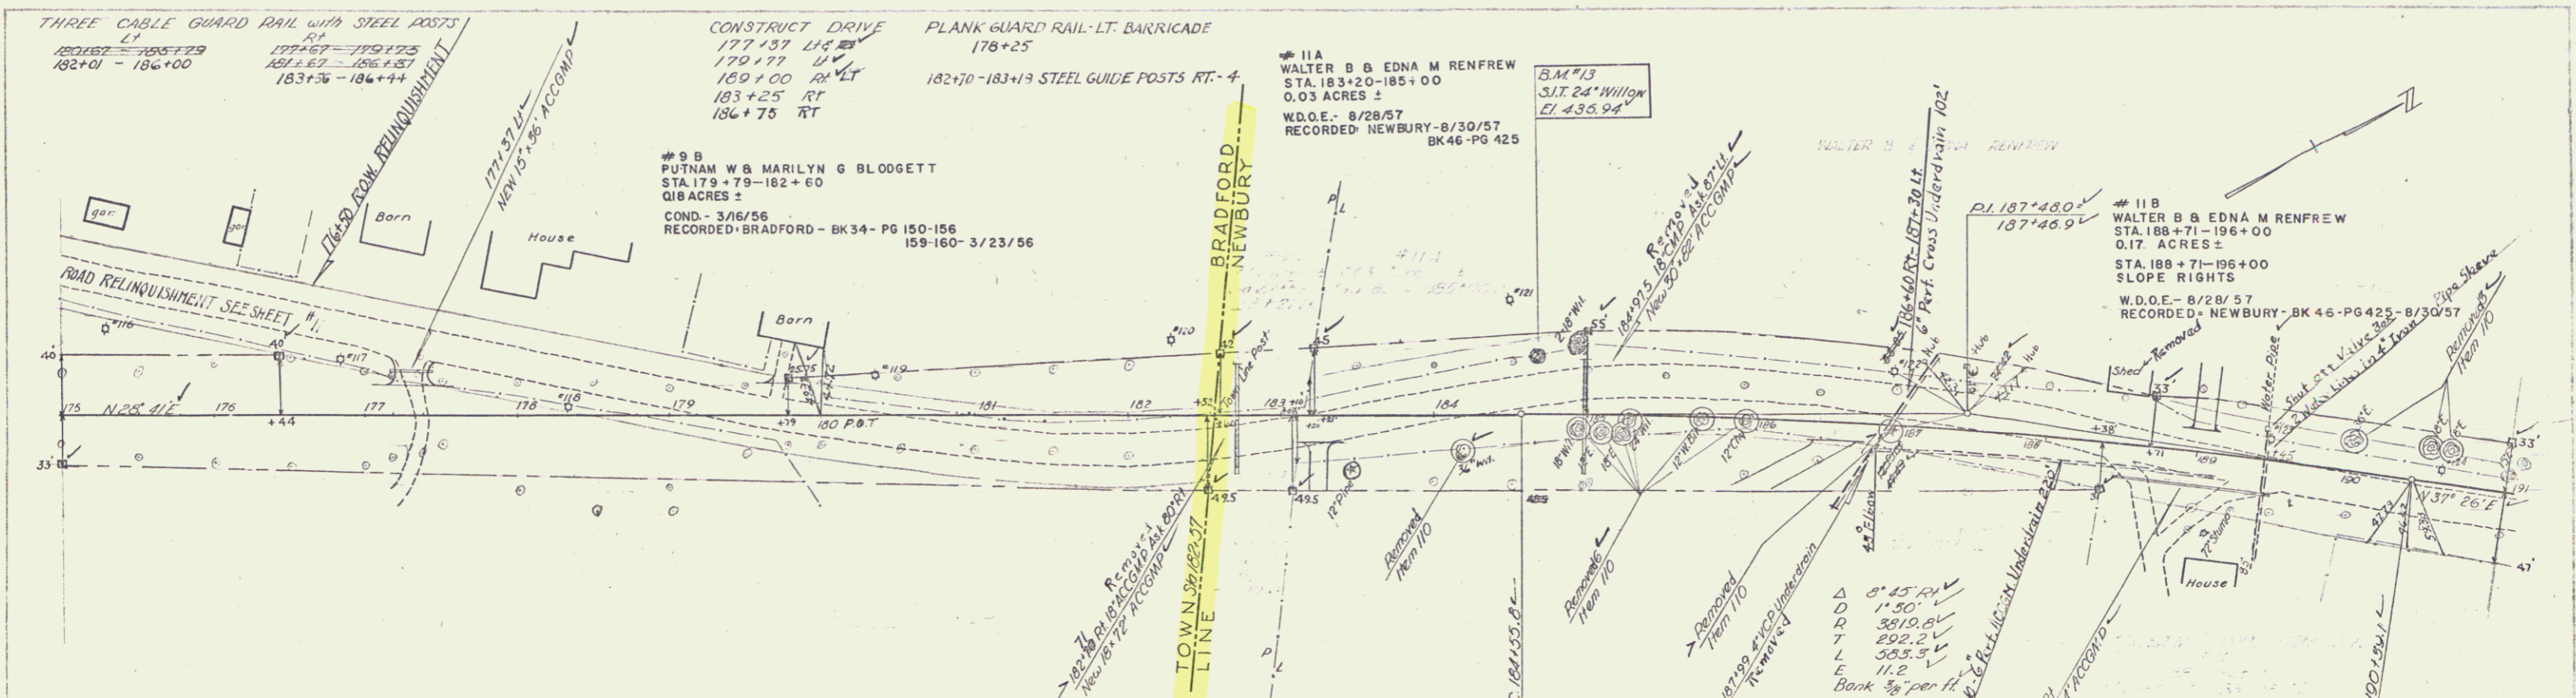

8/14
MILLER
6/14

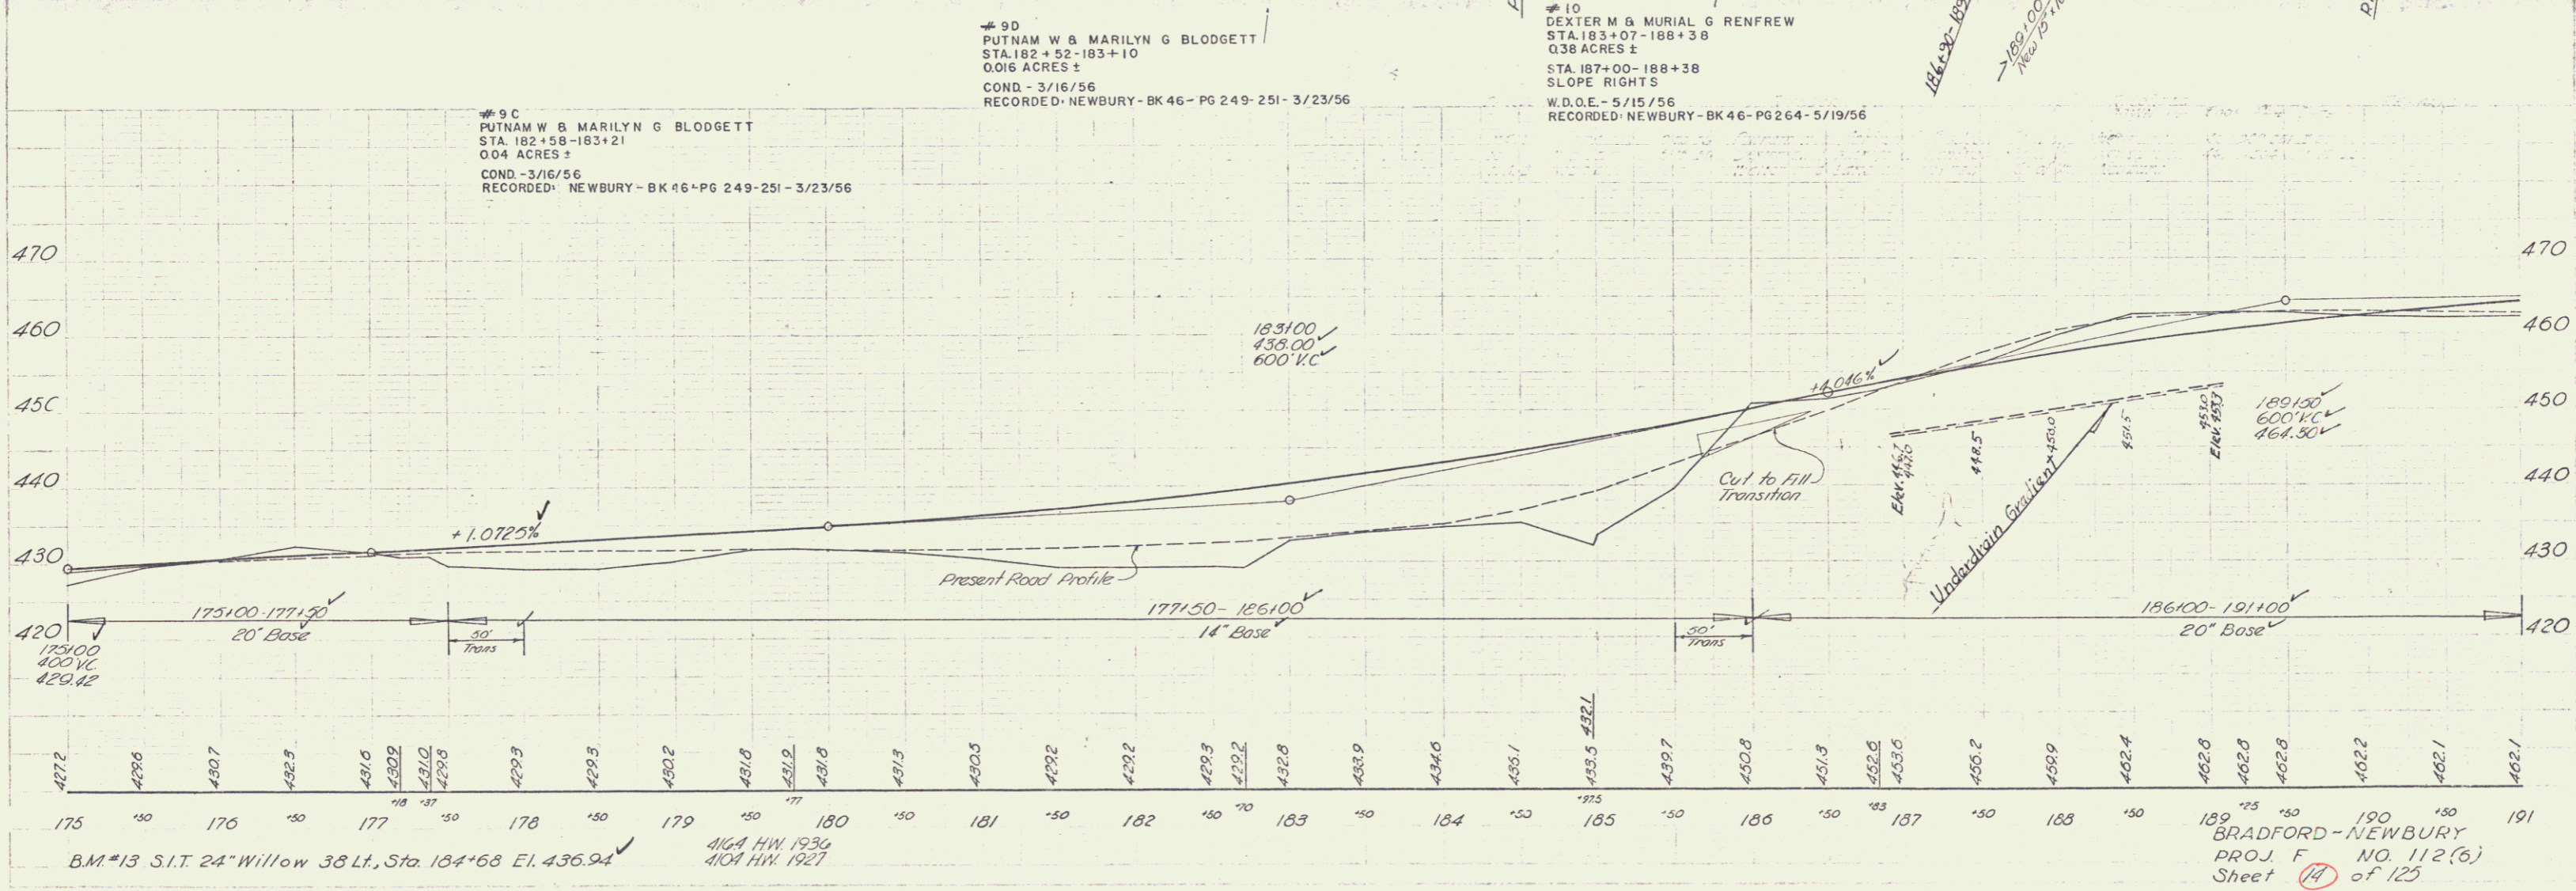

BRADFORD-NEWBURY
PROJ. F. NO. 112(6)
Sheet 14 of 125