


SPALLING MILLER
5/54
6/54
MILLER
TRACED



SPALLING MILLER
5/54
6/54

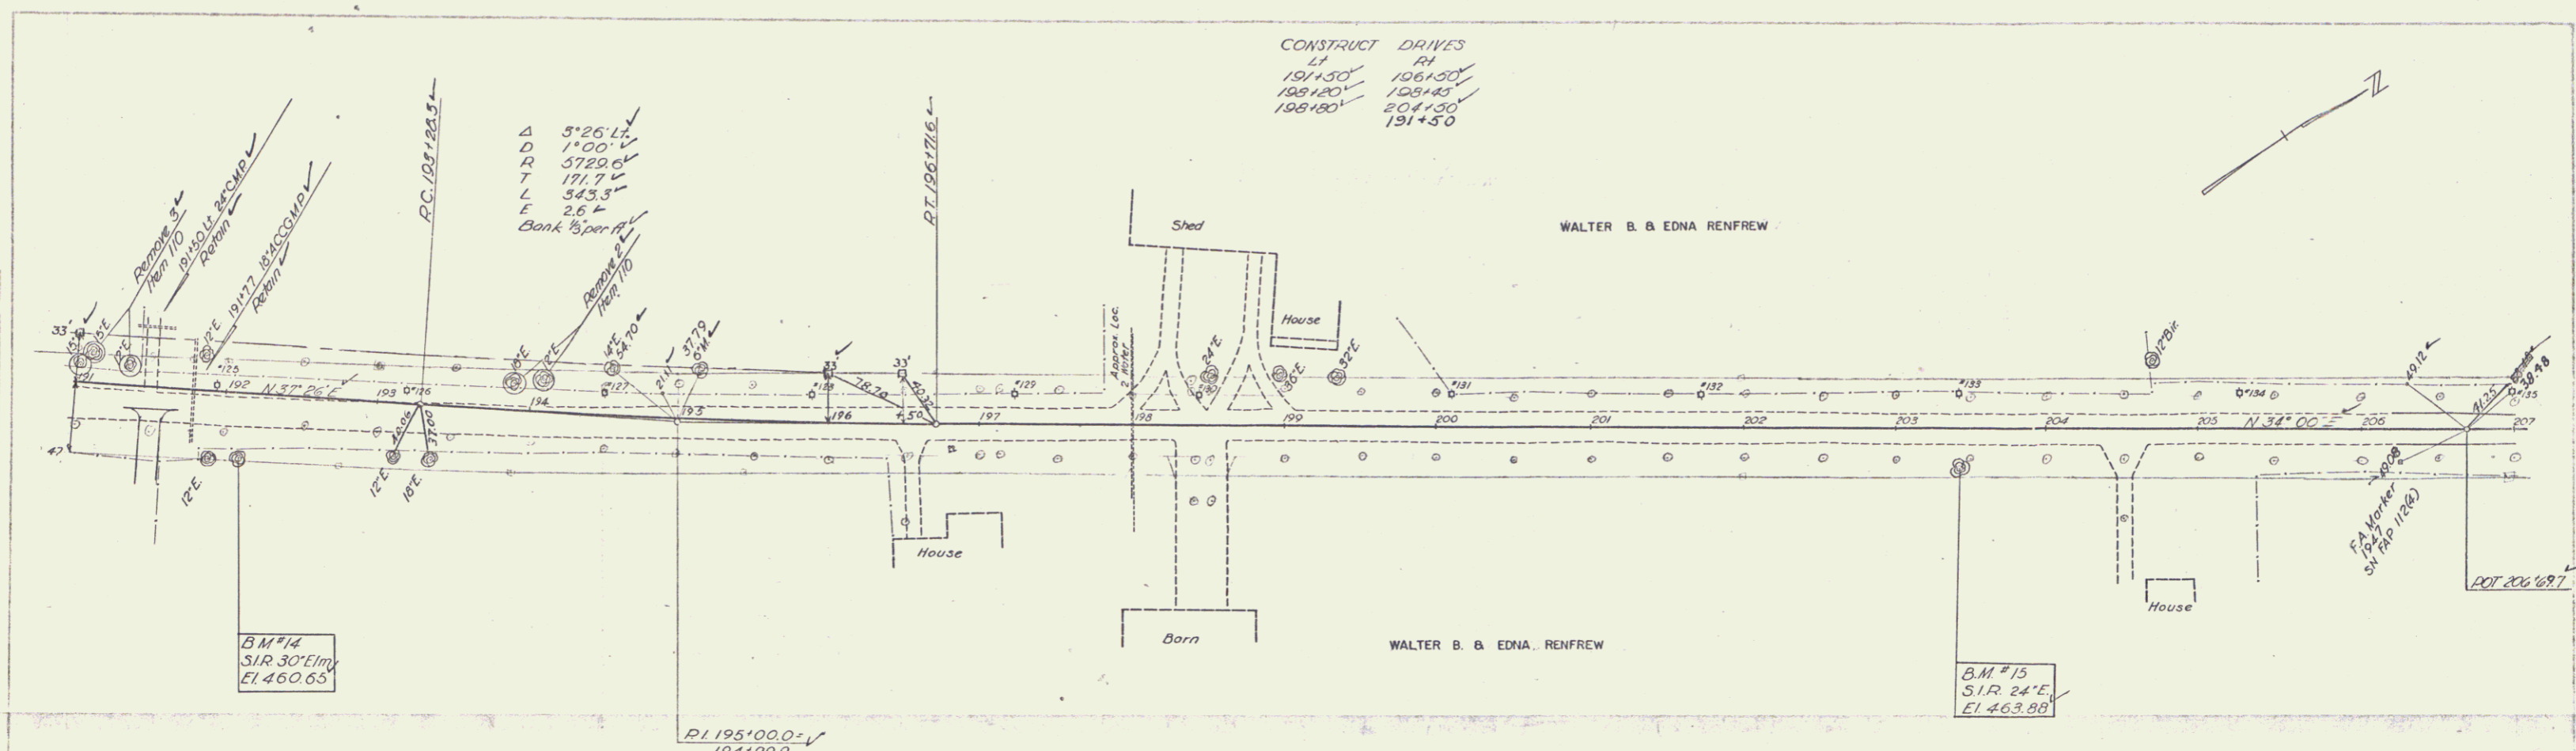