


RIGHT-OF-WAY DIVISION
TOWN FILE
PERPETUAL
Town of Newbury (Dist 7 plan)
(To Be Returned To R.O.W. Division)

Route us 5
Project: ST 41-3(L)
Pin # 99R 275
1/1/64

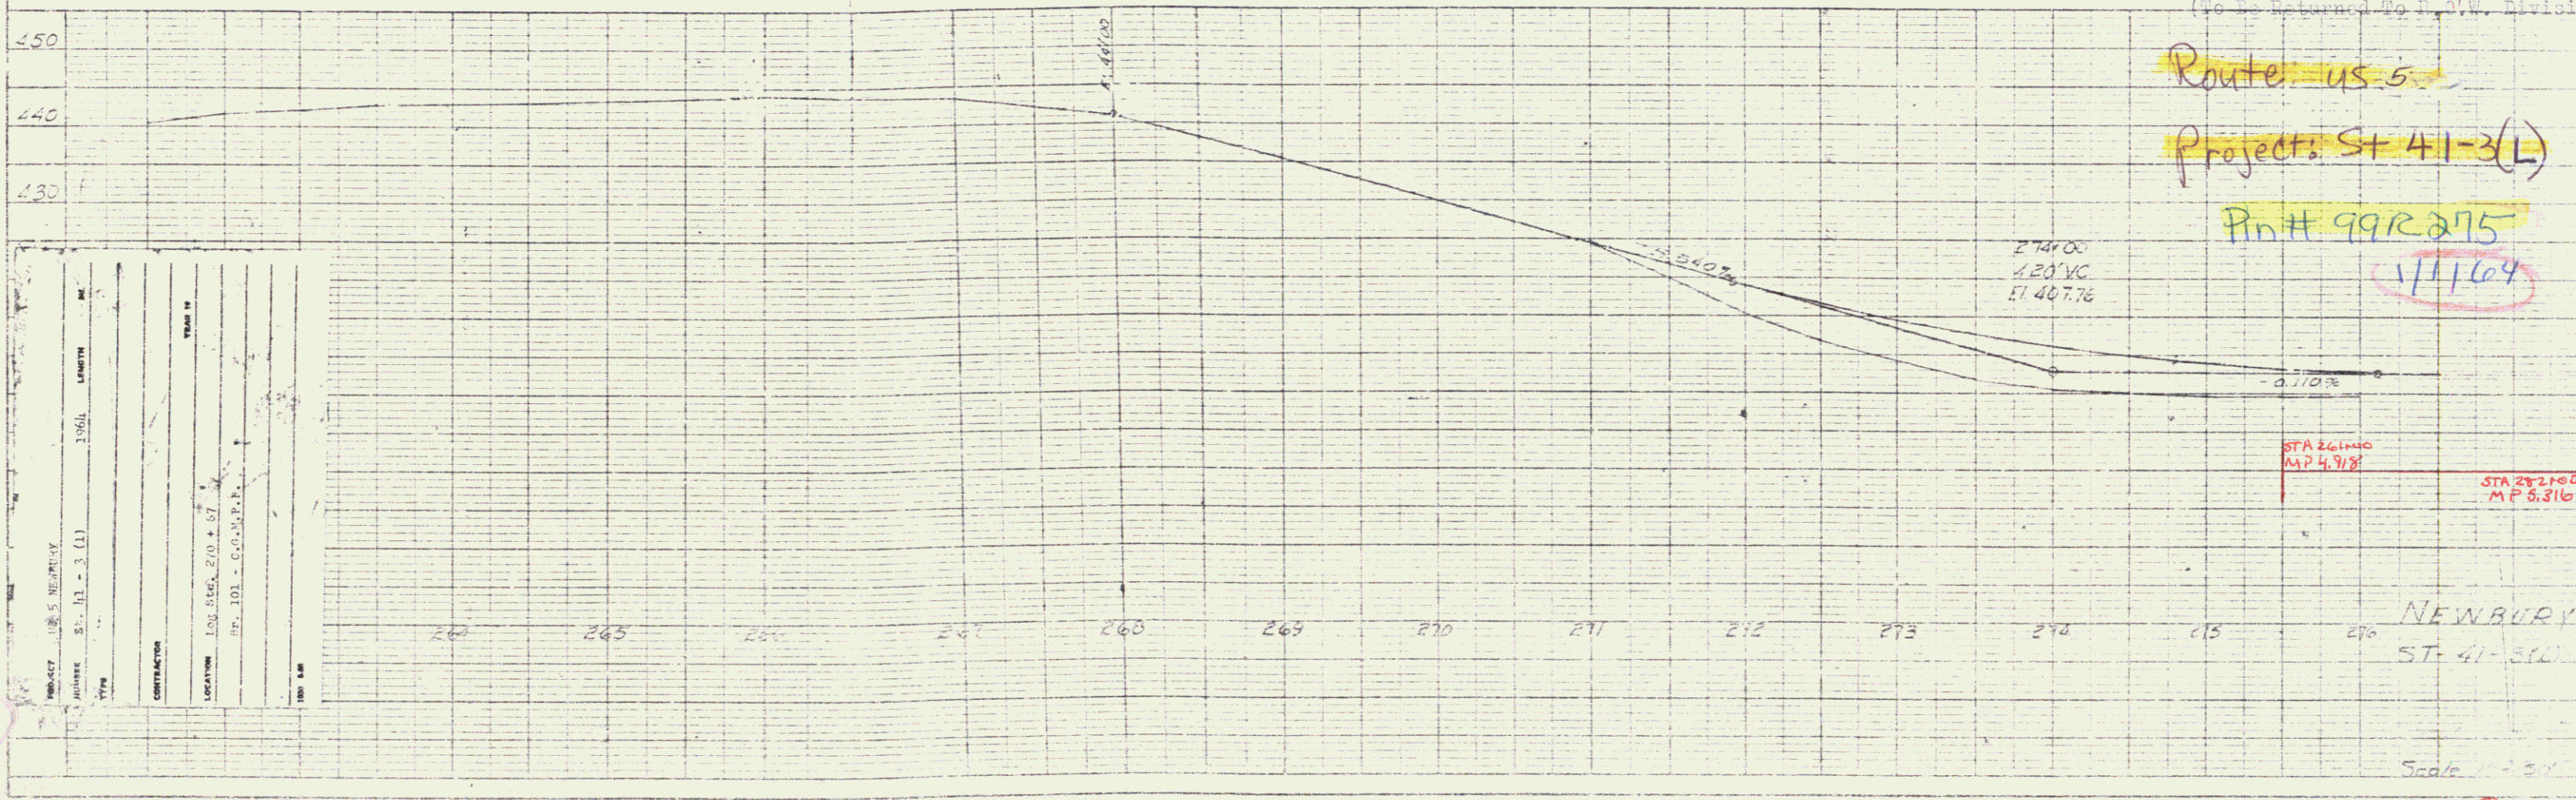

PROJECT	US 5, Newbury
DATE	5-11-64
DESIGNED BY	1964
CONTRACTOR	
LOCATION	Log. 266, 270 + 57
REF.	101 - C.O.D. P.P.