


PARCEL	KIND OF DATE OF IMPROVEMENT	GRANTOR	GRANTEE	RECORDED	REMARKS
A-B	O.C.D.	11-30-36 C.V. ROYER & TRUMAN POWELL	STAFF	19 227	12-3-36
A'	O.C.D.	9-19-36 HARRY THAYER	"	19 231	9-23-36

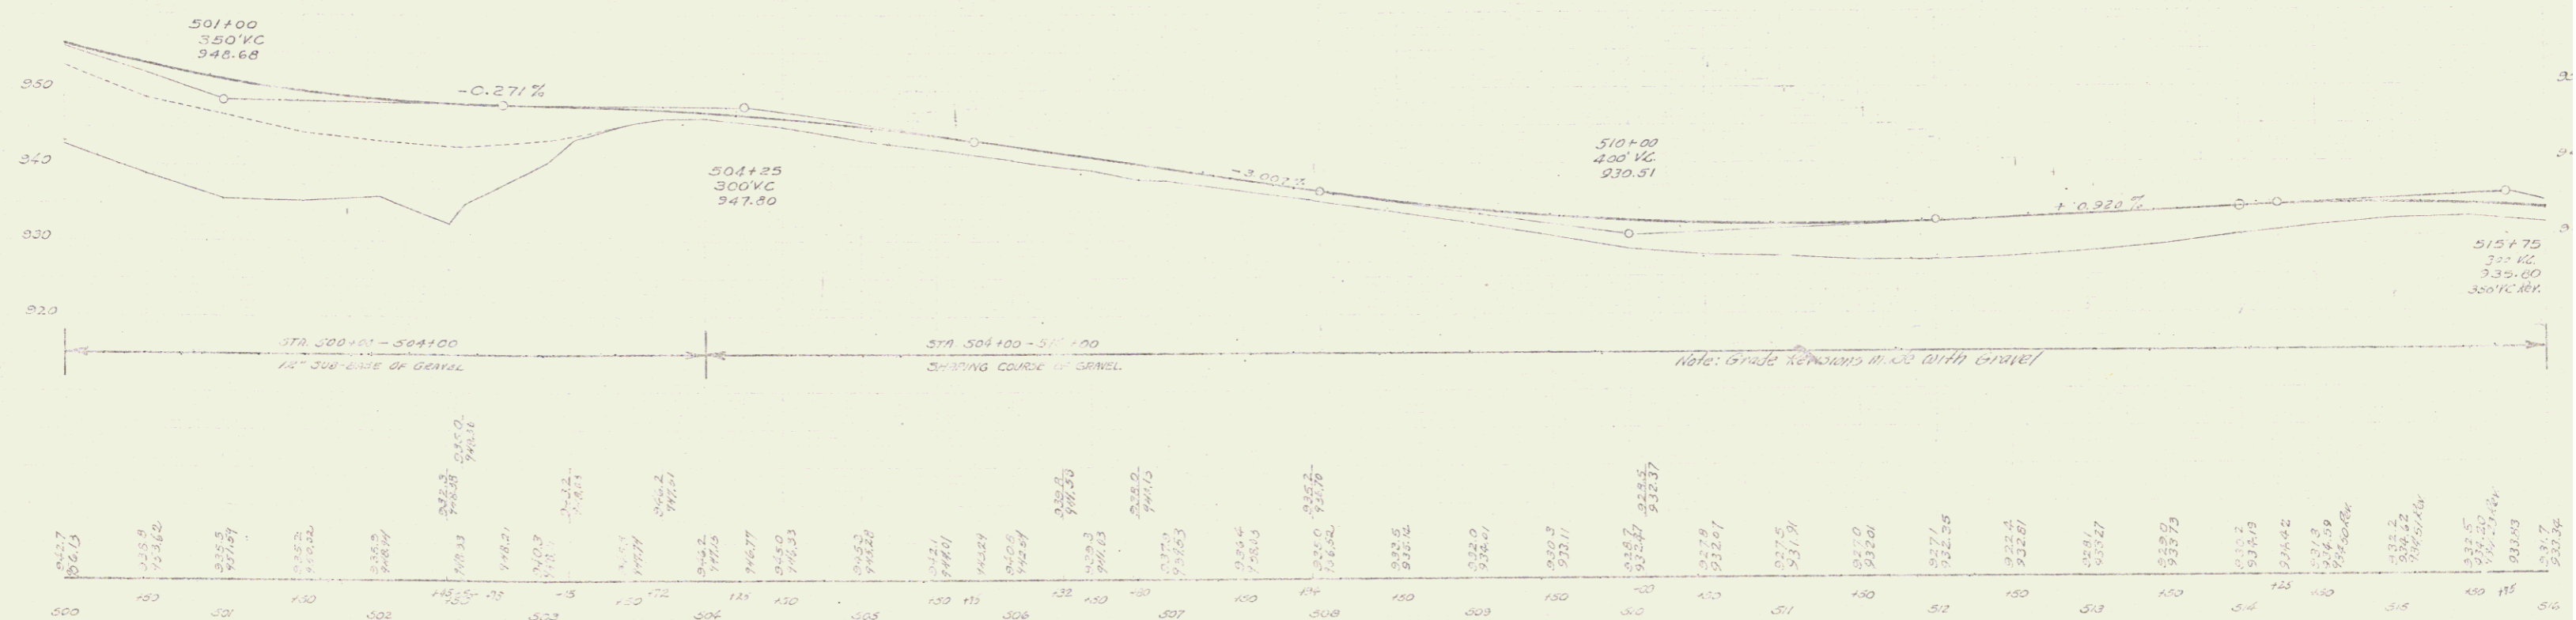

B.M. 23 BAKE IN ROOT OF 18" ELM 23 FT. LT. OF STA. 50+60 ELEV. 937.29