


$K=7474$
 $D=2546$
 $P=173$
 $L=3459$
 $E=59$

Sub-Soil Data
Key:
 PD = Push Down Mark
 H.S. = HARD SAND
 F.S. = FINE SAND
 C = CLAY
 G = GRAVEL
 S = SAND

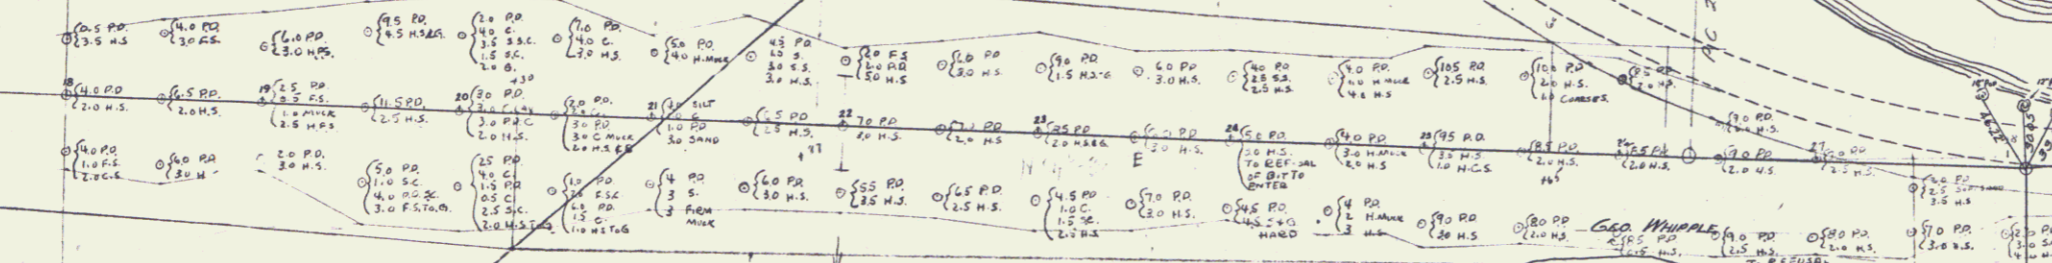

$A=1.82281$

BM 2
 201.00
 11.62281

