

WOOD GUARD RAIL REQUIRED

CURVE STATION	LEFT	RIGHT
46+50	-	24
57+83	24	24

CABLE GUARD RAIL REQUIRED

STATIONS	LEN	CONSTANT	PIV LENGTH
46+50-50+00	45	20	261
40+75-50+00	9	20	104
51+82-55+38	43	20	261
44+68-46+15	17	20	104
51+58-51+82	24	20	147



NEW CAST IRON PIPE CONCRETS REQUIRED

STATION	DIA	LEN	CONC	CONC	PIPE	STEEL
46+50	15"	45'	14.4'	-	6912 lbs	-
57+83	15"	45'	14.4'	-	6912 lbs	-

COCKING GALV METAL DRIVEWAY PILES REQUIRED

Station	Diam	Len	cem	Ref	Met
57+50	12"	25'	12.5'	12.5'	30

Parcel	Kind of Instrument	Date of Grant	Grantor	Grantee	Recorded	Remarks
A	G.C.D.	7-6-31	W.L. LAWSON	Staff	Book Page Date	
A's c'	G.C.D.	7-17-31	LUCIEN E. TEBERGE	17	308	8-2-31

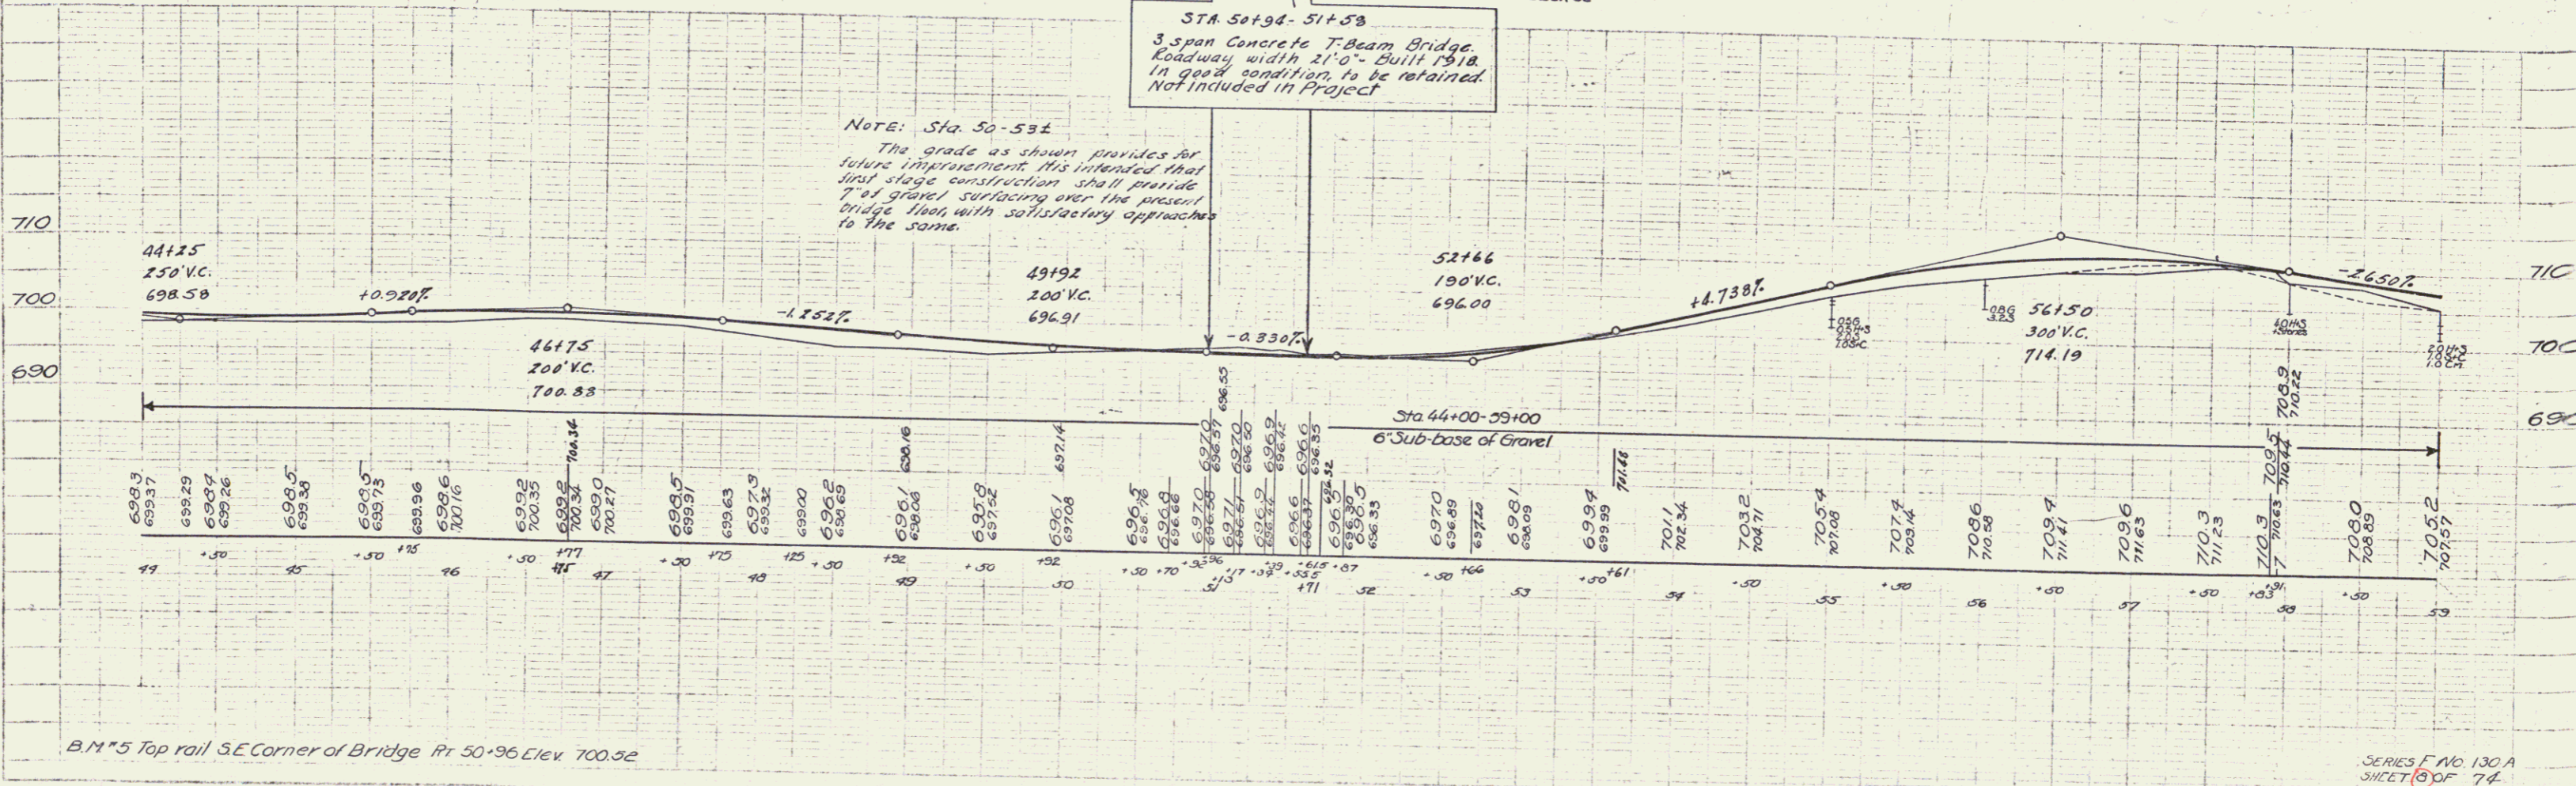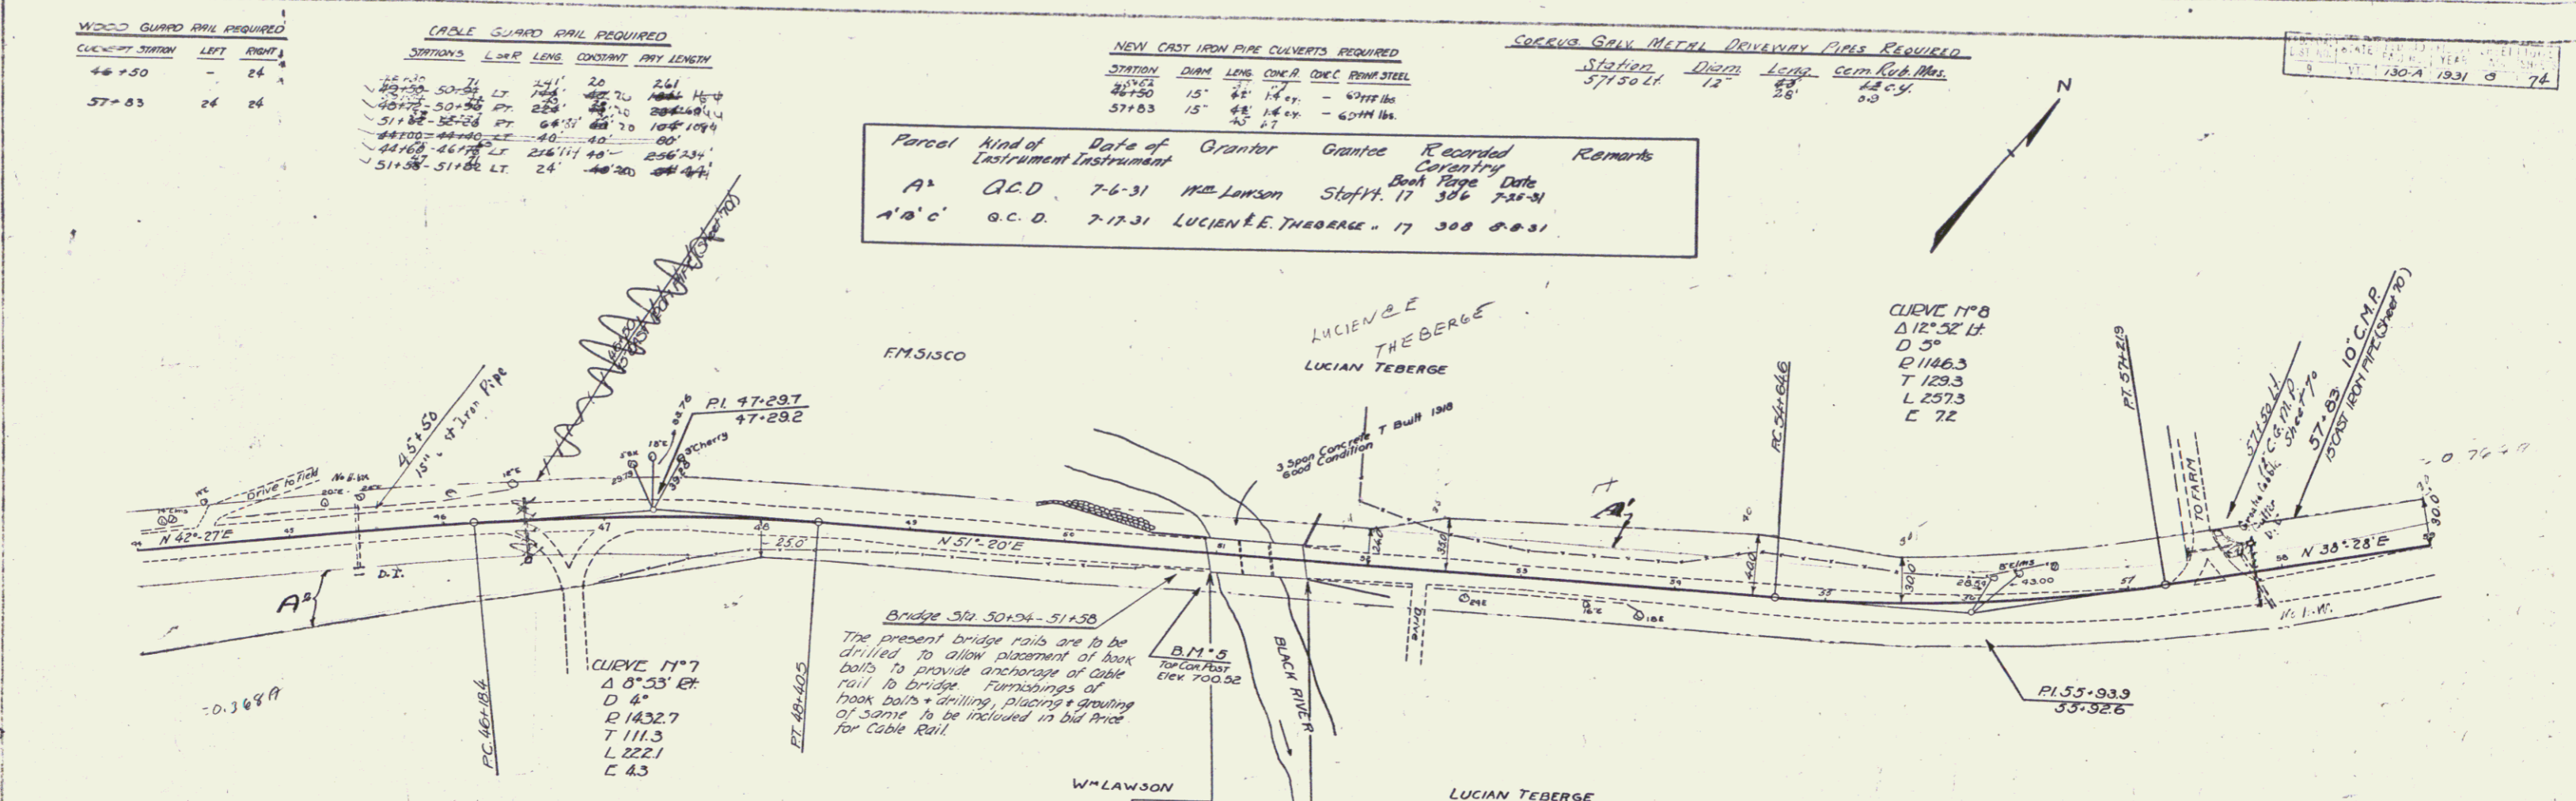

B.M. #5 Top rail S.E. Corner of Bridge Pt. 50+96 Elev. 700.52