
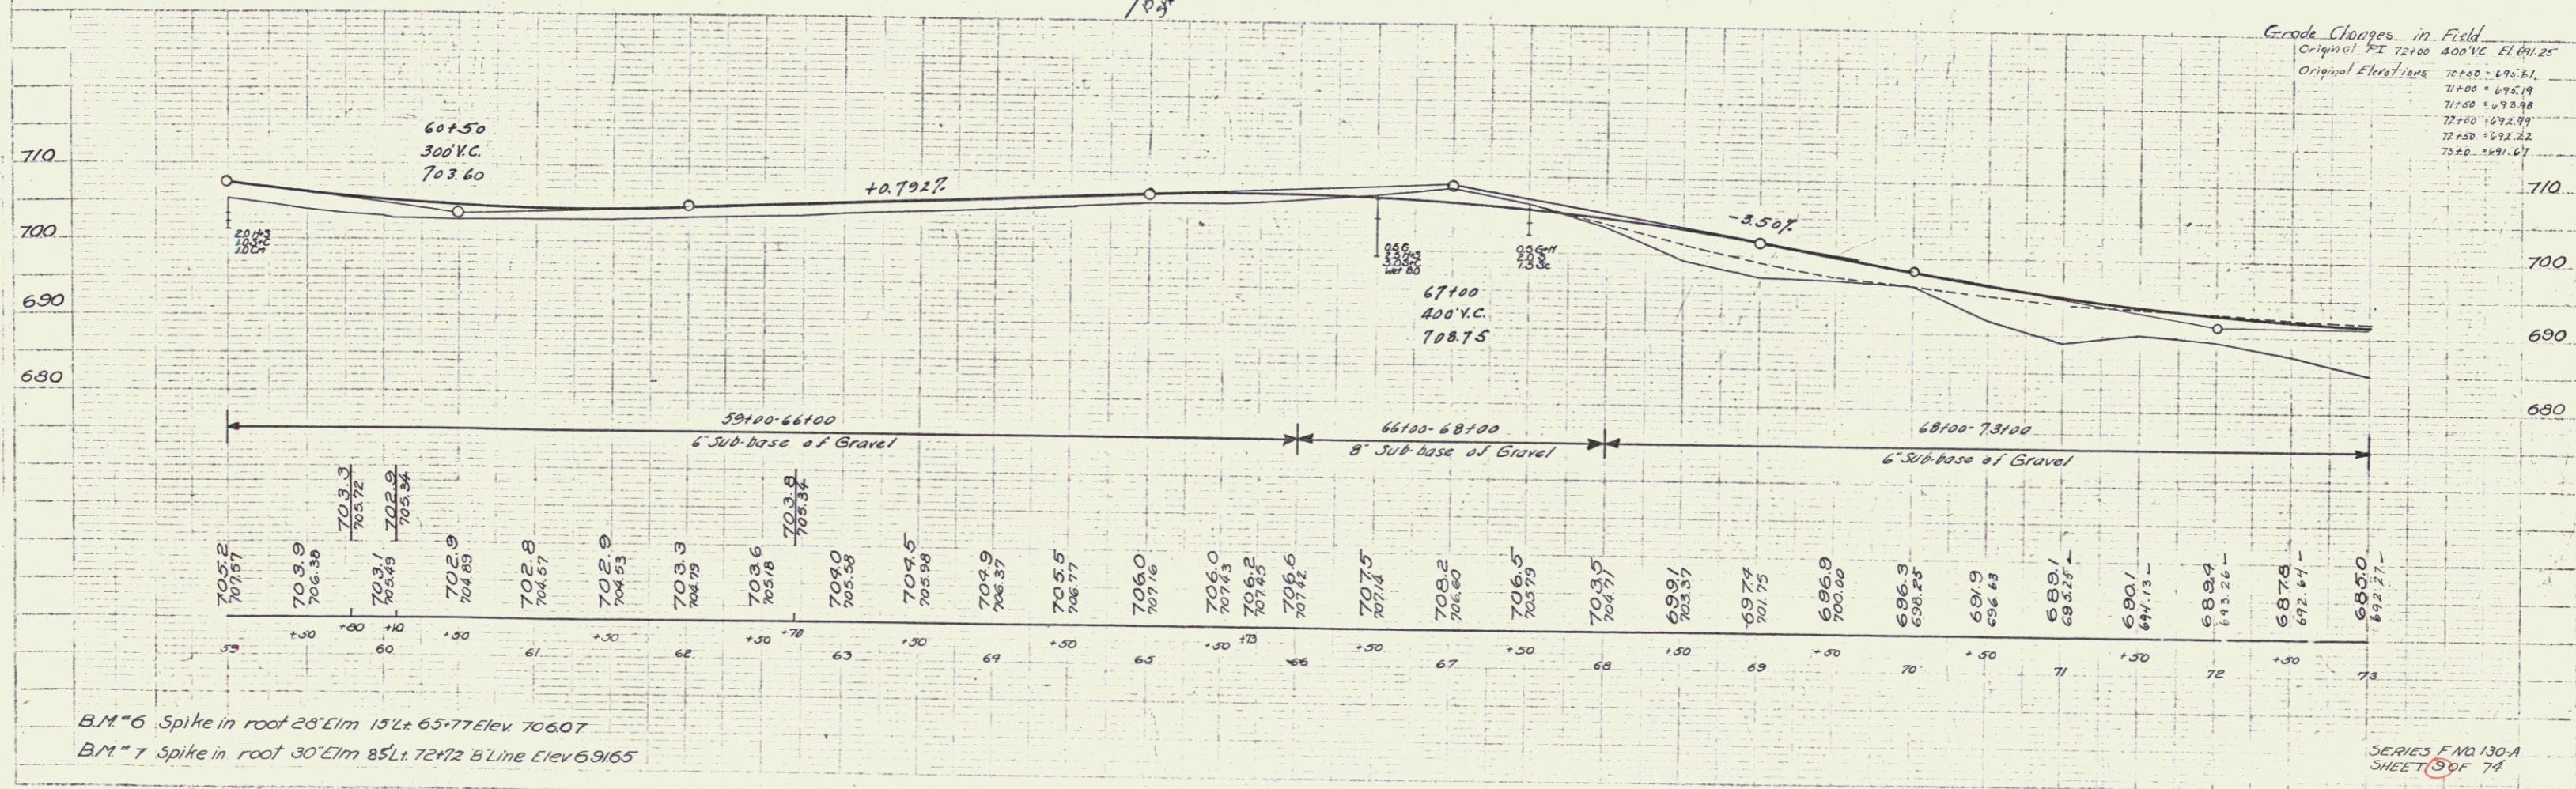


WOOD GUARD RAIL REQUIRED			CABLE GUARD RAIL REQUIRED				NEW CAST IRON PIPE CULVERTS REQUIRED						
CULVERT STATION	LEFT	RIGHT	STATION	LOP	LENS	CONSTANT	PI LENGTH	STATION	DIAM	LENG	CONC. P.	CONC. C.	REIN. STEEL
60+10	26'	-	59+66-63+42	RT	376'	40'	416'	60+10	15"	25'	14"	4"	300# 15#
62+71	26'	-	65+84-66+29	RT	96'	40'	136'	62+71	15"	42'	12"	4"	400# 15#
65+73	26'	-	65+84	RT	17'	37'	137'	65+73	15"	54'	-	3.0"	200# 14#

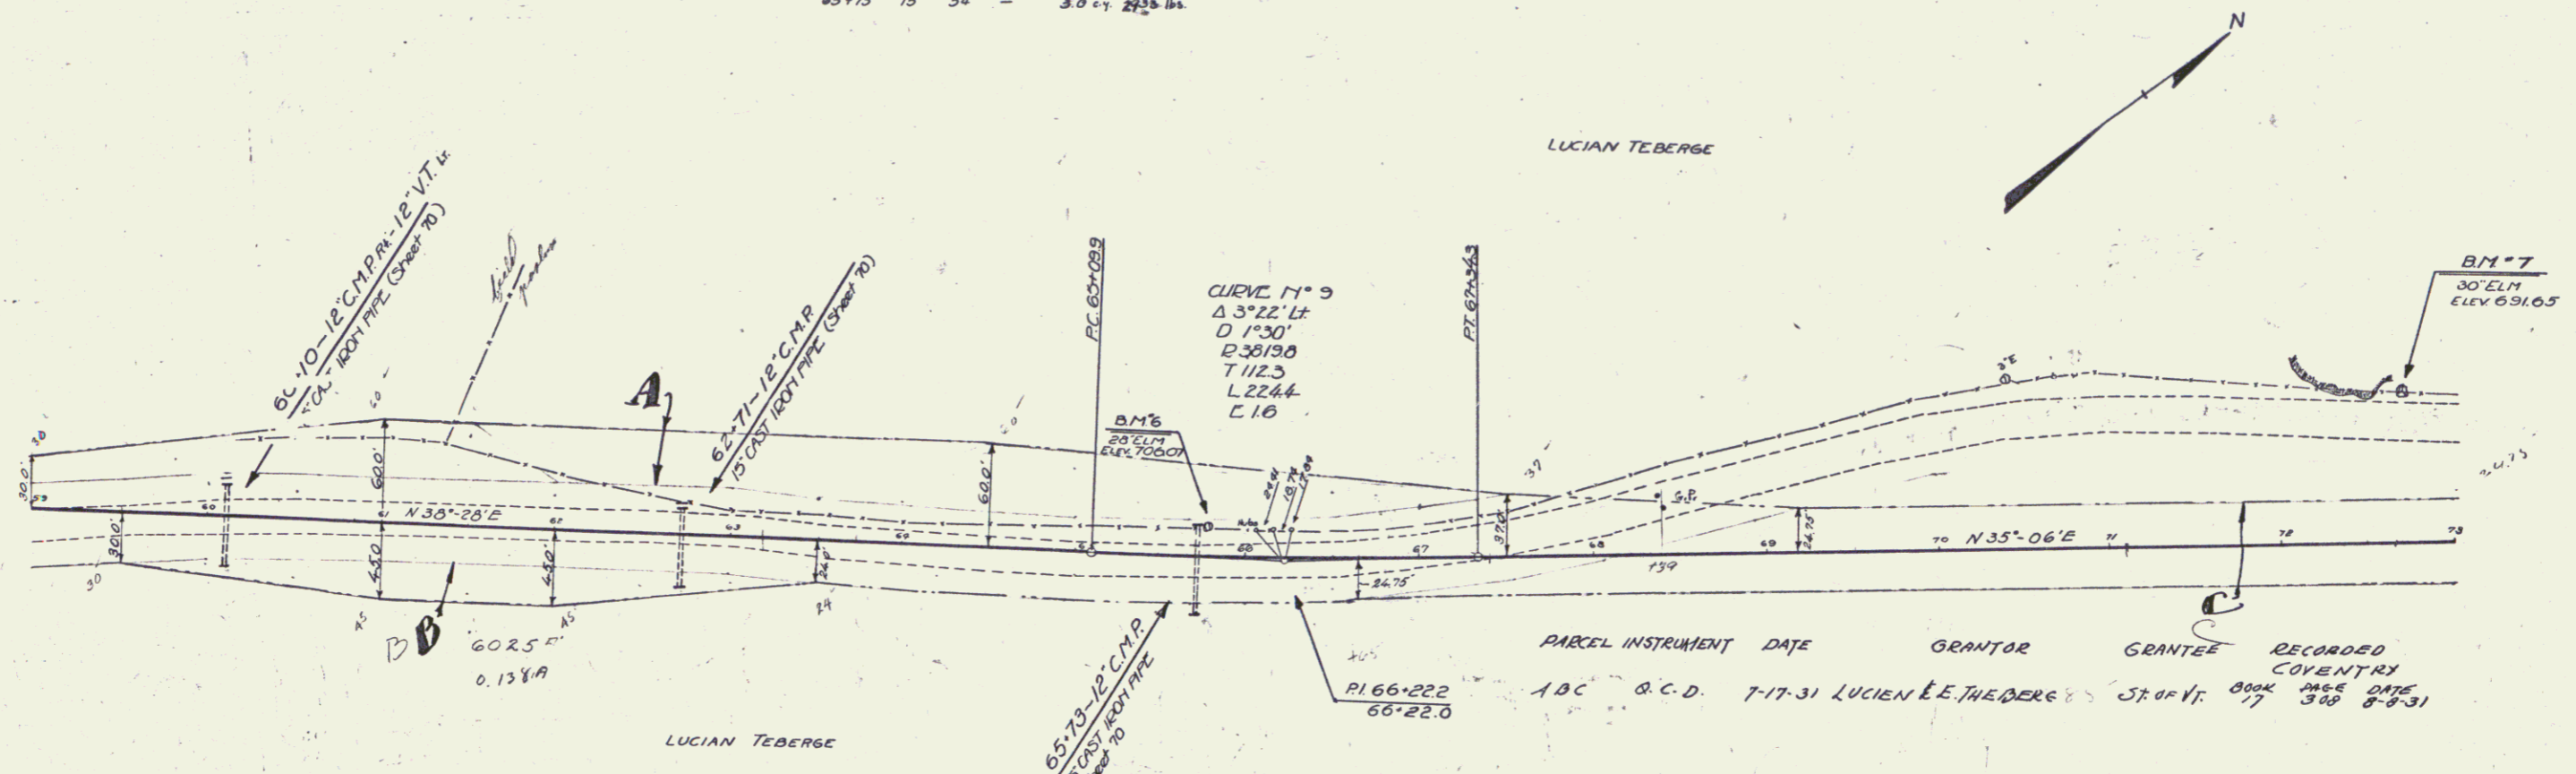

BM*6 Spike in roof 28' Elm 15' Lt 65+77 Elev 70607
 BM*7 Spike in roof 30' Elm 85' Lt 72+72 Bl Line Elev 69165