



WOOD GUARD RAIL REQUIRED		
CLEVERT STATION	LEFT	RIGHT
151+00	24'	24'
162+64	24'	24'
152+00	24'	24'
153+43	24'	24'
164+72	24'	24'

Parcel	Kind of Instrument	Date of Instrument	Grantor	Grantee	Recorded	Remarks
C.D.F. A	Q.C.D.	6-30-31	Geo Lawson	St of W. 17	365	7-25-31
		1-12-35	Jennie Hancock	" "	385	1-14-35

NEW CAST IRON PIPE CURVES REQUIRED					
STATION	QUANT.	LENG.	CONC. PIPE	CONC. PIPE	PRICE PER
151+00	15'	42'	-	18"	18.00
152+00	15'	43'	-	18"	18.00
153+43	18'	69'	-	18"	18.00
162+64	15'	42'	1.6 ct.	18"	18.00
164+72	15'	45'	-	18"	18.00
166+64	15'	48'	-	18"	18.00

150-1000 STATE PROJ. NO. 130-A 1931 15 74

Wood Guard Posts  
 152+10 1  
 164+65 2  
 166+75 2

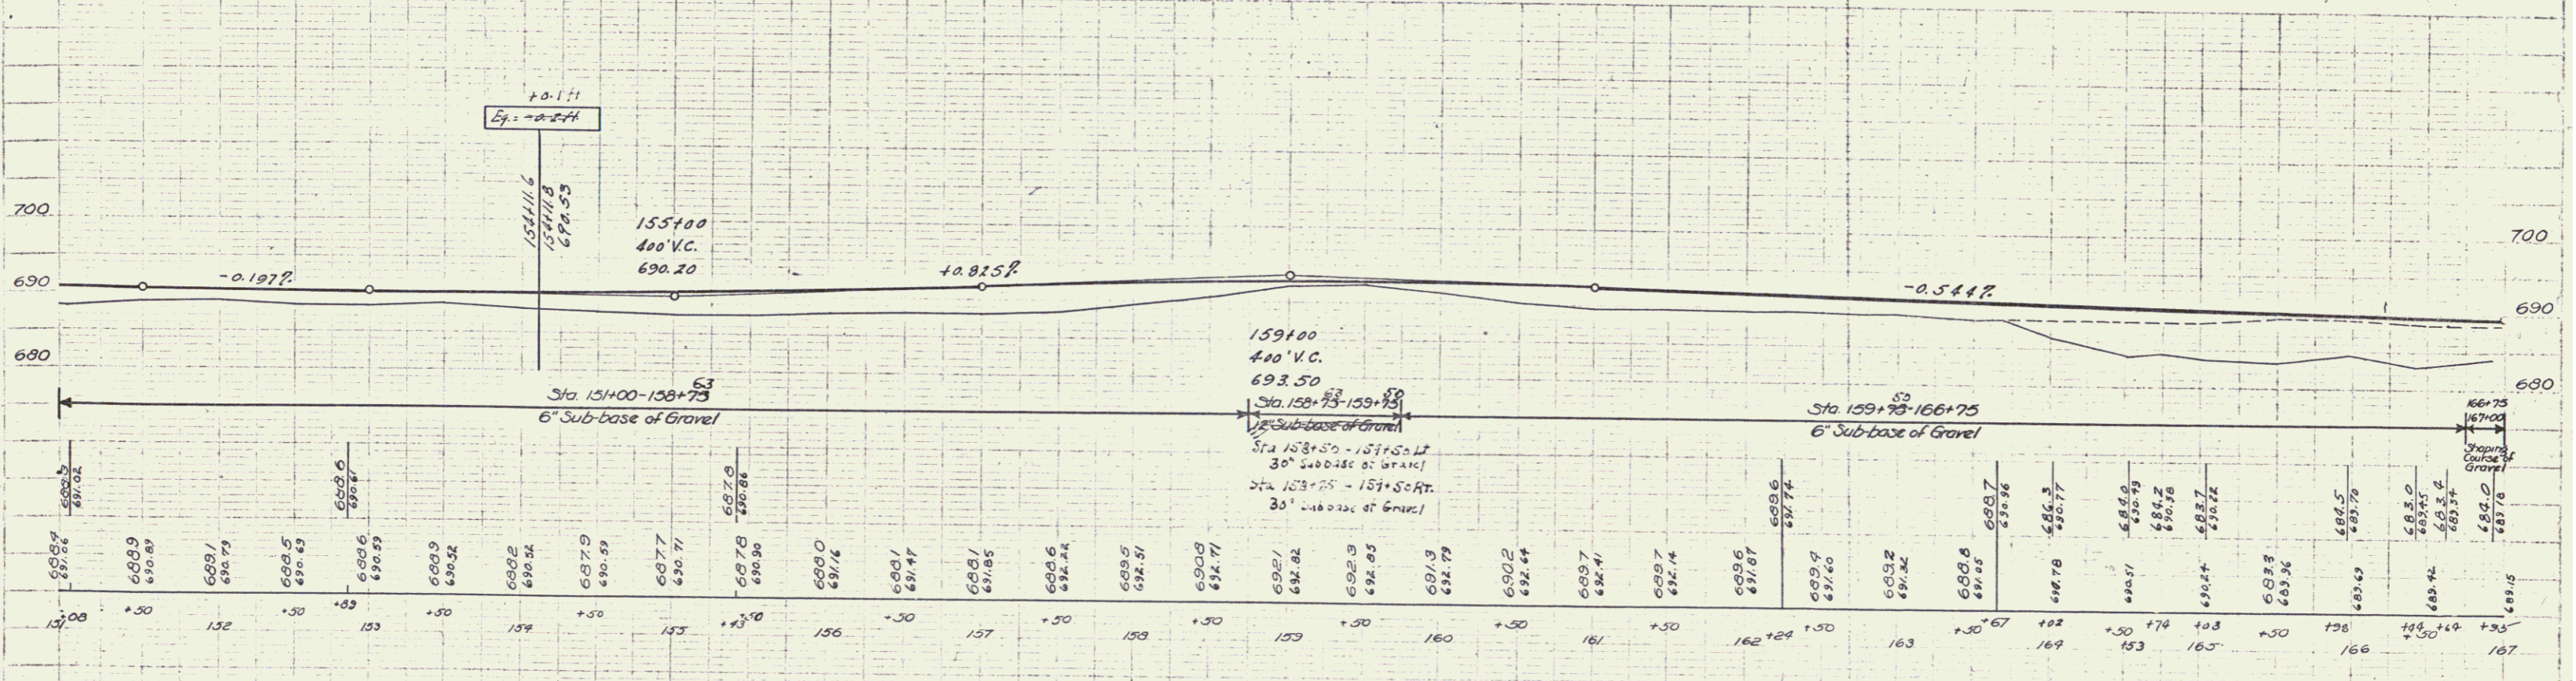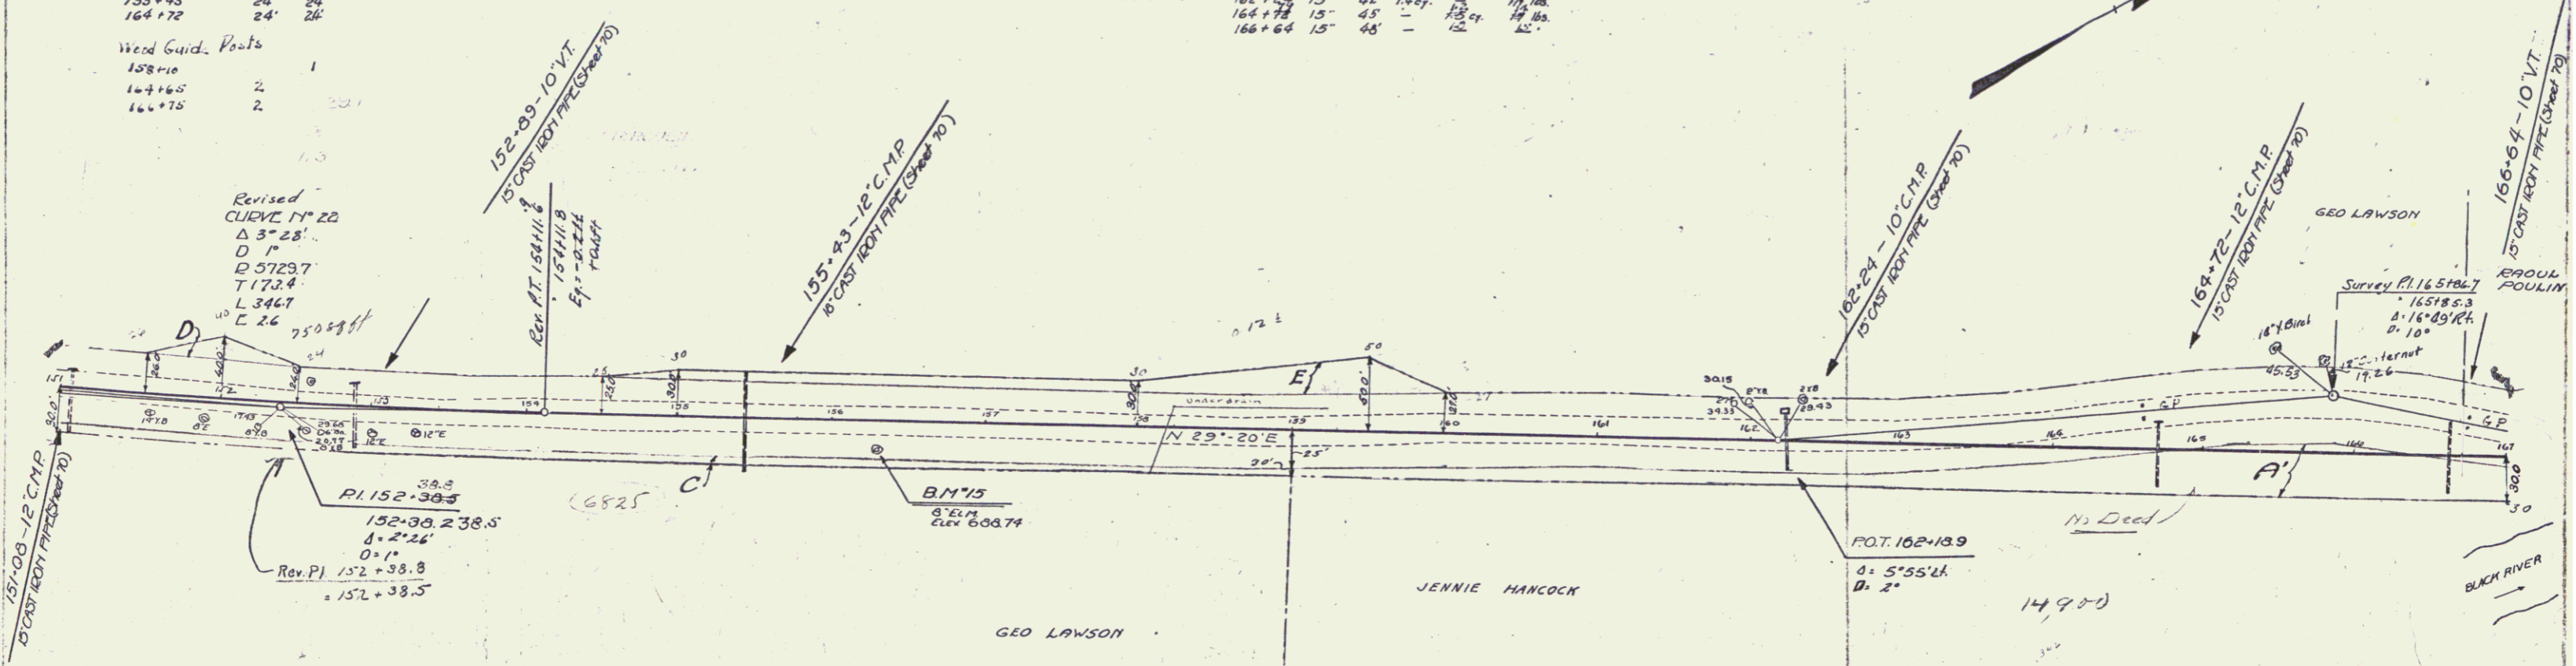

B.M. 15 Spike in trunk of Elm 16' Rt. 156+32 Elev 688.74

SERIES F. NO. 130-A SHEET 15 OF 74

16