

WOOD GUARD RAIL REQUIRED

CULVERT STATION	LEFT	RIGHT
174+50	24'	24'
179+00	24'	24'



CABLE GUARD RAIL REQUIRED

STATIONS	LEFT	RIGHT	CONSTANT	PI LENGTH
174+50-179+00	24'	24'	30'	375'
179+00-181+00	24'	24'	30'	375'

NEW CAST IRON PIPE CULVERTS REQUIRED

STATION	CHURN	LENG.	CONC. A	CONC. C	BRICK	STEEL	RUBBL.
174+50	15'	53"	-	2"	12"	12"	12"
179+00	15'	53"	14"	2"	12"	12"	12"

Parcel	Kind of Instrument	Date of Instrument	Grantor	Grantee	Recorded Conveyance	Book Page	Date	Remarks
A'	Q.C.D.	1-12-35	Jennie Hancock	Sloft H.	16	385	1-14-35	
A	"	6-30-31	Rosalie Poulin	"	17	303	7-25-31	
A' & B'	"	6-30-31	L.S. Morrill	"	17	196	7-25-31	

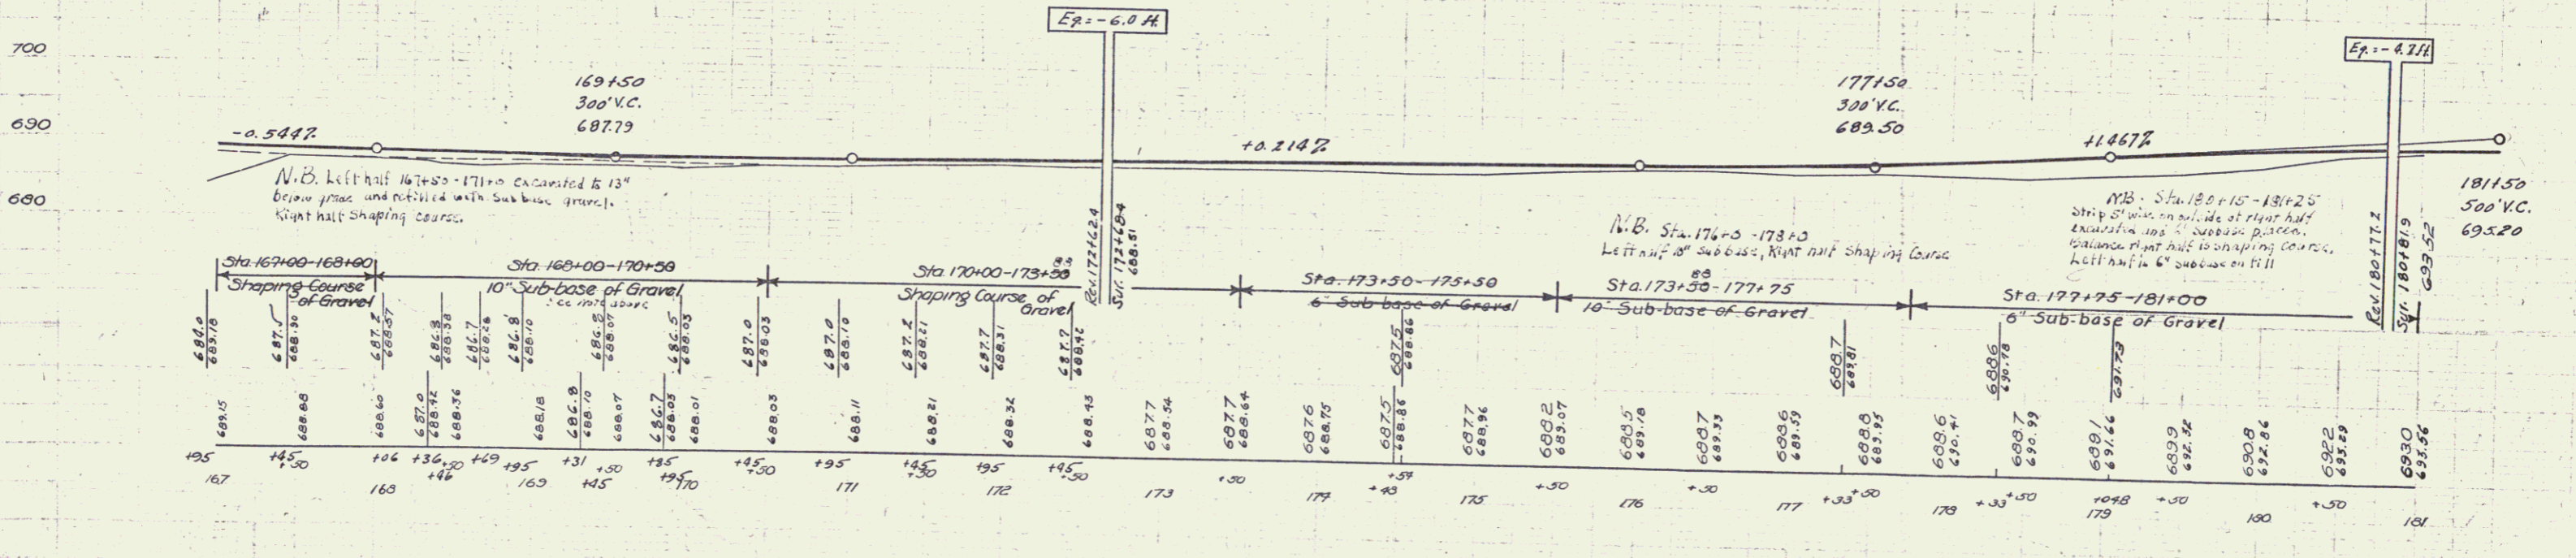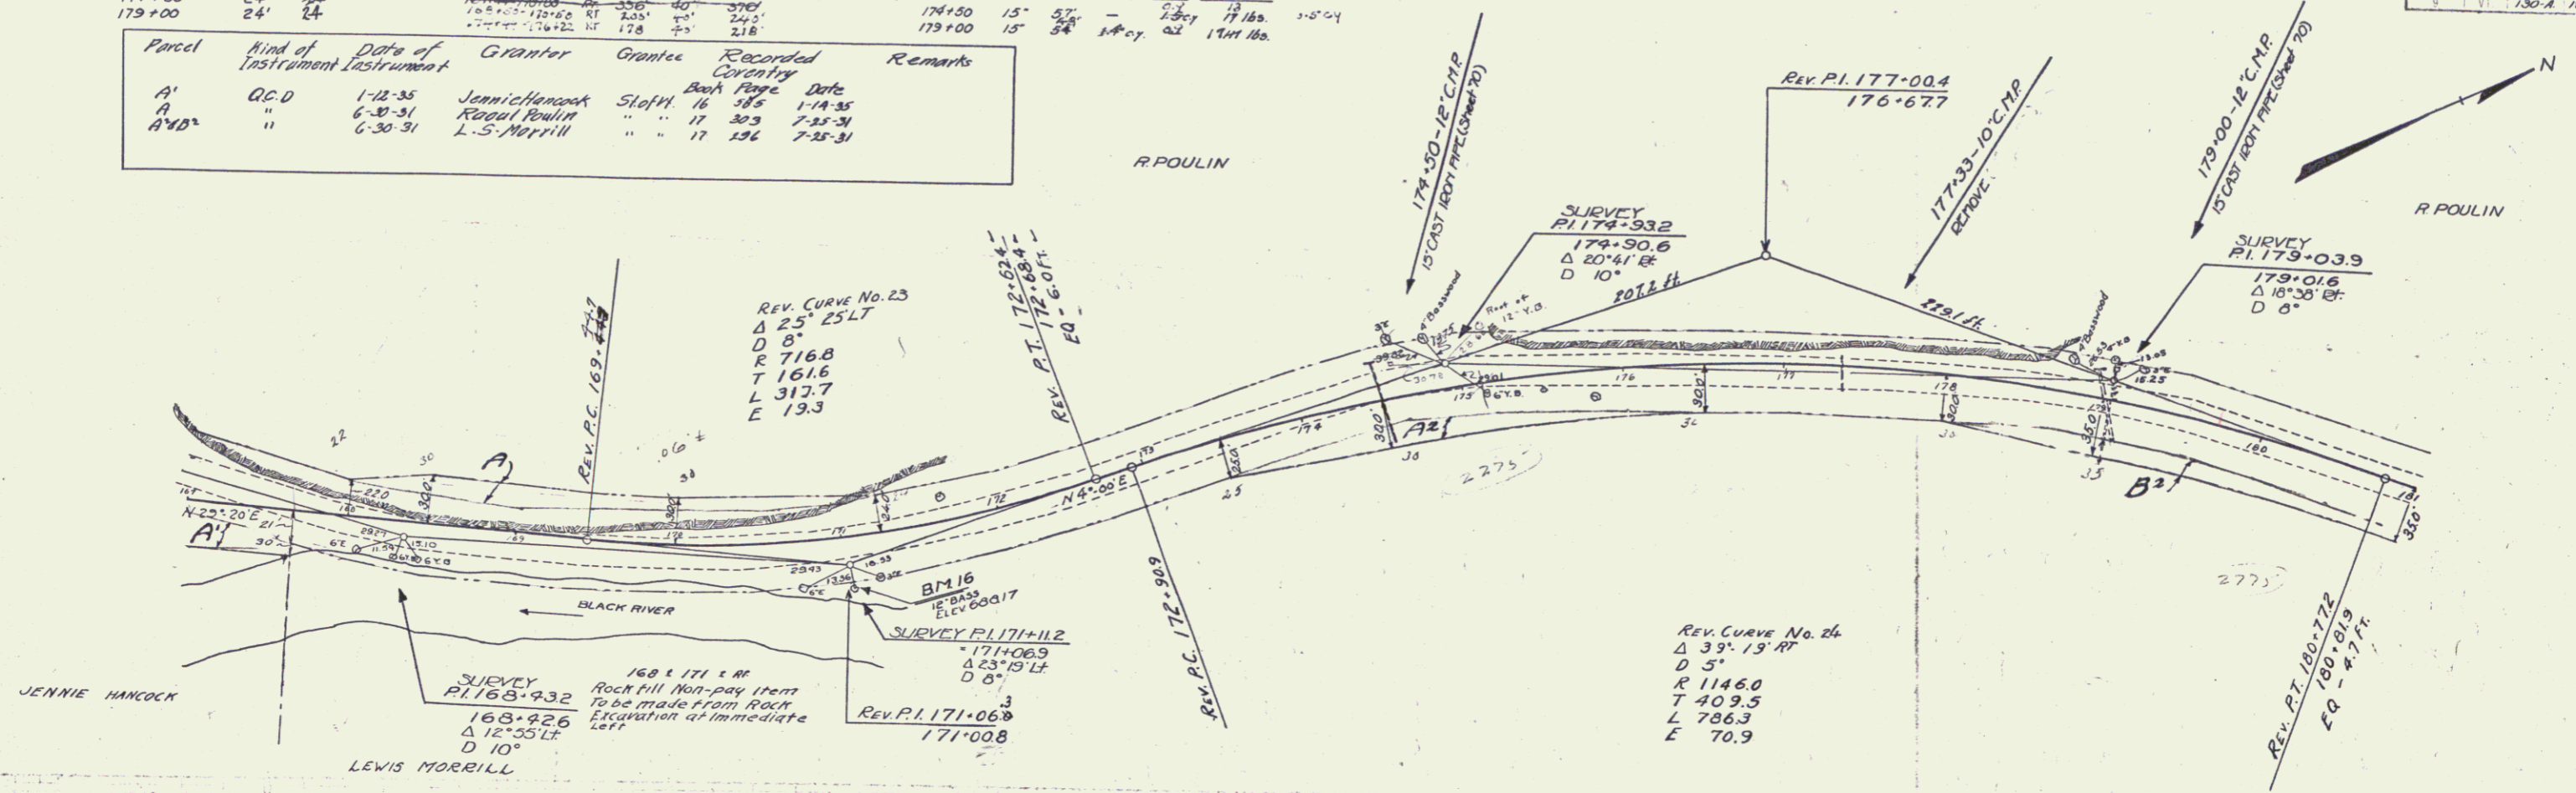

Sta.	Sub-base of Gravel	Shaping Course of Gravel	Sta.	Sub-base of Gravel	Shaping Course of Gravel	Sta.	Sub-base of Gravel	Shaping Course of Gravel	Sta.	Sub-base of Gravel	Shaping Course of Gravel
167	687.15	687.15	171	688.11	688.11	175	688.94	688.94	179	689.75	689.75
168	688.00	688.00	172	689.32	689.32	176	689.57	689.57	180	690.7	690.7
169	688.60	688.60	173	689.77	689.77	177	689.59	689.59	181	691.56	691.56
170	689.07	689.07	174	690.12	690.12	178	690.7	690.7			
171	689.47	689.47	175	690.46	690.46						
172	689.82	689.82	176	690.82	690.82						
173	690.12	690.12	177	691.15	691.15						
174	690.47	690.47	178	691.46	691.46						
175	690.77	690.77	179	691.76	691.76						
176	691.07	691.07	180	692.06	692.06						
177	691.37	691.37	181	692.36	692.36						
178	691.67	691.67									
179	691.97	691.97									
180	692.27	692.27									
181	692.57	692.57									

B.M. 16 Spike in root 12" Basswood 26' Rt. 177+13. Elev. 688.17