


B.M. No. 25 Spike in roof of Elm - 10' 21" 244+117.5 Elev 692.50

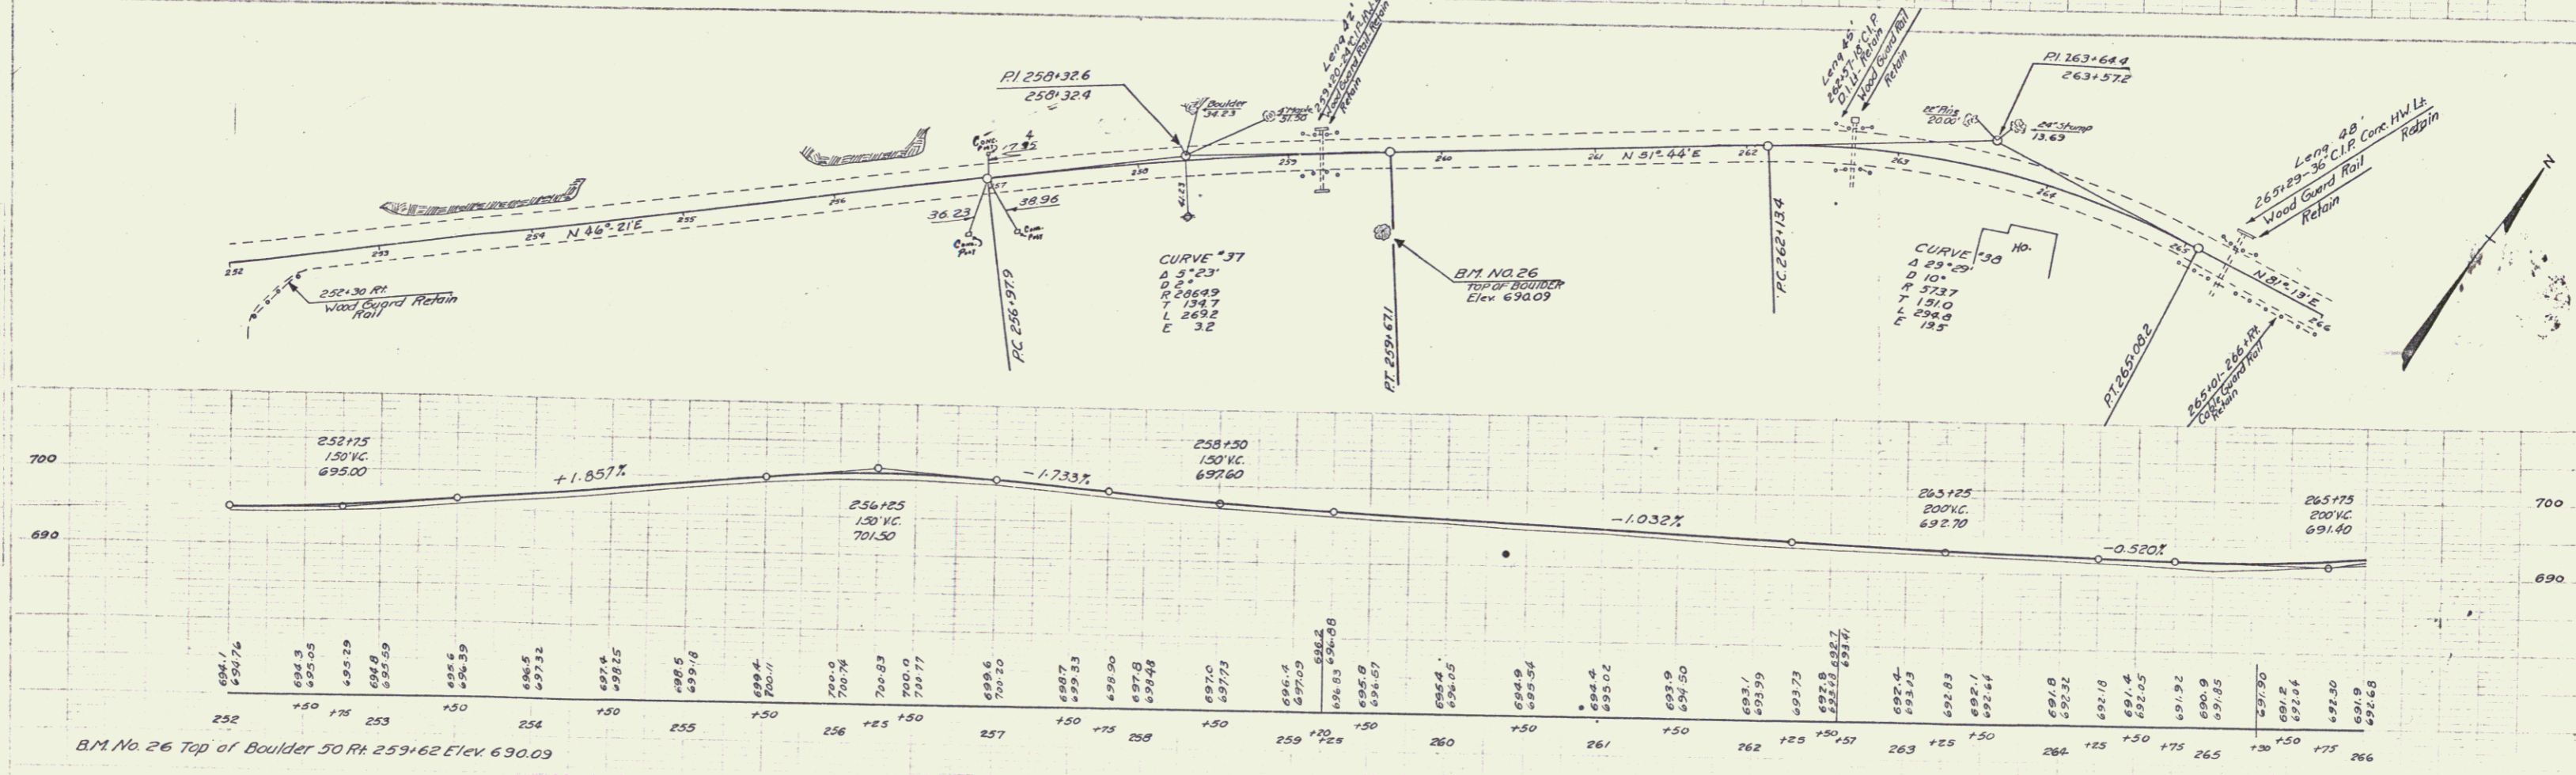

B.M. No. 26 Top of Boulder 50 Ft 253+62 Elev 690.09