


DIST. NO.	STATE	PROJ. NO.	YEAR	TOTAL SHEETS
9	VT			

PLAN
 W. E. NILES
 G. E. BOYTON
 C. F. BOYTON
 CONGREGATIONAL CHURCH
 TOWN OF COVENTRY
 J. G. TURNBULL
 HENRY GOSS
 H. M. MANCOCK
 CONGREGATIONAL PARSONAGE
 R. J. JONES
 STORE HOUSE
 R. J. JONES
 HOUSE
 L. W. HAUSER
 STORE G. J. BENWARE
 MRS. CARBEE
 MRS. MUNGEON
 E. NOLETTE
 BLACK SMITH SHOP
 HORSE SHEDS
 CONGO. CHURCH
 MRS. TATE
 GRANGE HALL
 ED. OLIPHANT
 RE. JONES
 HOUSE
 STORE HOUSE
 R. J. JONES
 HOUSE
 L. W. HAUSER
 STORE G. J. BENWARE
 MRS. CARBEE

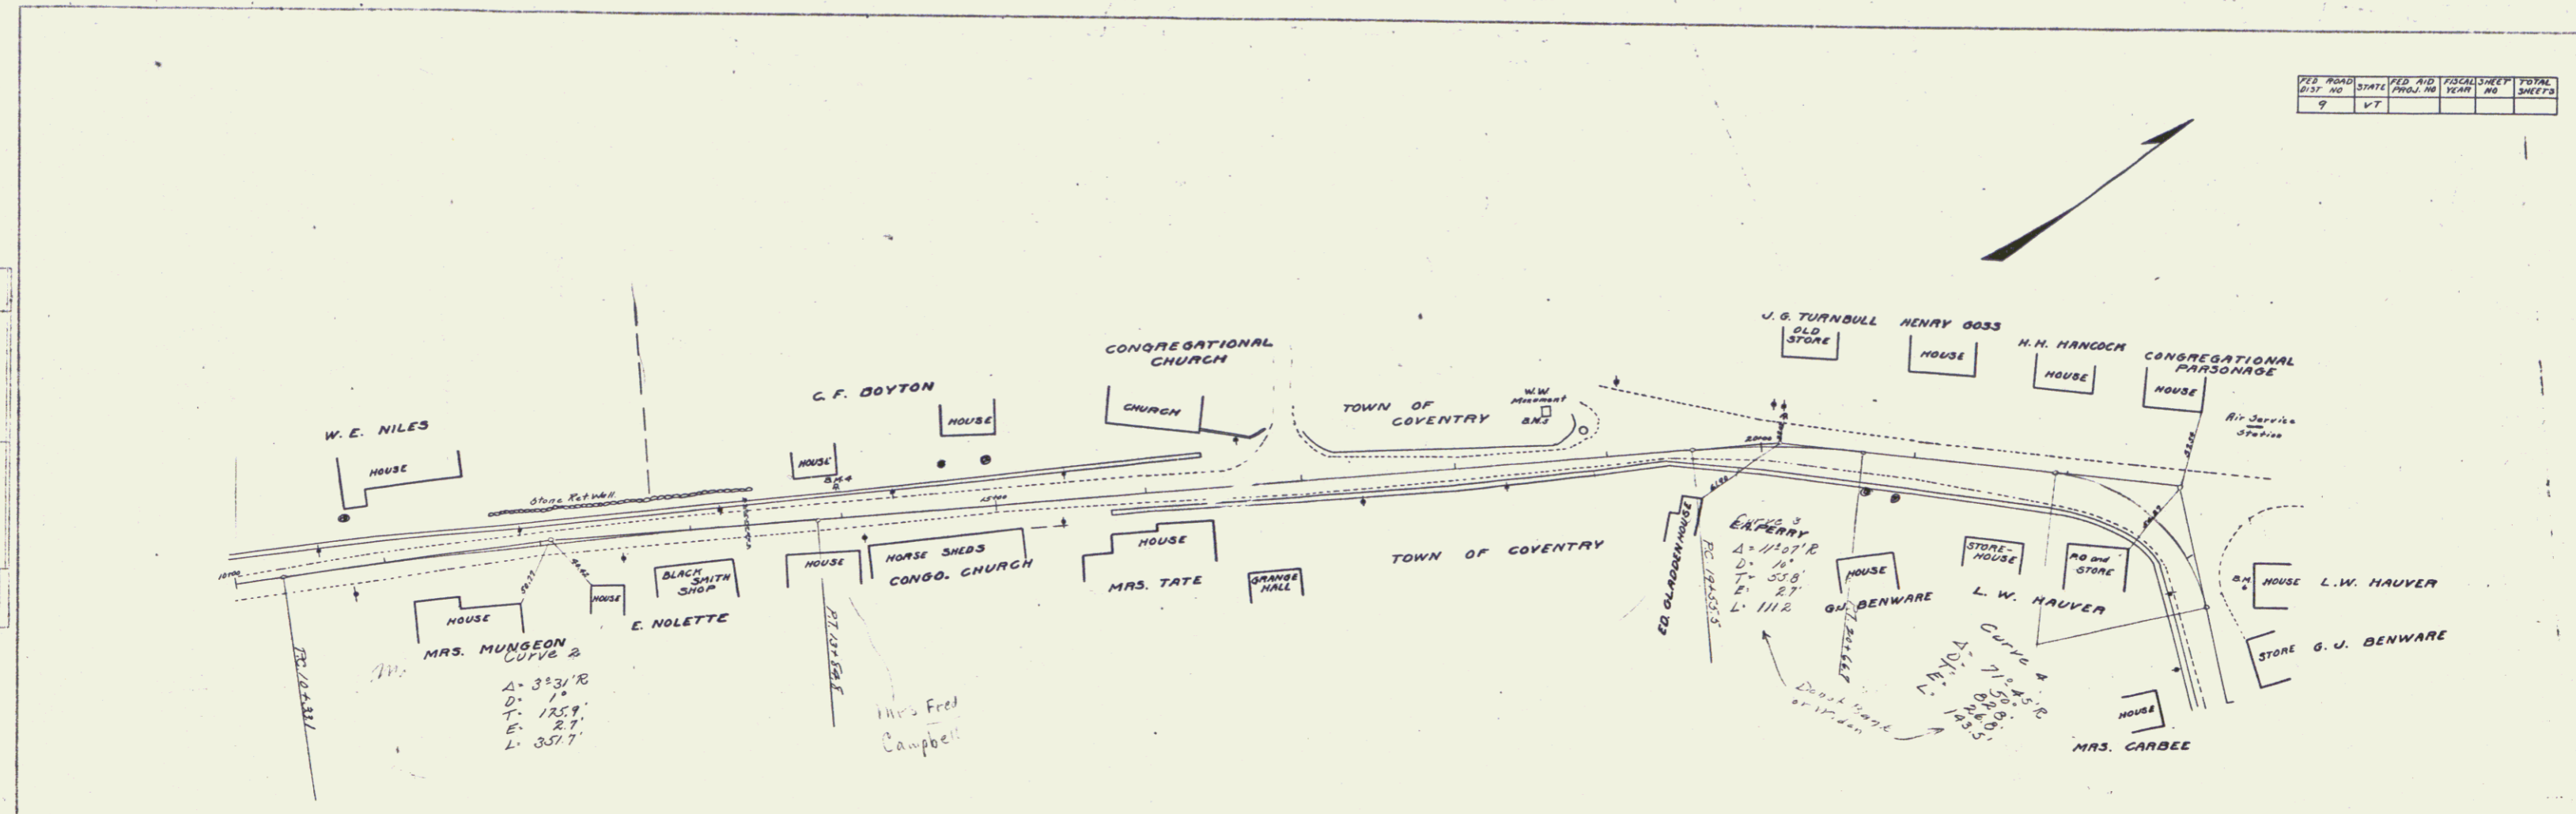

PROFILE
 W. E. NILES
 G. E. BOYTON
 C. F. BOYTON
 CONGREGATIONAL CHURCH
 TOWN OF COVENTRY
 J. G. TURNBULL
 HENRY GOSS
 H. M. MANCOCK
 CONGREGATIONAL PARSONAGE
 R. J. JONES
 STORE HOUSE
 R. J. JONES
 HOUSE
 L. W. HAUSER
 STORE G. J. BENWARE
 MRS. CARBEE
 MRS. MUNGEON
 E. NOLETTE
 BLACK SMITH SHOP
 HORSE SHEDS
 CONGO. CHURCH
 MRS. TATE
 GRANGE HALL
 ED. OLIPHANT
 RE. JONES
 HOUSE
 STORE HOUSE
 R. J. JONES
 HOUSE
 L. W. HAUSER
 STORE G. J. BENWARE
 MRS. CARBEE

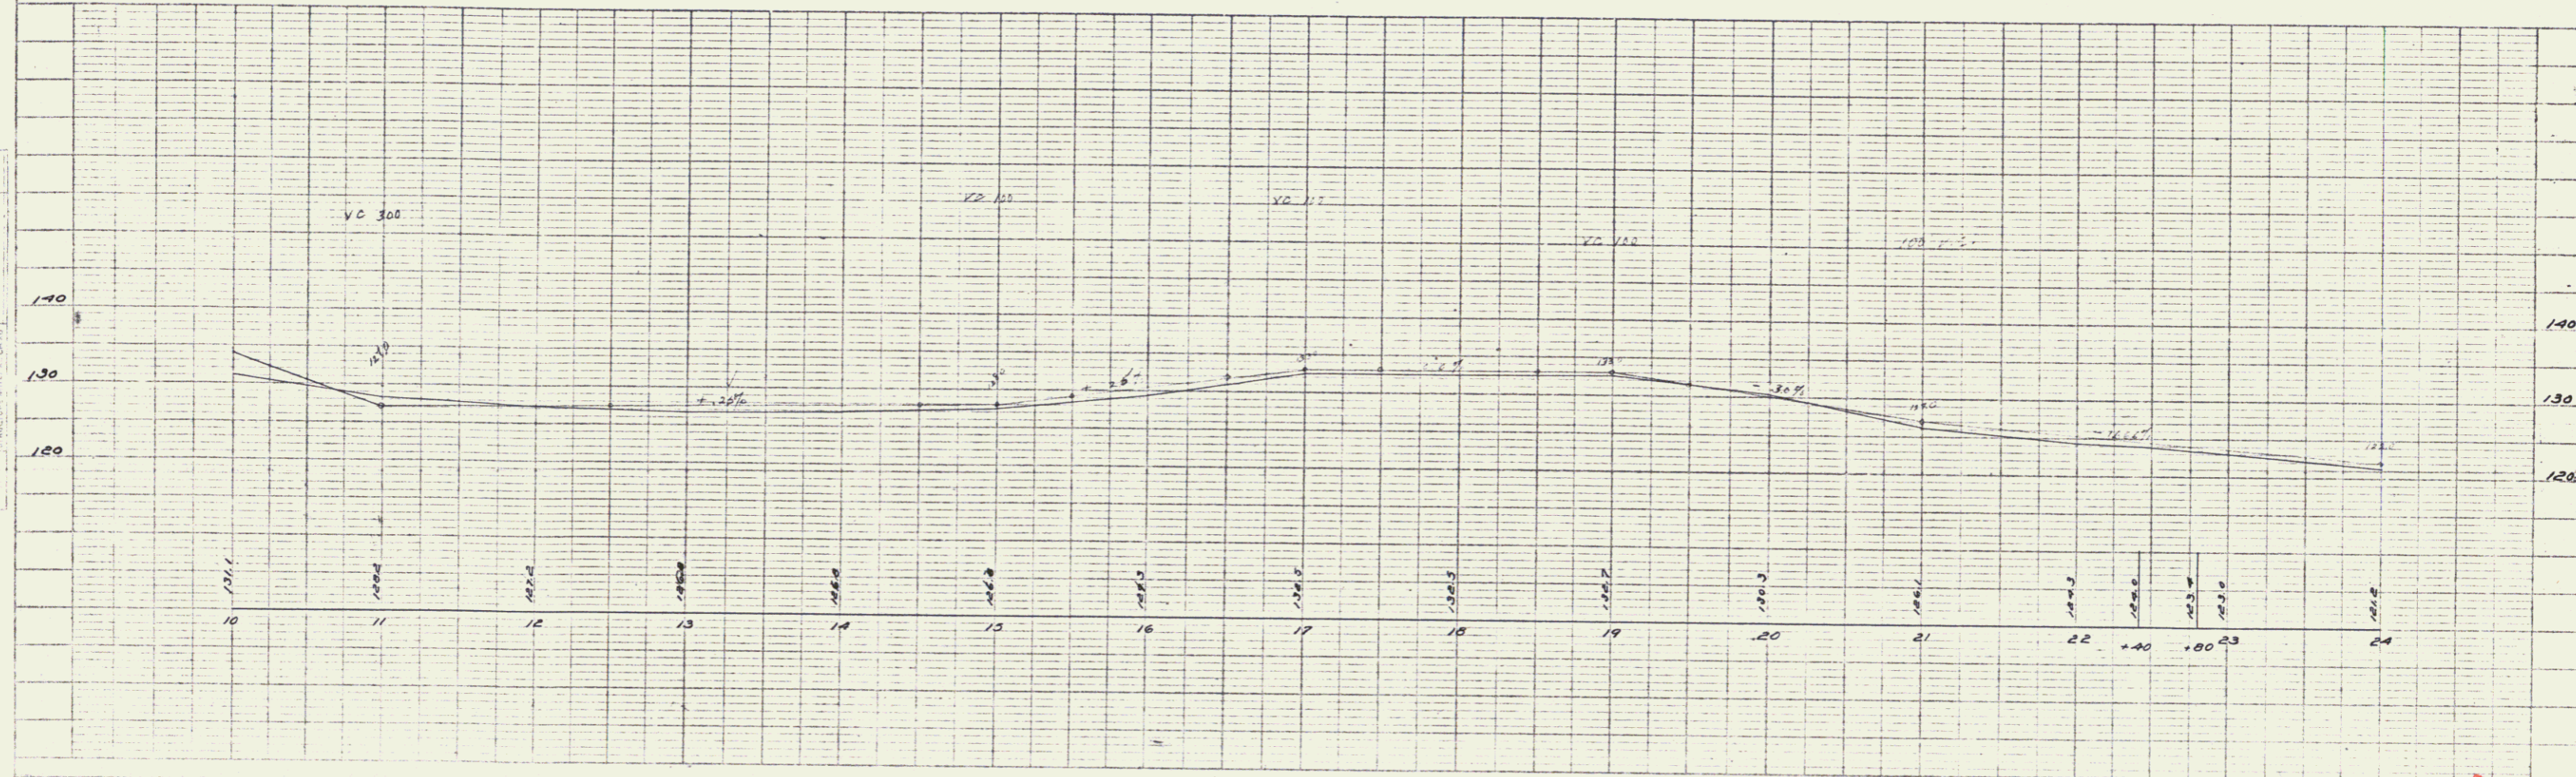


PLATE 1 - PLAN & PROFILE - W. E. NILES, G. E. BOYTON, C. F. BOYTON
 NEUTEL & ESSEX CO., NEW YORK

Coventry 14