


FILE NO.	STATE	PROJECT NO.	SHEET NO.	TOTAL SHEETS
9	VT			

PLAN  
 DATE: 10/1/54  
 DRAWN BY: G.L. FRYER  
 CHECKED BY: W.E. MORRILL  
 PROJECT NO. 1000  
 SHEET NO. 4  
 TOTAL SHEETS 10

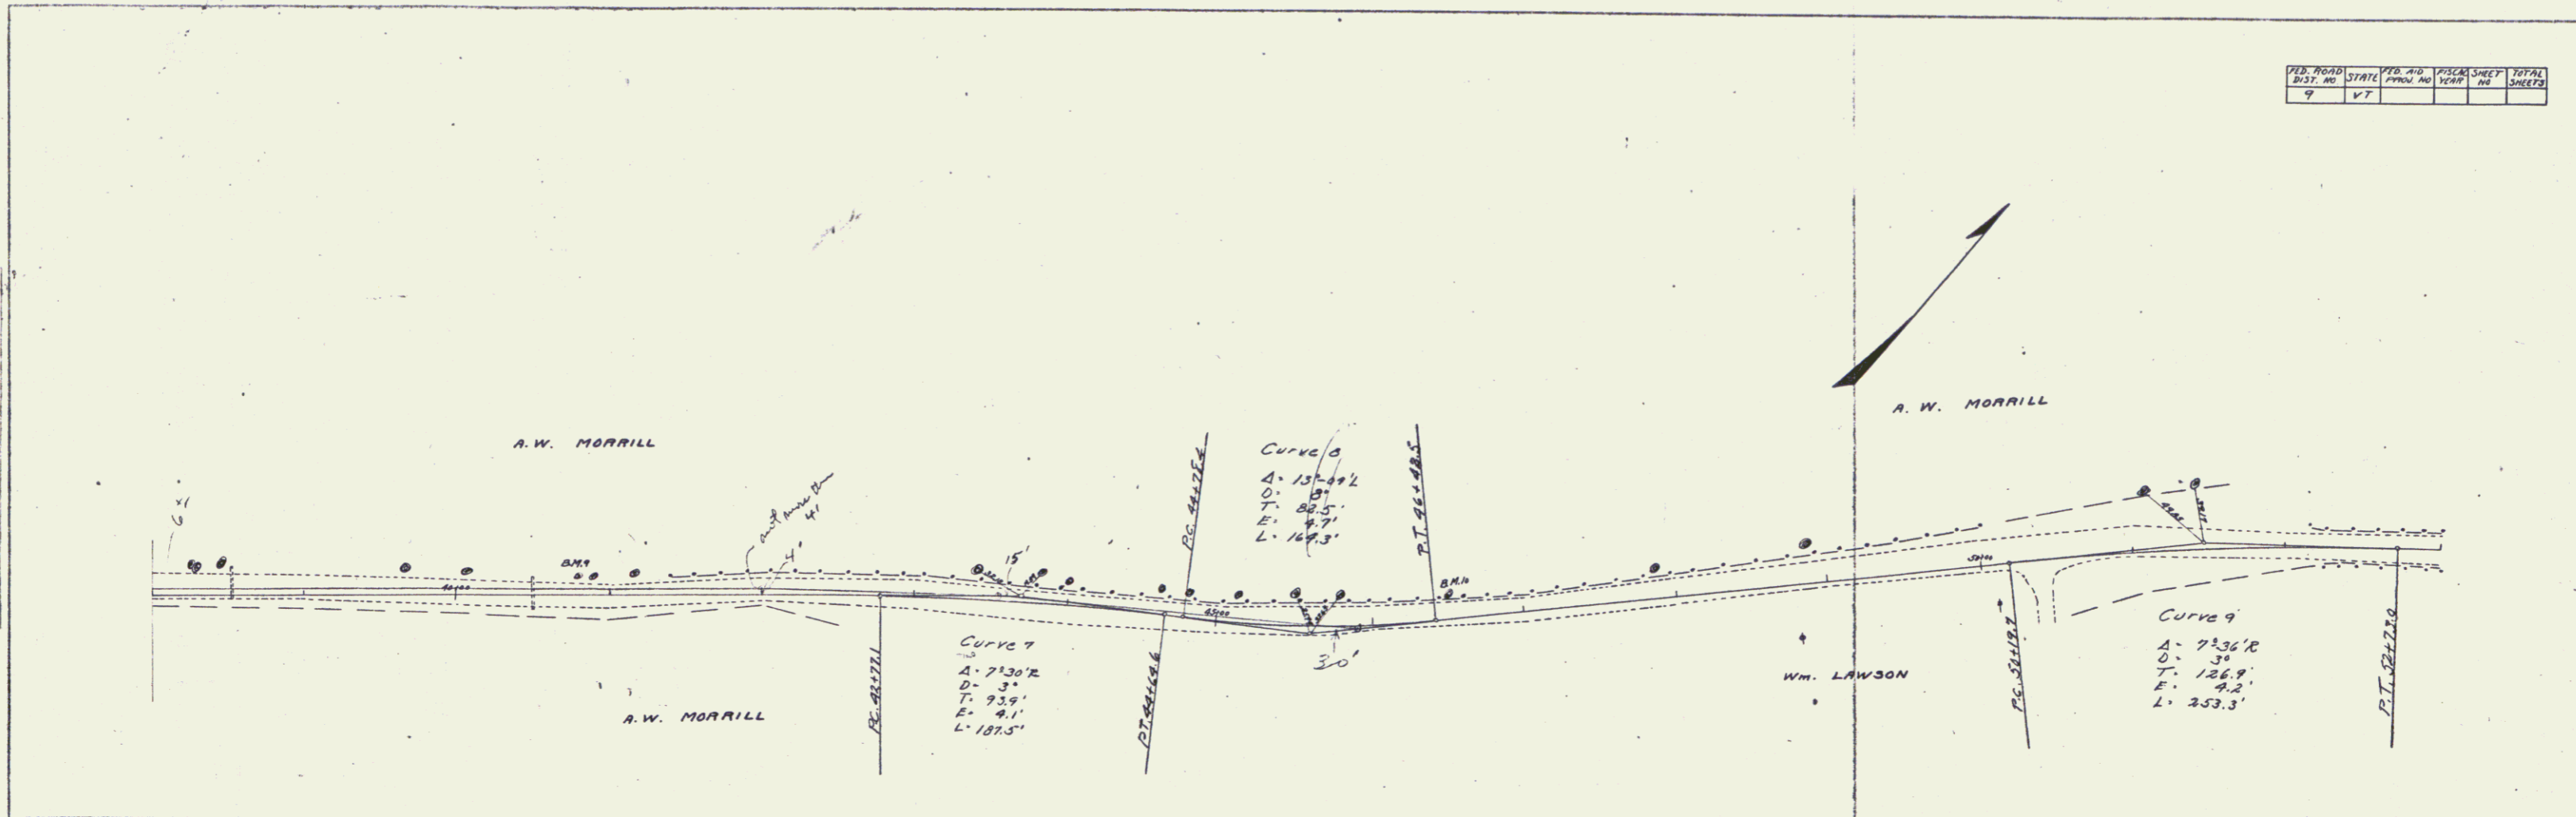

PROFILE  
 DATE: 10/1/54  
 DRAWN BY: G.L. FRYER  
 CHECKED BY: W.E. MORRILL  
 PROJECT NO. 1000  
 SHEET NO. 4  
 TOTAL SHEETS 10

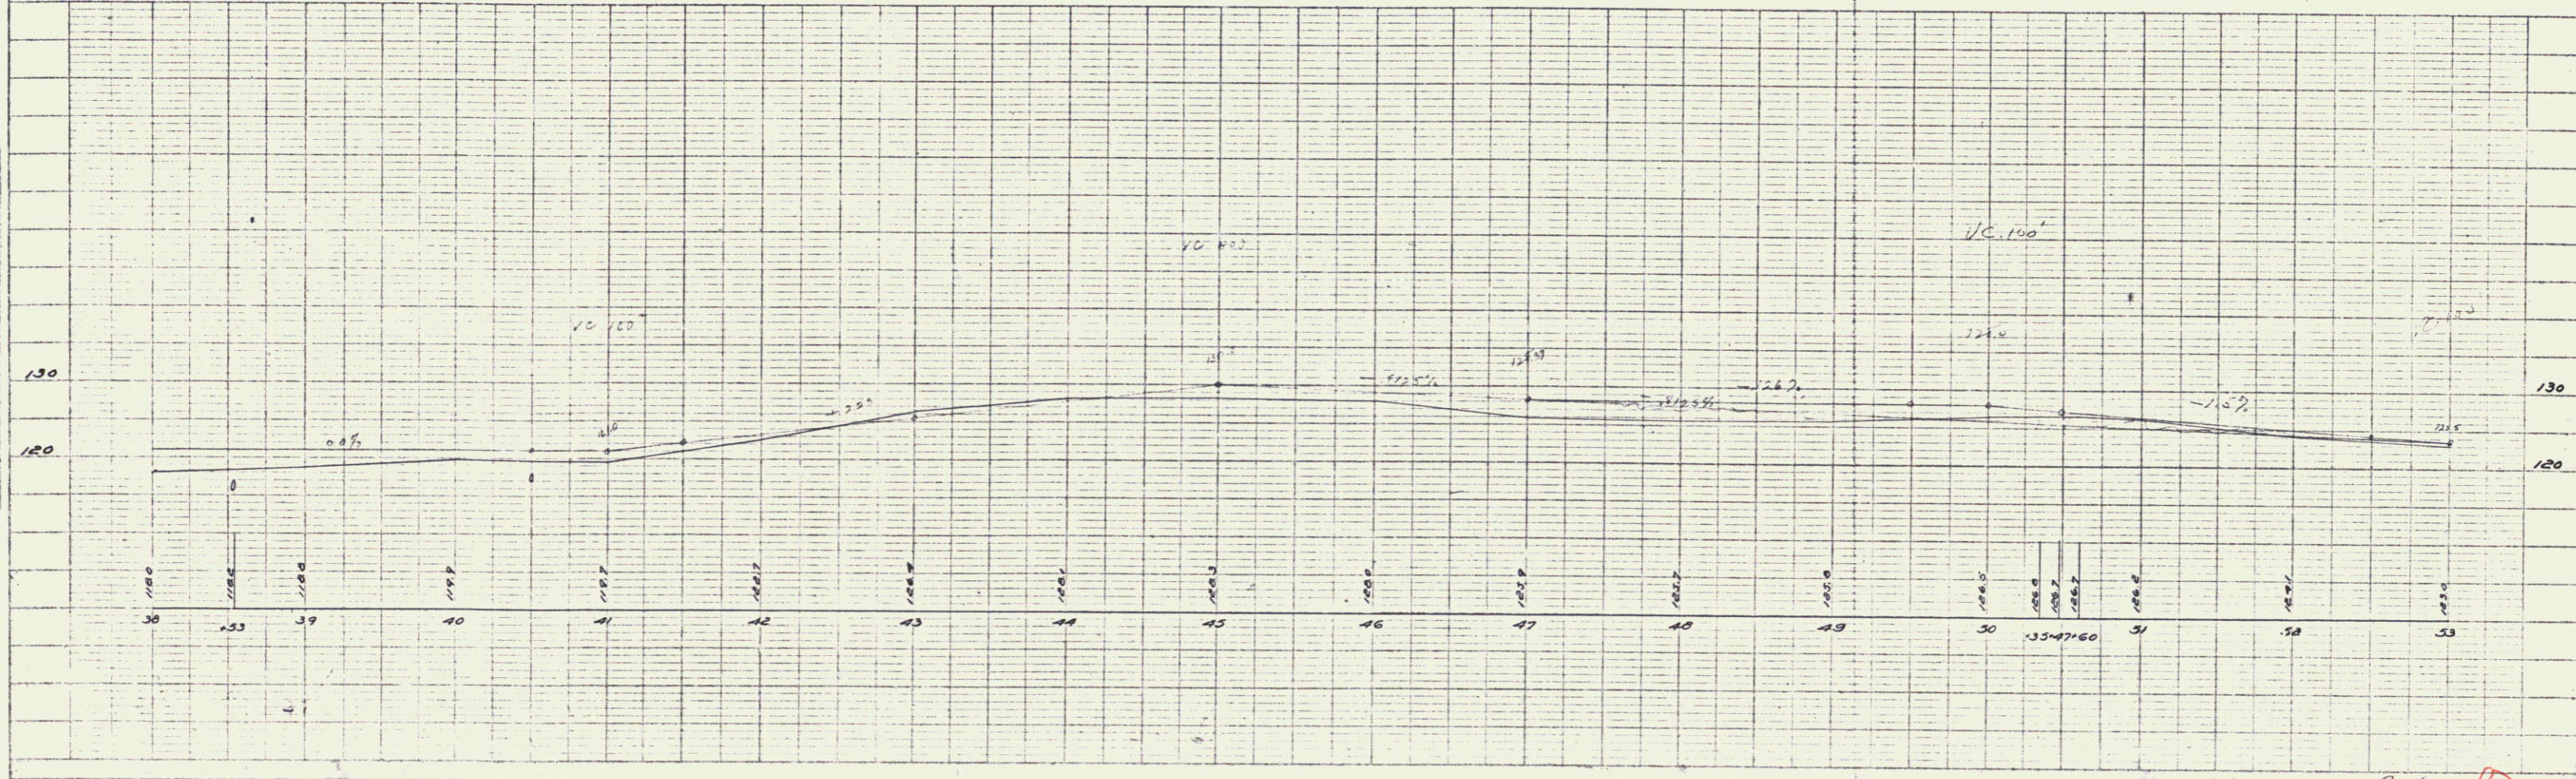


PLATE 1 - PLAN PROFILE  
 SCALE: 1" = 40' HORIZONTALLY  
 1" = 10' VERTICALLY

Corrected P.P. Sheet 4

16

5