



PER FROM	START	END AND	SHEET	TOTAL
POST. NO.	STATION	POST. NO.	NO.	SHEETS
9	VT			

PLAN
 DRAWN BY: M.E. Walker
 CHECKED BY: D.L. Shaw
 DATE: 10/20/50
 PROJECT: VT 9
 SHEET NO. 6

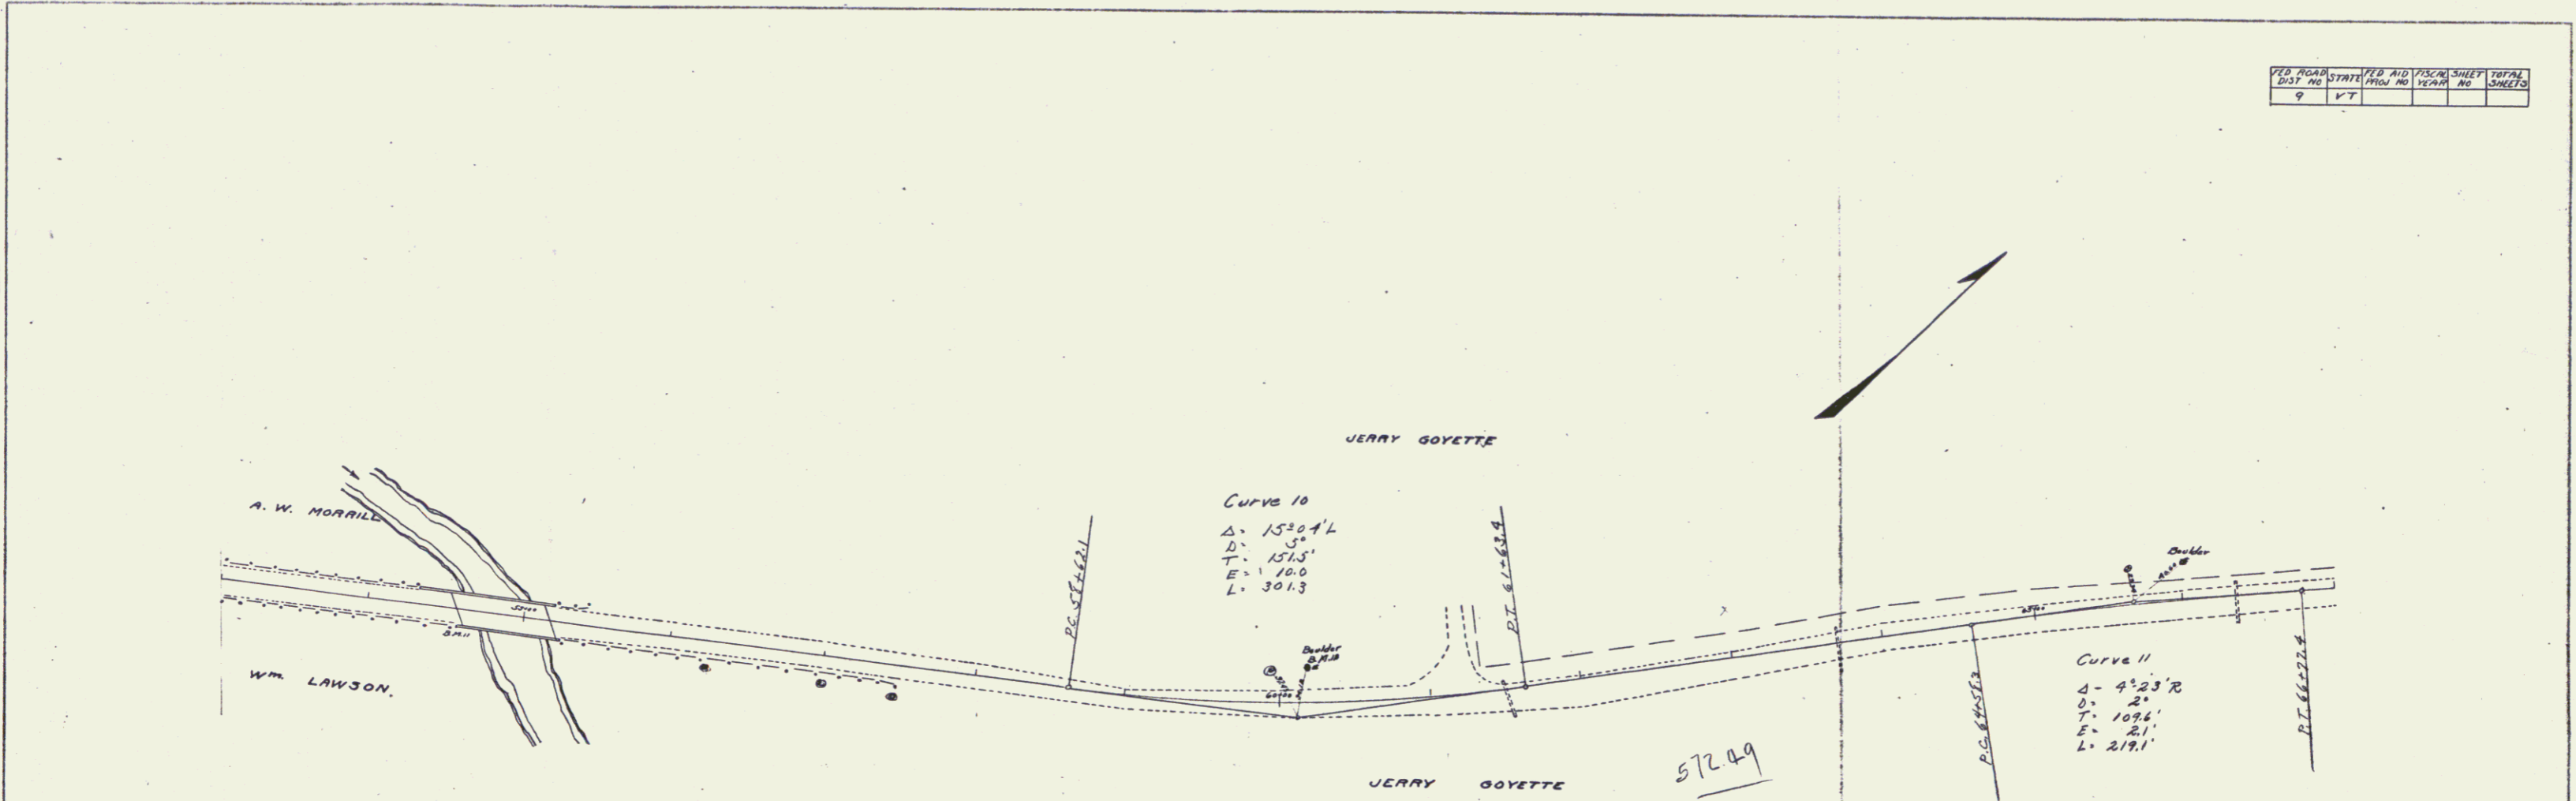

PROFILE
 DRAWN BY: M.E. Walker
 CHECKED BY: E.W. Hartung
 DATE: 10/20/50
 PROJECT: VT 9
 SHEET NO. 6

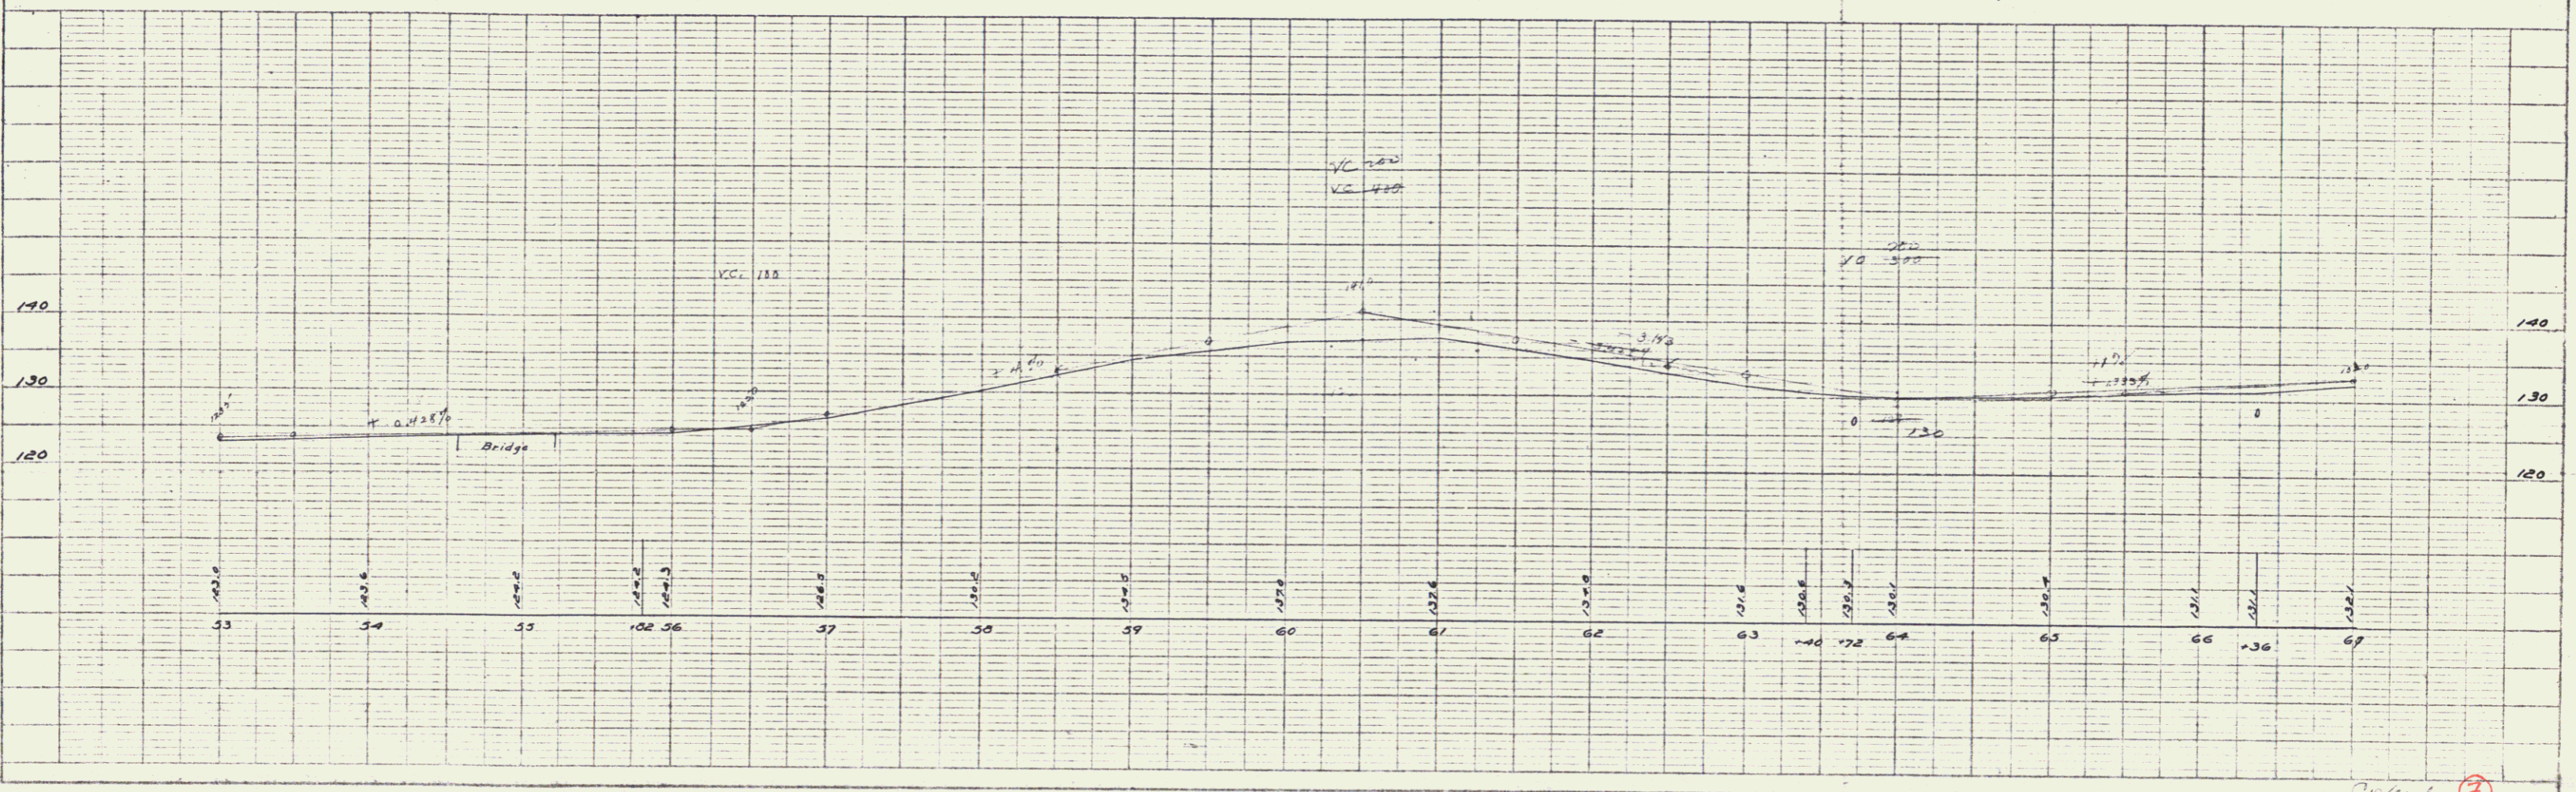

Walker