

FED. ROAD DIST. NO.	STATE	FED. AID PROJ. NO.	FISCAL YEAR	SHEET NO.	TOTAL SHEETS
9	VT				

PLAN
 DRAWN BY: M.E. Walker
 CHECKED BY: D.L. Brown
 DATE: 10/15/54
 PROJECT: 1000
 SHEET: 7

PROFILE
 DRAWN BY: M.E. Walker
 CHECKED BY: D.L. Brown
 DATE: 10/15/54
 PROJECT: 1000
 SHEET: 7

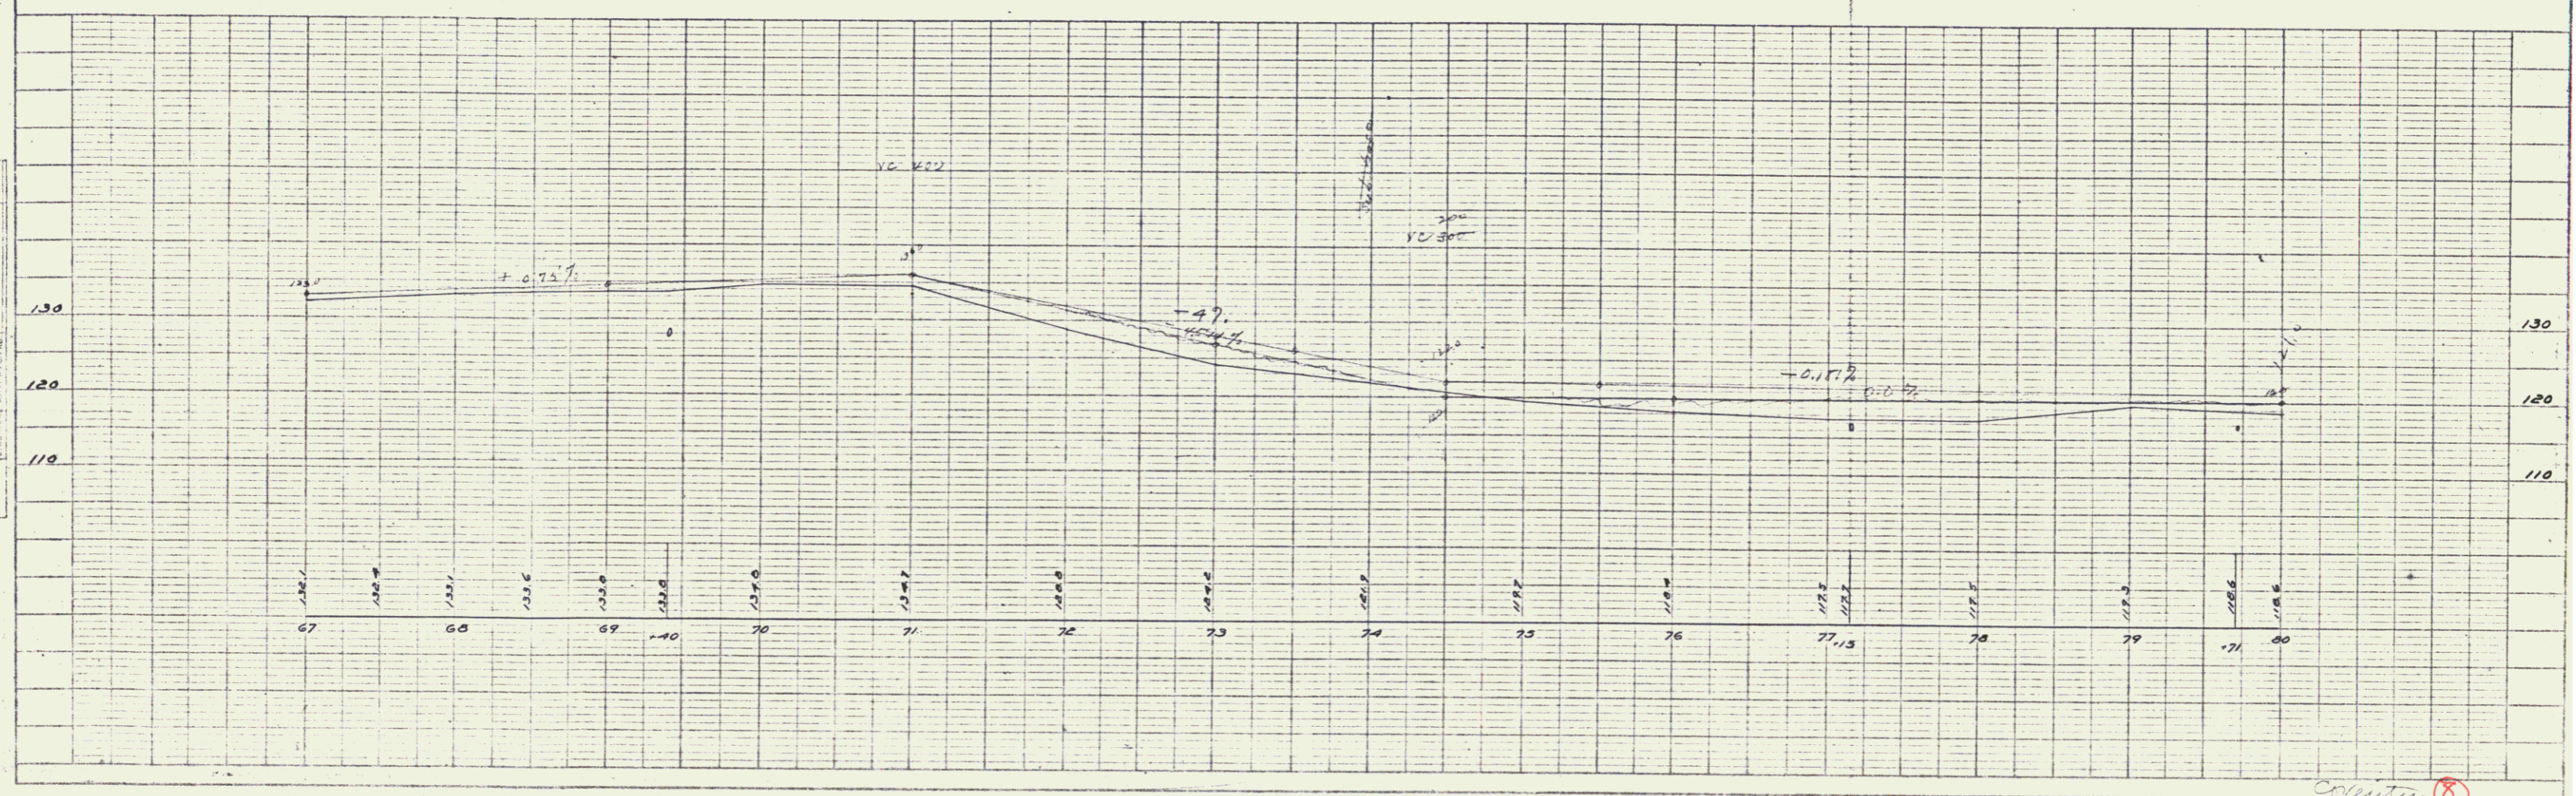
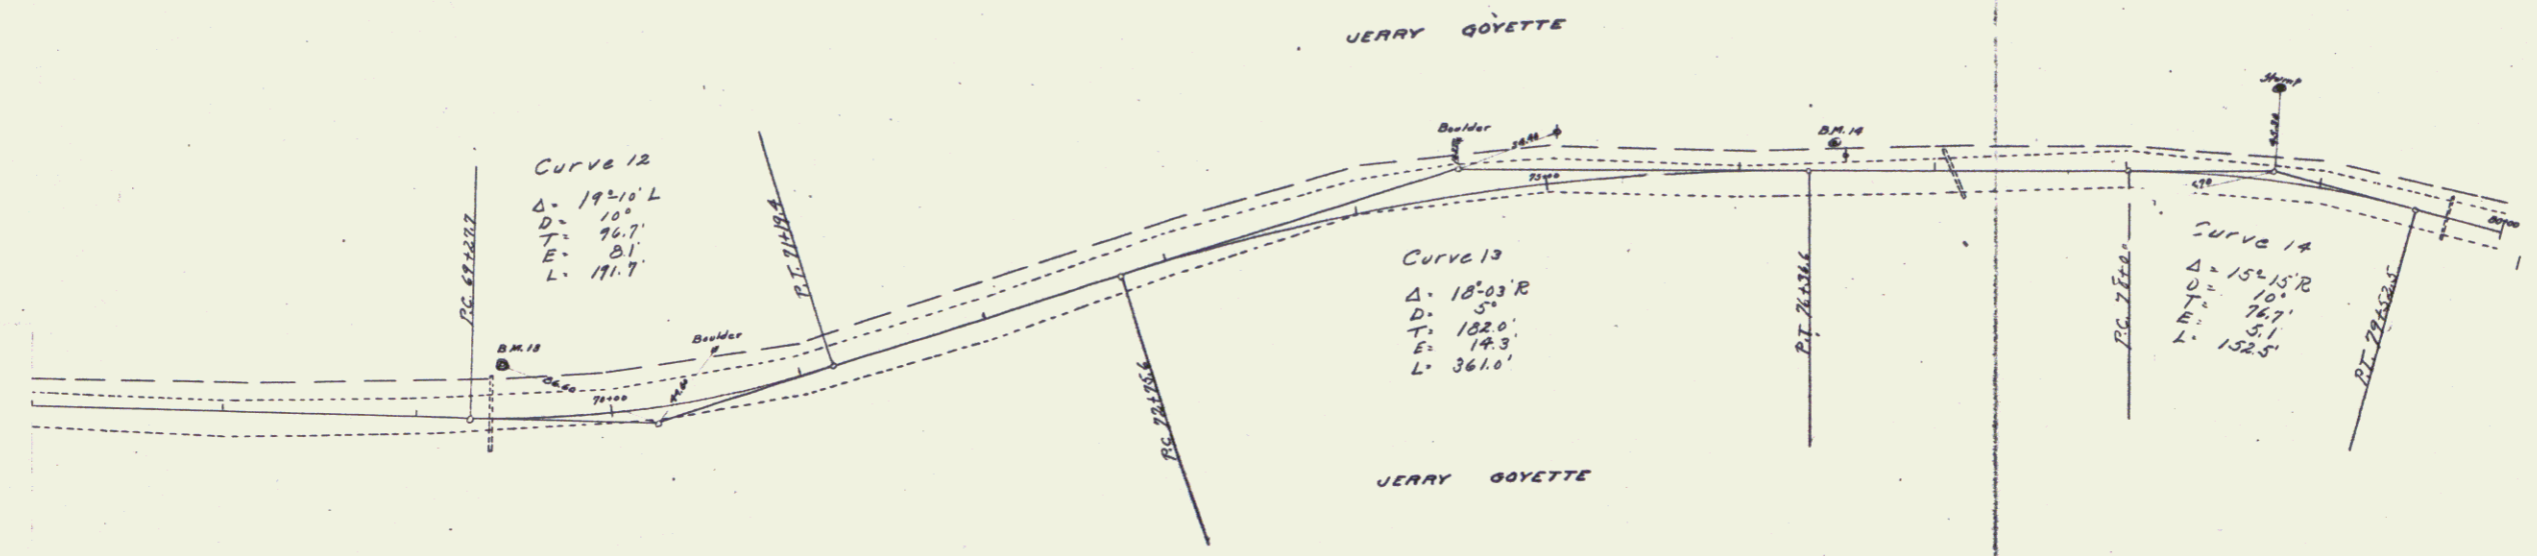


PLATE I - PLAN PROFILE
 TYPICAL & USAR 60-114-100

continuity 18

1000 J.L.V.E

7