


FED. ROAD DIST. NO.	STATE	FED. AID PROJ. NO.	SECTION	SHEET NO.	TOTAL SHEETS
9	VT				

PLAN
 DRAWN BY
 CHECKED BY
 DATE
 PROJECT NO.

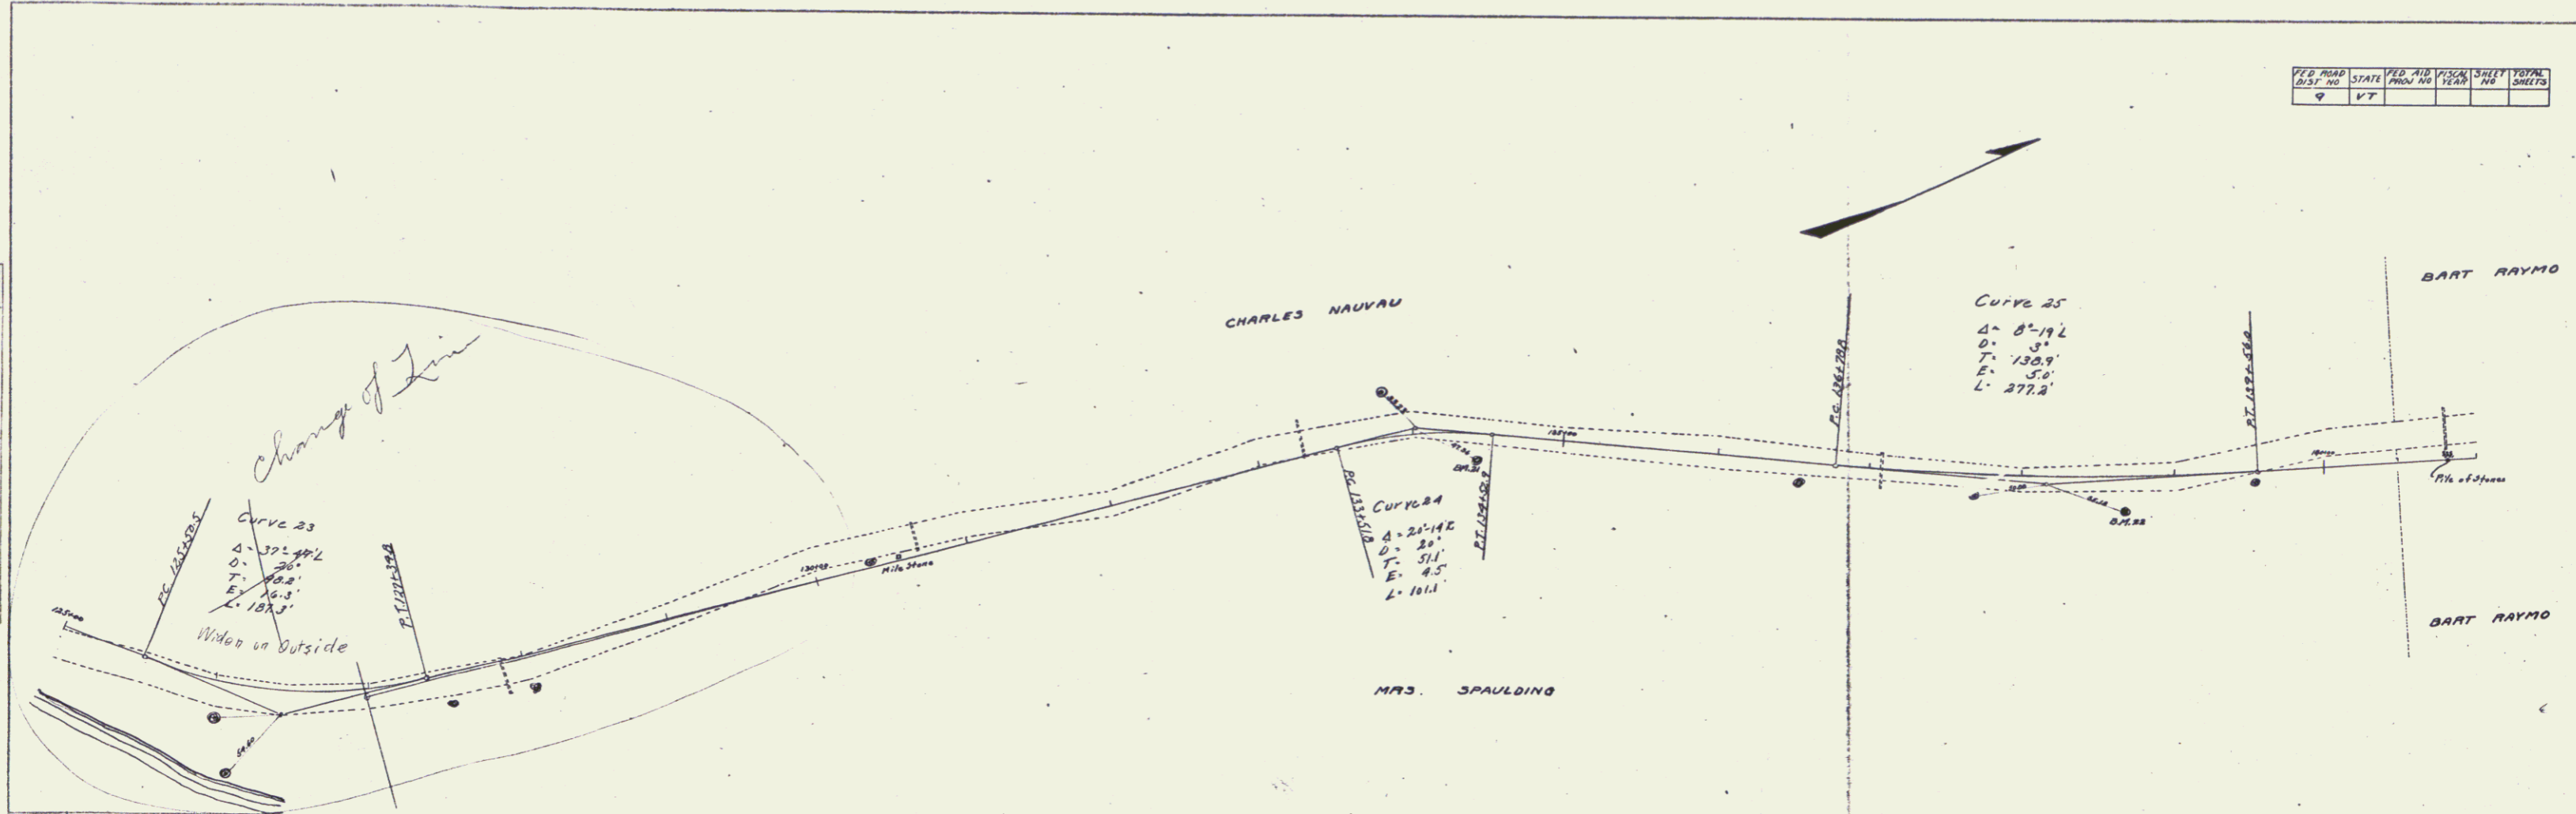

PROFILE
 DRAWN BY
 CHECKED BY
 DATE
 PROJECT NO.

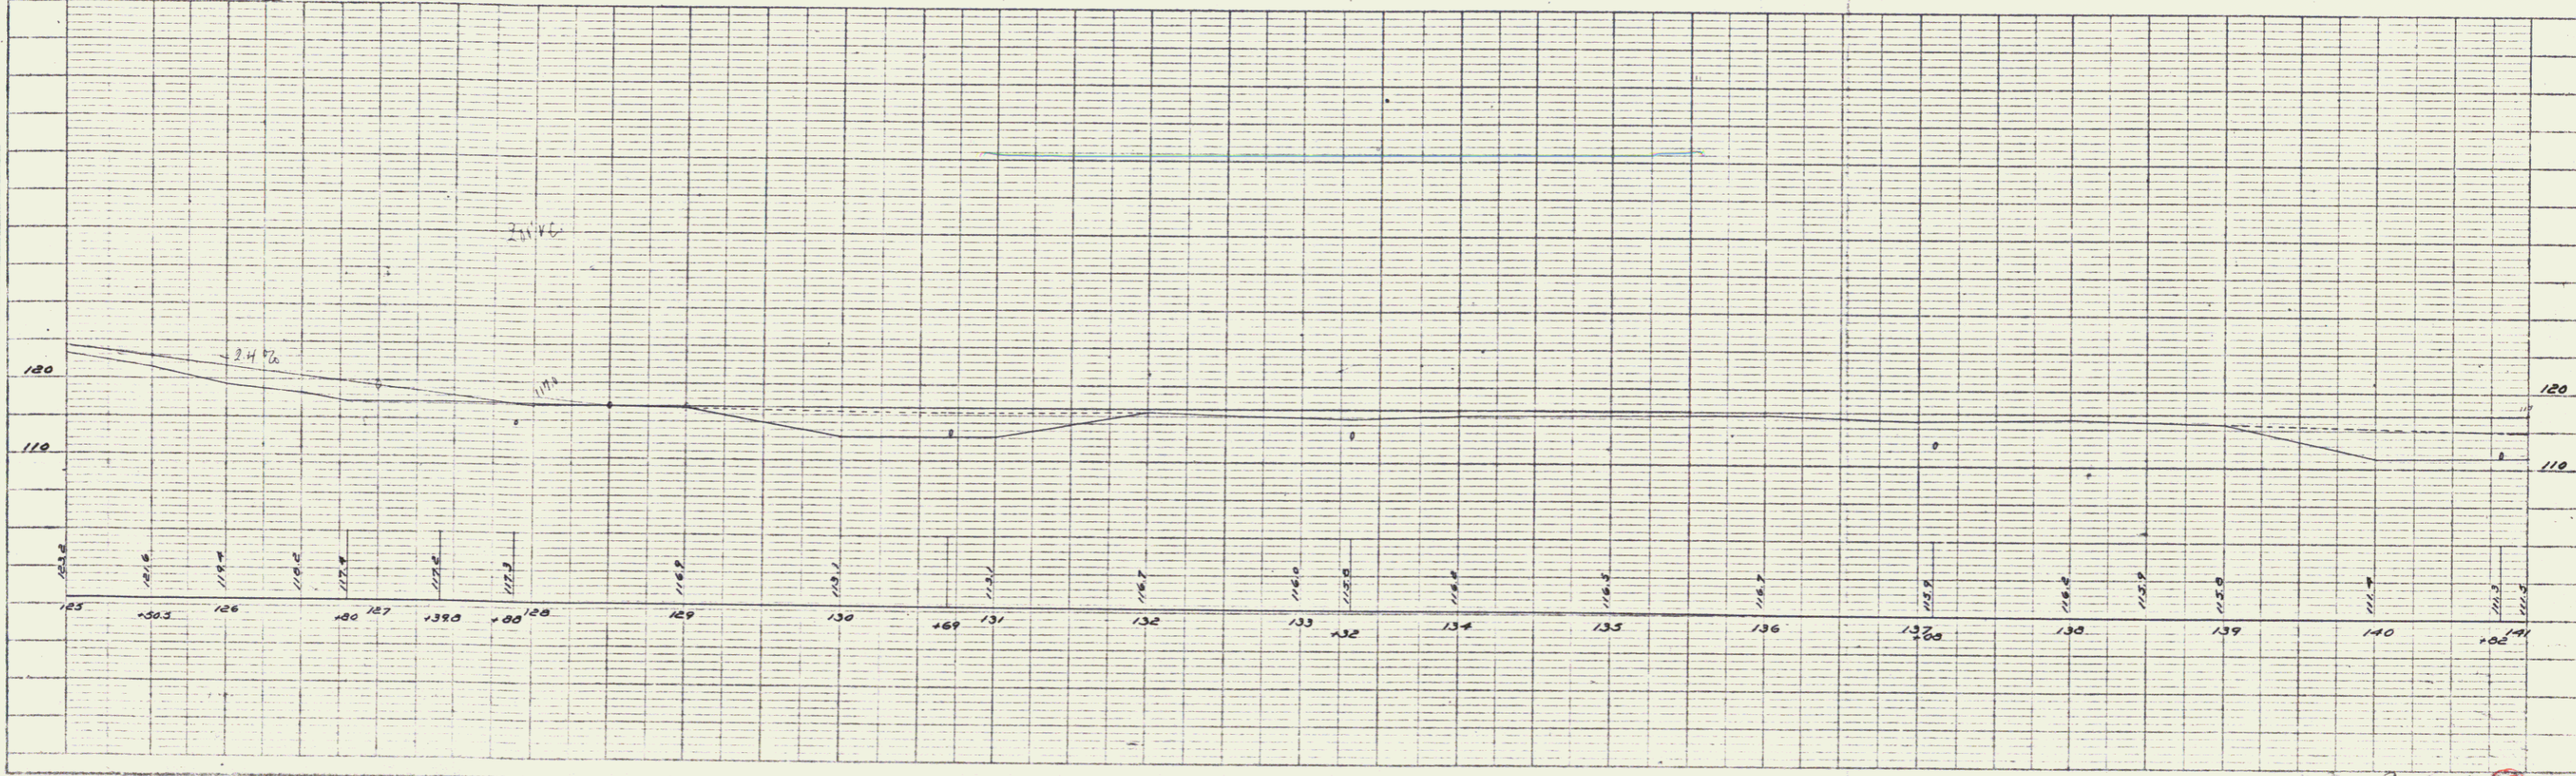


PLATE 2 - PLAN PROFILE 6" x 1" A.S. STANDARD
 8 1/2" x 11" E.L. NEW YORK

County 10
 County 100 sheet 10