

**INDEX OF SHEETS**


1.	Title Sheet	
2.	Typical Sheet, Mainline	
3.	Typical & Profile Sheet, Sideline	
4.	Summary of Quantities	
5.	Item Detail & Drainage Sheet	
6.	Earthwork & Grade Sheet	
7-8.	Blank	
9-11.	R.O.W. Plan Sheets	
12-14.	Plan Sheets	
15.	Profile Sheet	
16.	8-1 Easing Tables	12/ 8/71
17.	8-5 Slope Rounding	12/ 8/71
18.	8-2 Roadways & Underdrain	3/ 8/72 R
19.	8-6 R.C.D.I. (Use in Ditches)	4/ 4/73
20.	8-8 R.C.D.I. - W/Grate (Std. Sec.)	12/ 8/71
21.	8-10 Top for a Drop Inlet with Bituminous Concrete Curb	12/ 6/71
22.	9-11 Cast Iron Grate, Type A	4/25/72 e
23.	9-18 Cast Iron Grate, Type B	11/14/72 e
24.	E-2 Const. Approach Signs	10/19/73 R
25.	E-5 Bolterment Project Signs	9/11/73 R
26.	E-6 W-Project Const. Signs	12/14/73 R
27.	E-7 Delimitors & Barricades for Const. Areas	9/19/73 R
28-29.	Blanks	
30-33.	Cross Sections, Mainline	
34-37.	Cross Sections, Sideline	

**DERBY**  
**BP 041-5-7310**  
**RECORD PLANS**  
**MATERIALS**  
 SUB BASE OF GRAVEL - DAGGETT PIT, DERBY LINE, VT.  
 CULVERTS - LANE METAL PRODUCTS CO., INC., BALLSTON SPA, N.Y.  
 EASTERN CULVERT CO., LEOMINSTER, MASS. (SMOOTH-LINED)  
 CAST IRON GRATES - E. L. LEBRON FOUNDRY CO., BROOKTON, MASS.  
 CONCRETE, CLASS B - CALKINS RED-MIX, COVENTRY, VT.  
 BITUMINOUS CONCRETE PAVEMENT 9 BIT. CONC. CURB - L.M. PIKE, COVENTRY, VT.  
 FERTILIZER & SEEDS: GRISWOLD FENCE CO., ESSEX JCT., VT.  
 PROJECT BEGUN: DECEMBER, 1973  
 PROJECT COMPLETED: MAY, 1976  
 CONTRACTOR: STATE OF VERMONT, DISTRICT 9  
 RECORD PLANS - P.F. WU, MARCH, 1976

**STATE OF VERMONT**  
**DEPARTMENT OF HIGHWAYS**



**PROPOSED IMPROVEMENT**  
 BETTERMENT PROJECT  
**TOWN OF DERBY**  
**COUNTY OF ORLEANS**  
 NEWPORT-DERBY LINE ROAD

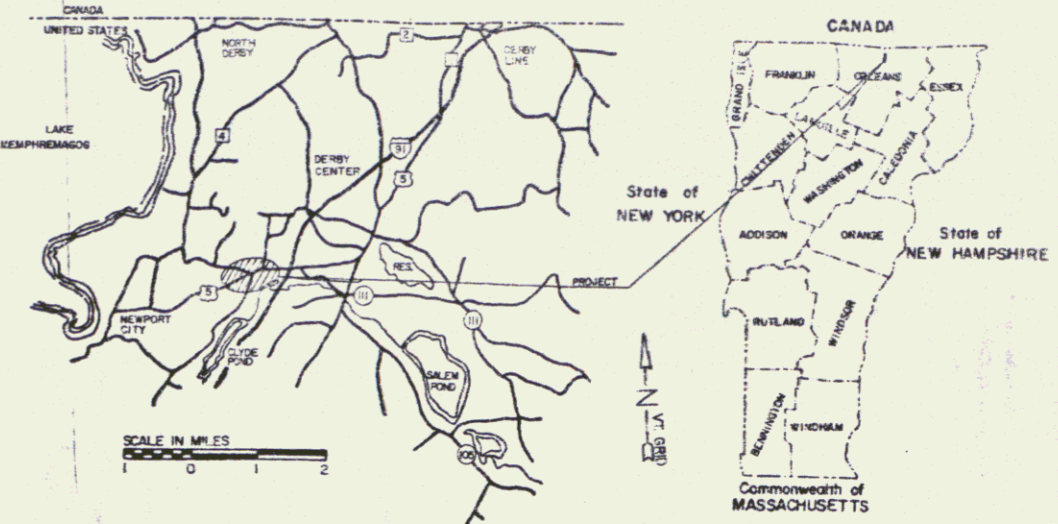


BEGINNING AT A POINT APPROXIMATELY 1277 FEET EASTERLY OF THE NEWPORT-DERBY TOWN LINE AND EXTENDING IN AN EASTERLY DIRECTION 0.543 MILES.

LENGTH OF ROADWAY 2868.5 FEET 0.543 MILES  
 LENGTH OF PROJECT 2868.5 FEET 0.543 MILES

1973-ADT (EST) 6090  
 1973-DHV (EST) 850  
 1993-ADT(EST) 9835  
 1993-DHV(EST) 995  
 V = 50 M.P.H.

*Route: US 5*  
*Pin # 99R290*

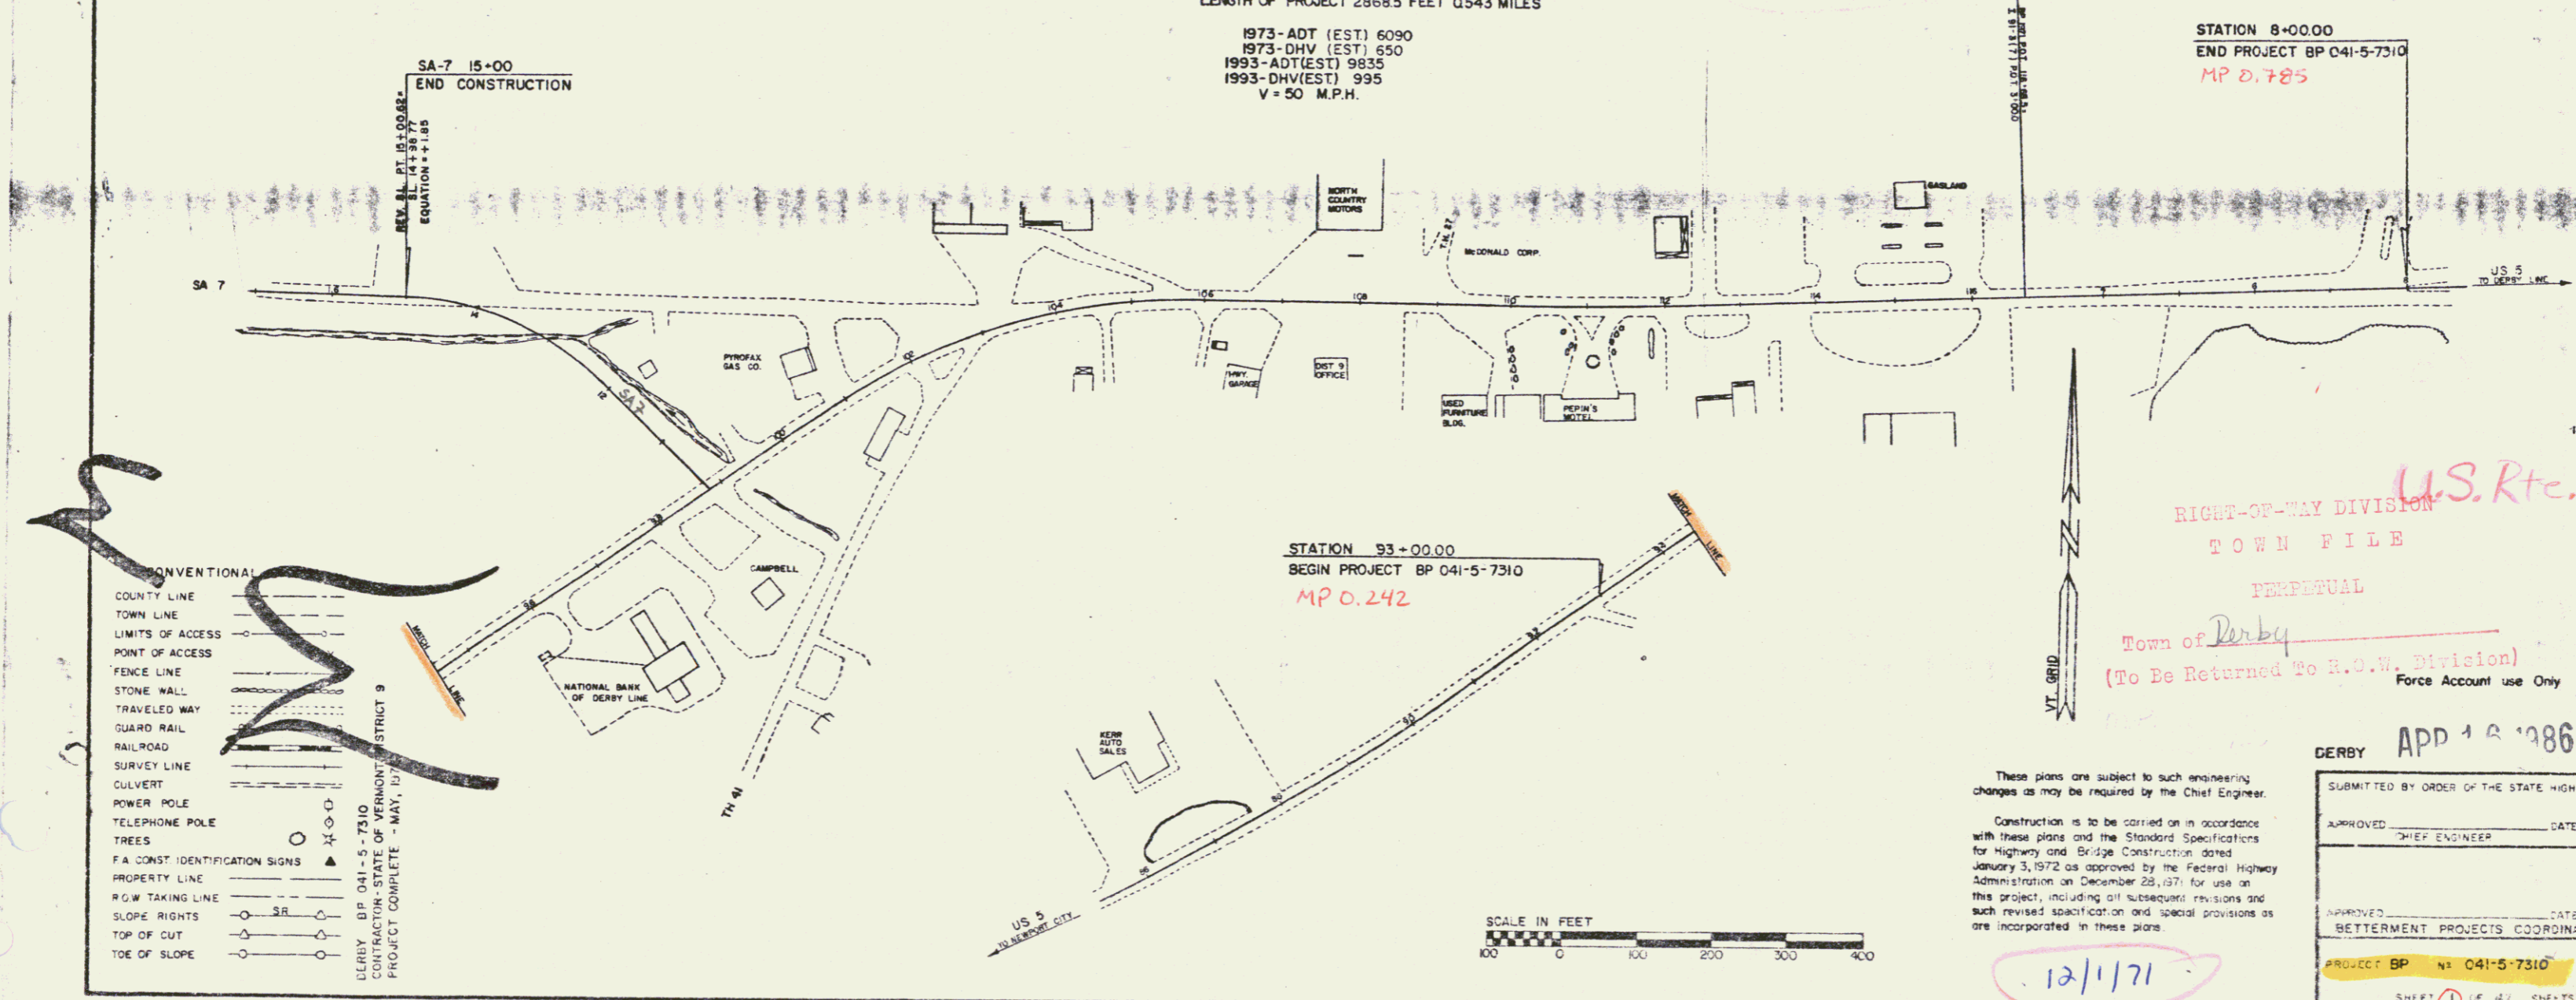

**CONVENTIONAL**

---	COUNTY LINE
---	TOWN LINE
---	LIMITS OF ACCESS
---	POINT OF ACCESS
---	FENCE LINE
---	STONE WALL
---	TRAVELED WAY
---	GUARD RAIL
---	RAILROAD
---	SURVEY LINE
---	CULVERT
---	POWER POLE
---	TELEPHONE POLE
---	TREES
---	F.A. CONST. IDENTIFICATION SIGNS
---	PROPERTY LINE
---	R.O.W. TAKING LINE
---	SLOPE RIGHTS
---	TOP OF CUT
---	TOE OF SLOPE

DERBY, BP 041-5-7310  
 CONTRACTING-STATE OF VERMONT  
 PROJECT COMPLETE - MAY, 1976

*U.S. Rte. 5*  
 RIGHT-OF-WAY DIVISION  
 TOWN FILE  
 PERPETUAL  
 Town of *Derby*  
 (To Be Returned To R.O.W. Division)  
 Force Account use Only

These plans are subject to such engineering changes as may be required by the Chief Engineer.  
 Construction is to be carried on in accordance with these plans and the Standard Specifications for Highway and Bridge Construction dated January 3, 1972 as approved by the Federal Highway Administration on December 28, 1971 for use on this project, including all subsequent revisions and such revised specifications and special provisions as are incorporated in these plans.

DERBY **APP 18 1986**

SUBMITTED BY ORDER OF THE STATE HIGHWAY BOARD

APPROVED \_\_\_\_\_ DATE \_\_\_\_\_  
 CHIEF ENGINEER

APPROVED \_\_\_\_\_ DATE \_\_\_\_\_  
 BETTERMENT PROJECTS COORDINATOR

PROJECT BP **041-5-7310**

SHEET **1** OF **4** SHEETS

DATE 12/17/70

*12/1/71*