

WOOD GUARD RAIL REQUIRED  
 STA. 48163 TO 48187  
 LENGTH 24 FT.

LEFT  
 STA. 48163 TO 48187  
 LENGTH 23 FT.


TOTAL THIS SHEET  
 47  
 109 FT.

NEW CULVERTS REQUIRED  
 STA. 48175  
 15" RINK CONCRETE ON CAST IRON PIPE LENGTH 32 FT.  
 CLASS B (1-2 1/2") CONCRETE 2 PCX.  
 REINFORCING STEEL 33 LB.

FED. ROAD DIST. NO.	DATE	FED. AID PROJ. NO.	FISCAL YEAR	SHEET NO.	TOTAL SHEETS
0	VT	96A	1987	6	103

PLAN  
 DATE: 10/26/86  
 DRAWN BY: J.A.D.  
 CHECKED BY: J.A.D.  
 SCALE: AS SHOWN

PROFILE  
 DATE: 10/26/86  
 DRAWN BY: J.A.D.  
 CHECKED BY: J.A.D.  
 SCALE: AS SHOWN

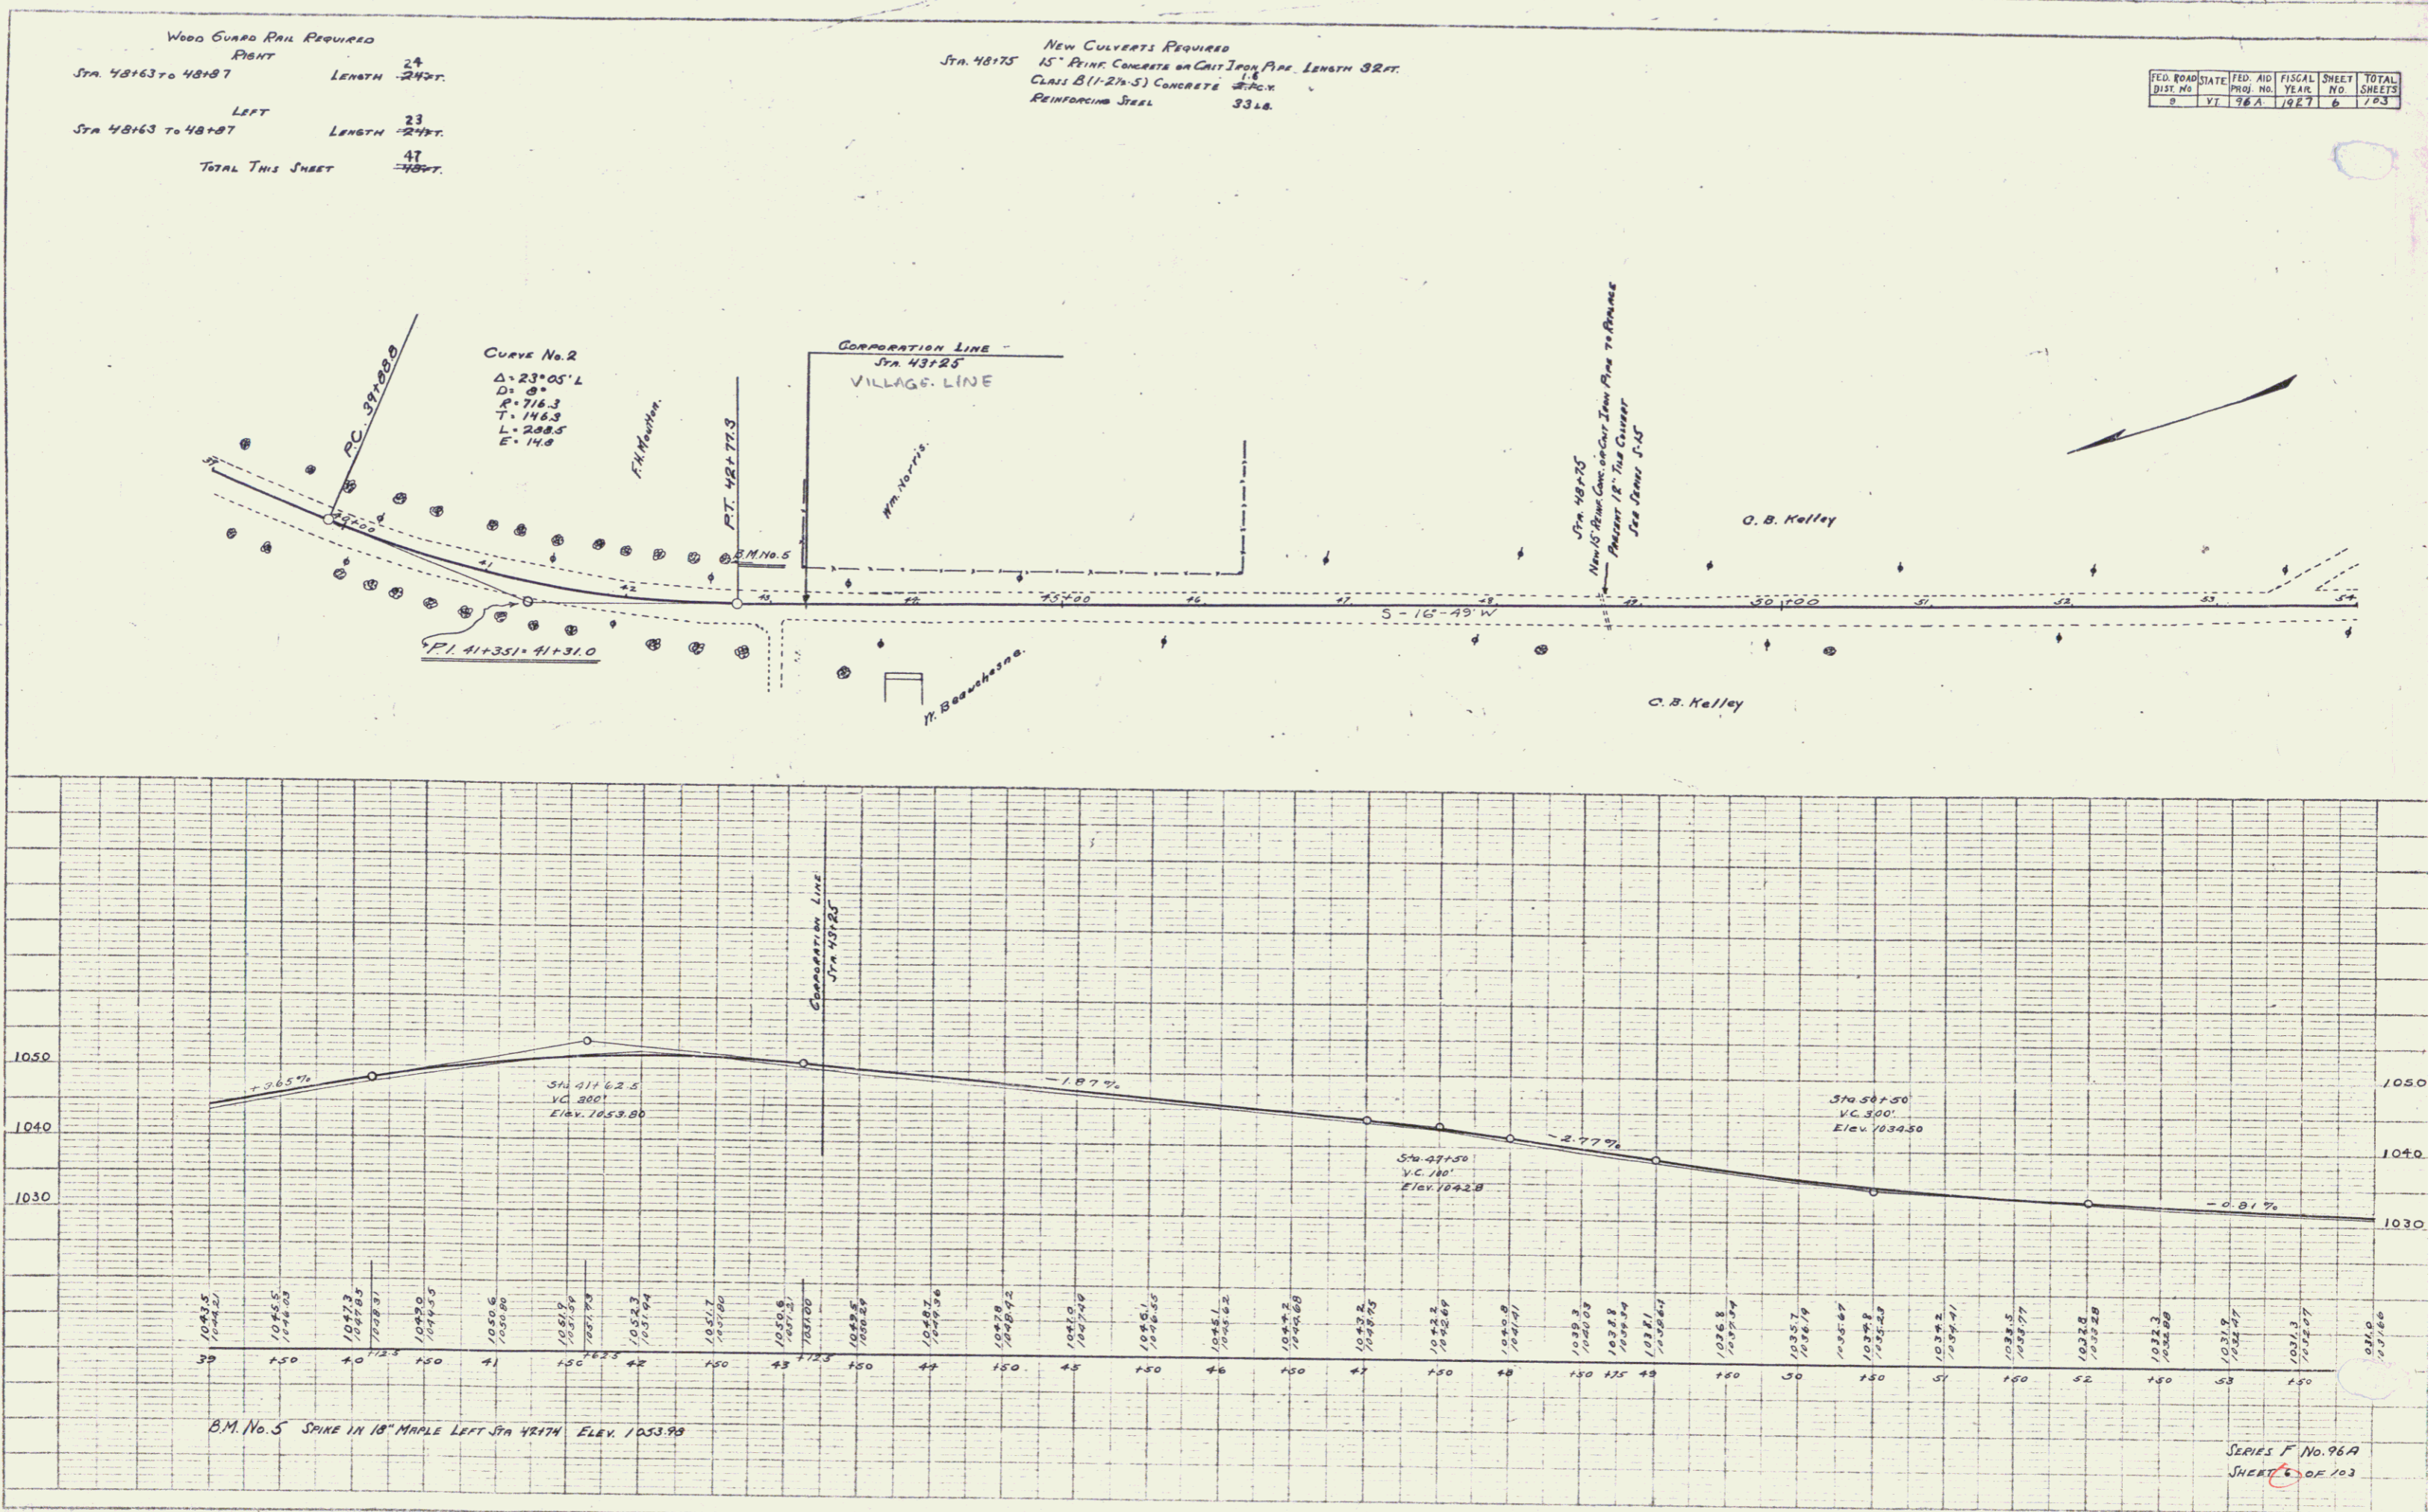

SERIES F No. 96A  
 SHEET 6 OF 103

5